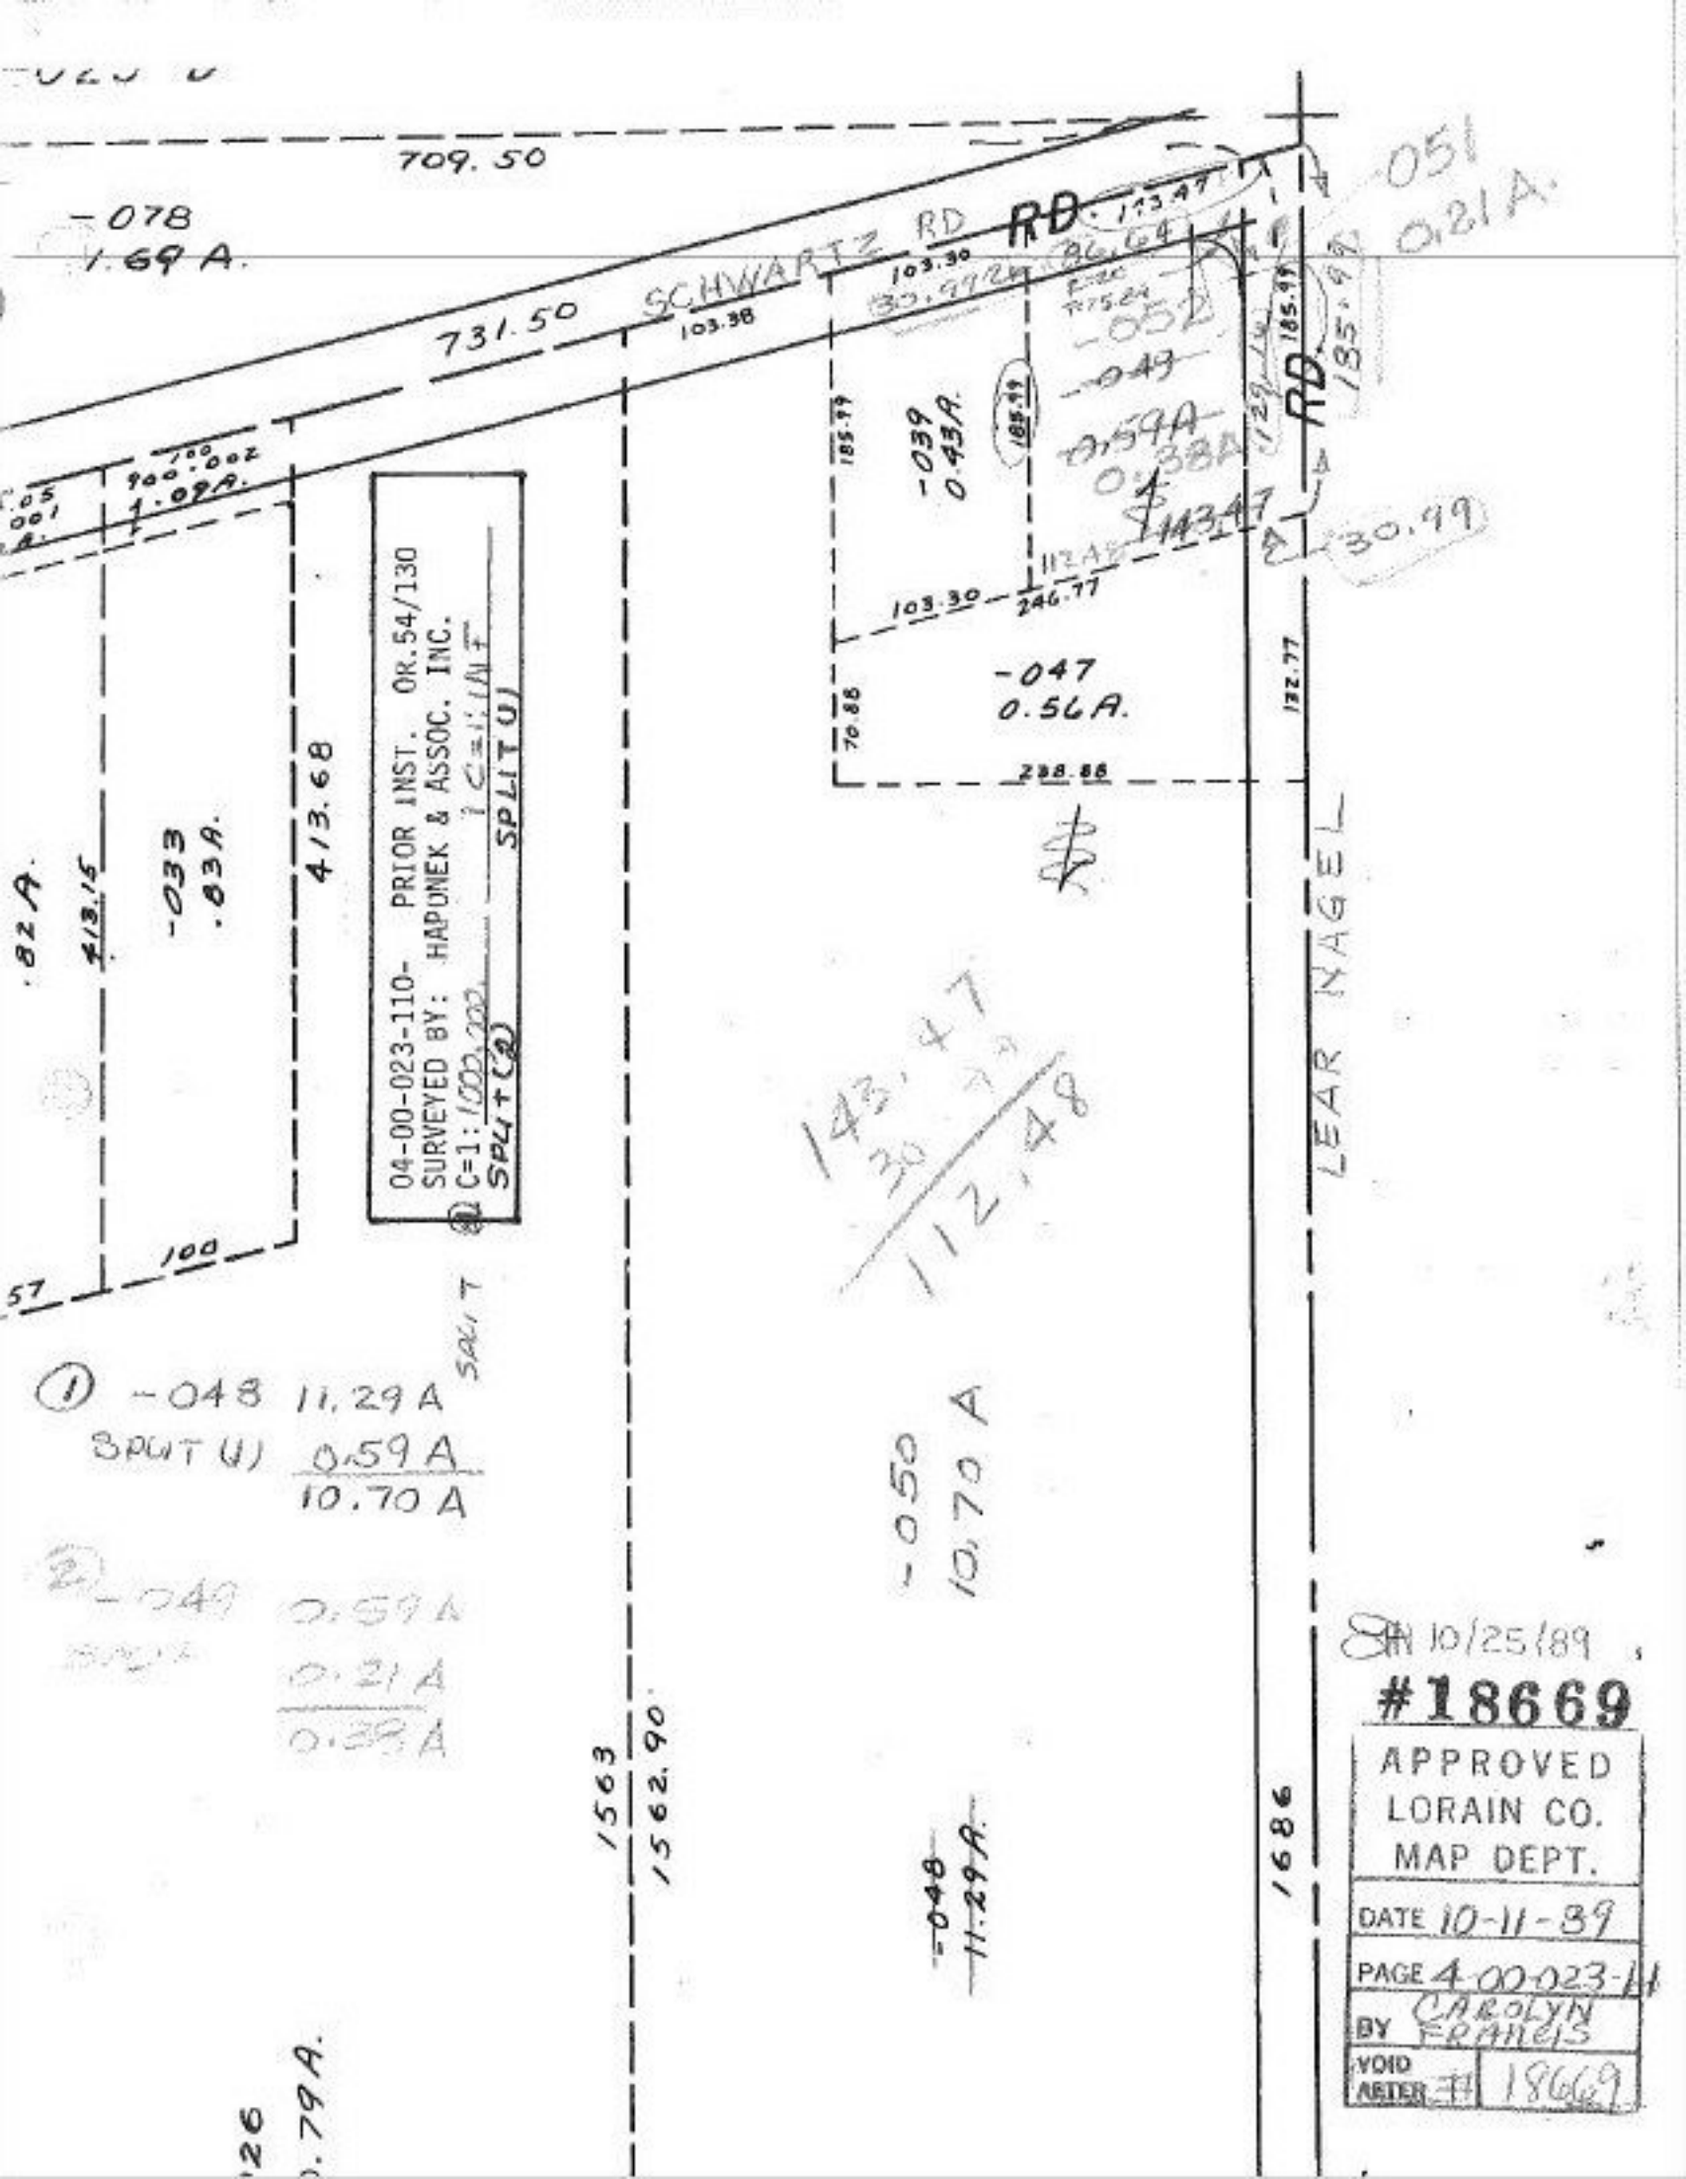
709.50
-078
1.69 A.
731.50
SCHWARTZ RD
RD
103.38
103.30
30.97
86.64
-052
-049
0.59A
0.38A
143.47
30.99
-039
0.43A.
185.99
185.99
112.48
103.30
246.77
-047
0.56A.
70.88
238.88
132.77
LEAR NAGEL
185.99
129.14
-051
0.21A.
900.00
1.09A.
413.15
413.68
-033
.83A.
.82A.
100
57
04-00-023-110- PRIOR INST. OR.54/130
SURVEYED BY: HAPUNEK & ASSOC. INC.
C=1: 1000.00
SPLIT (2)
SPLIT U)
143.47
30
112.48
SPLIT
(1) -048 11.29 A
SPLIT U) 0.59 A
10.70 A
(2) -049 0.59 A
0.21 A
0.38 A
-050
10.70 A
1563
1562.90
-048
11.29 A.
1686
10.79A.
126
10/25/89
#18669
APPROVED
LORAIN CO.
MAP DEPT.
DATE 10-11-89
PAGE 4-00-023-11
BY CAROLYN FRANCIS
VOID AFTER 18669