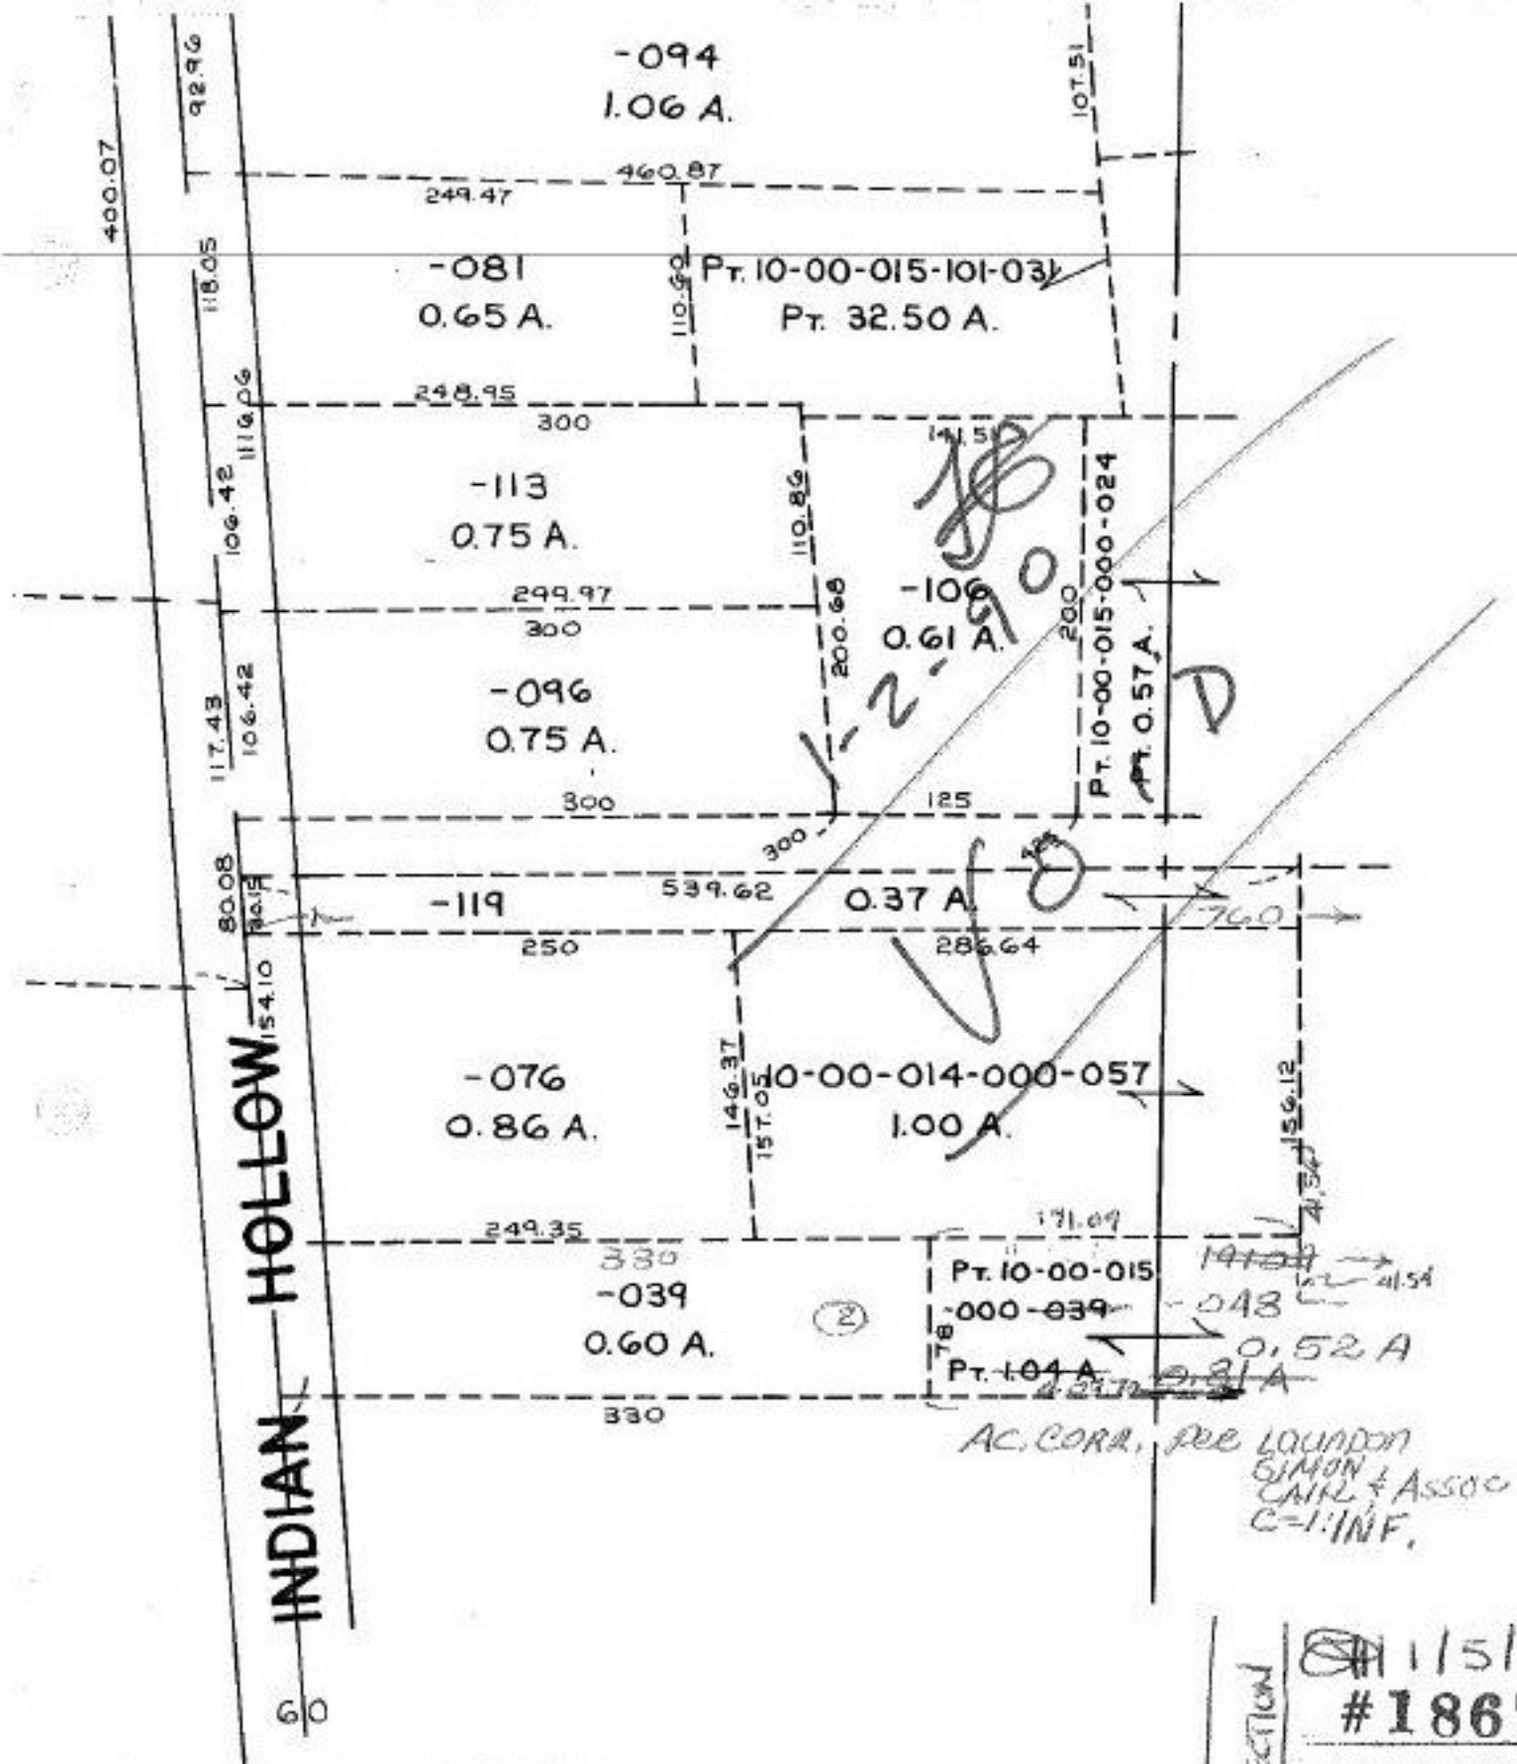

10-00-015-000-039 1.04 A
0.23 A
~~0.81 A~~
AC. CORR. PER 0.52 A
LAUNDON, SIMON, CAHL & ASSOC

ACREAGE CORRECTION

1/5/90
#18673

APPROVED
LORAIN CO.
MAP DEPT.

DATE 10-13-89
PAGE 10-00-014-D
BY CAROLYN FRANCIS
VOID AFTER # 18673

REVISED