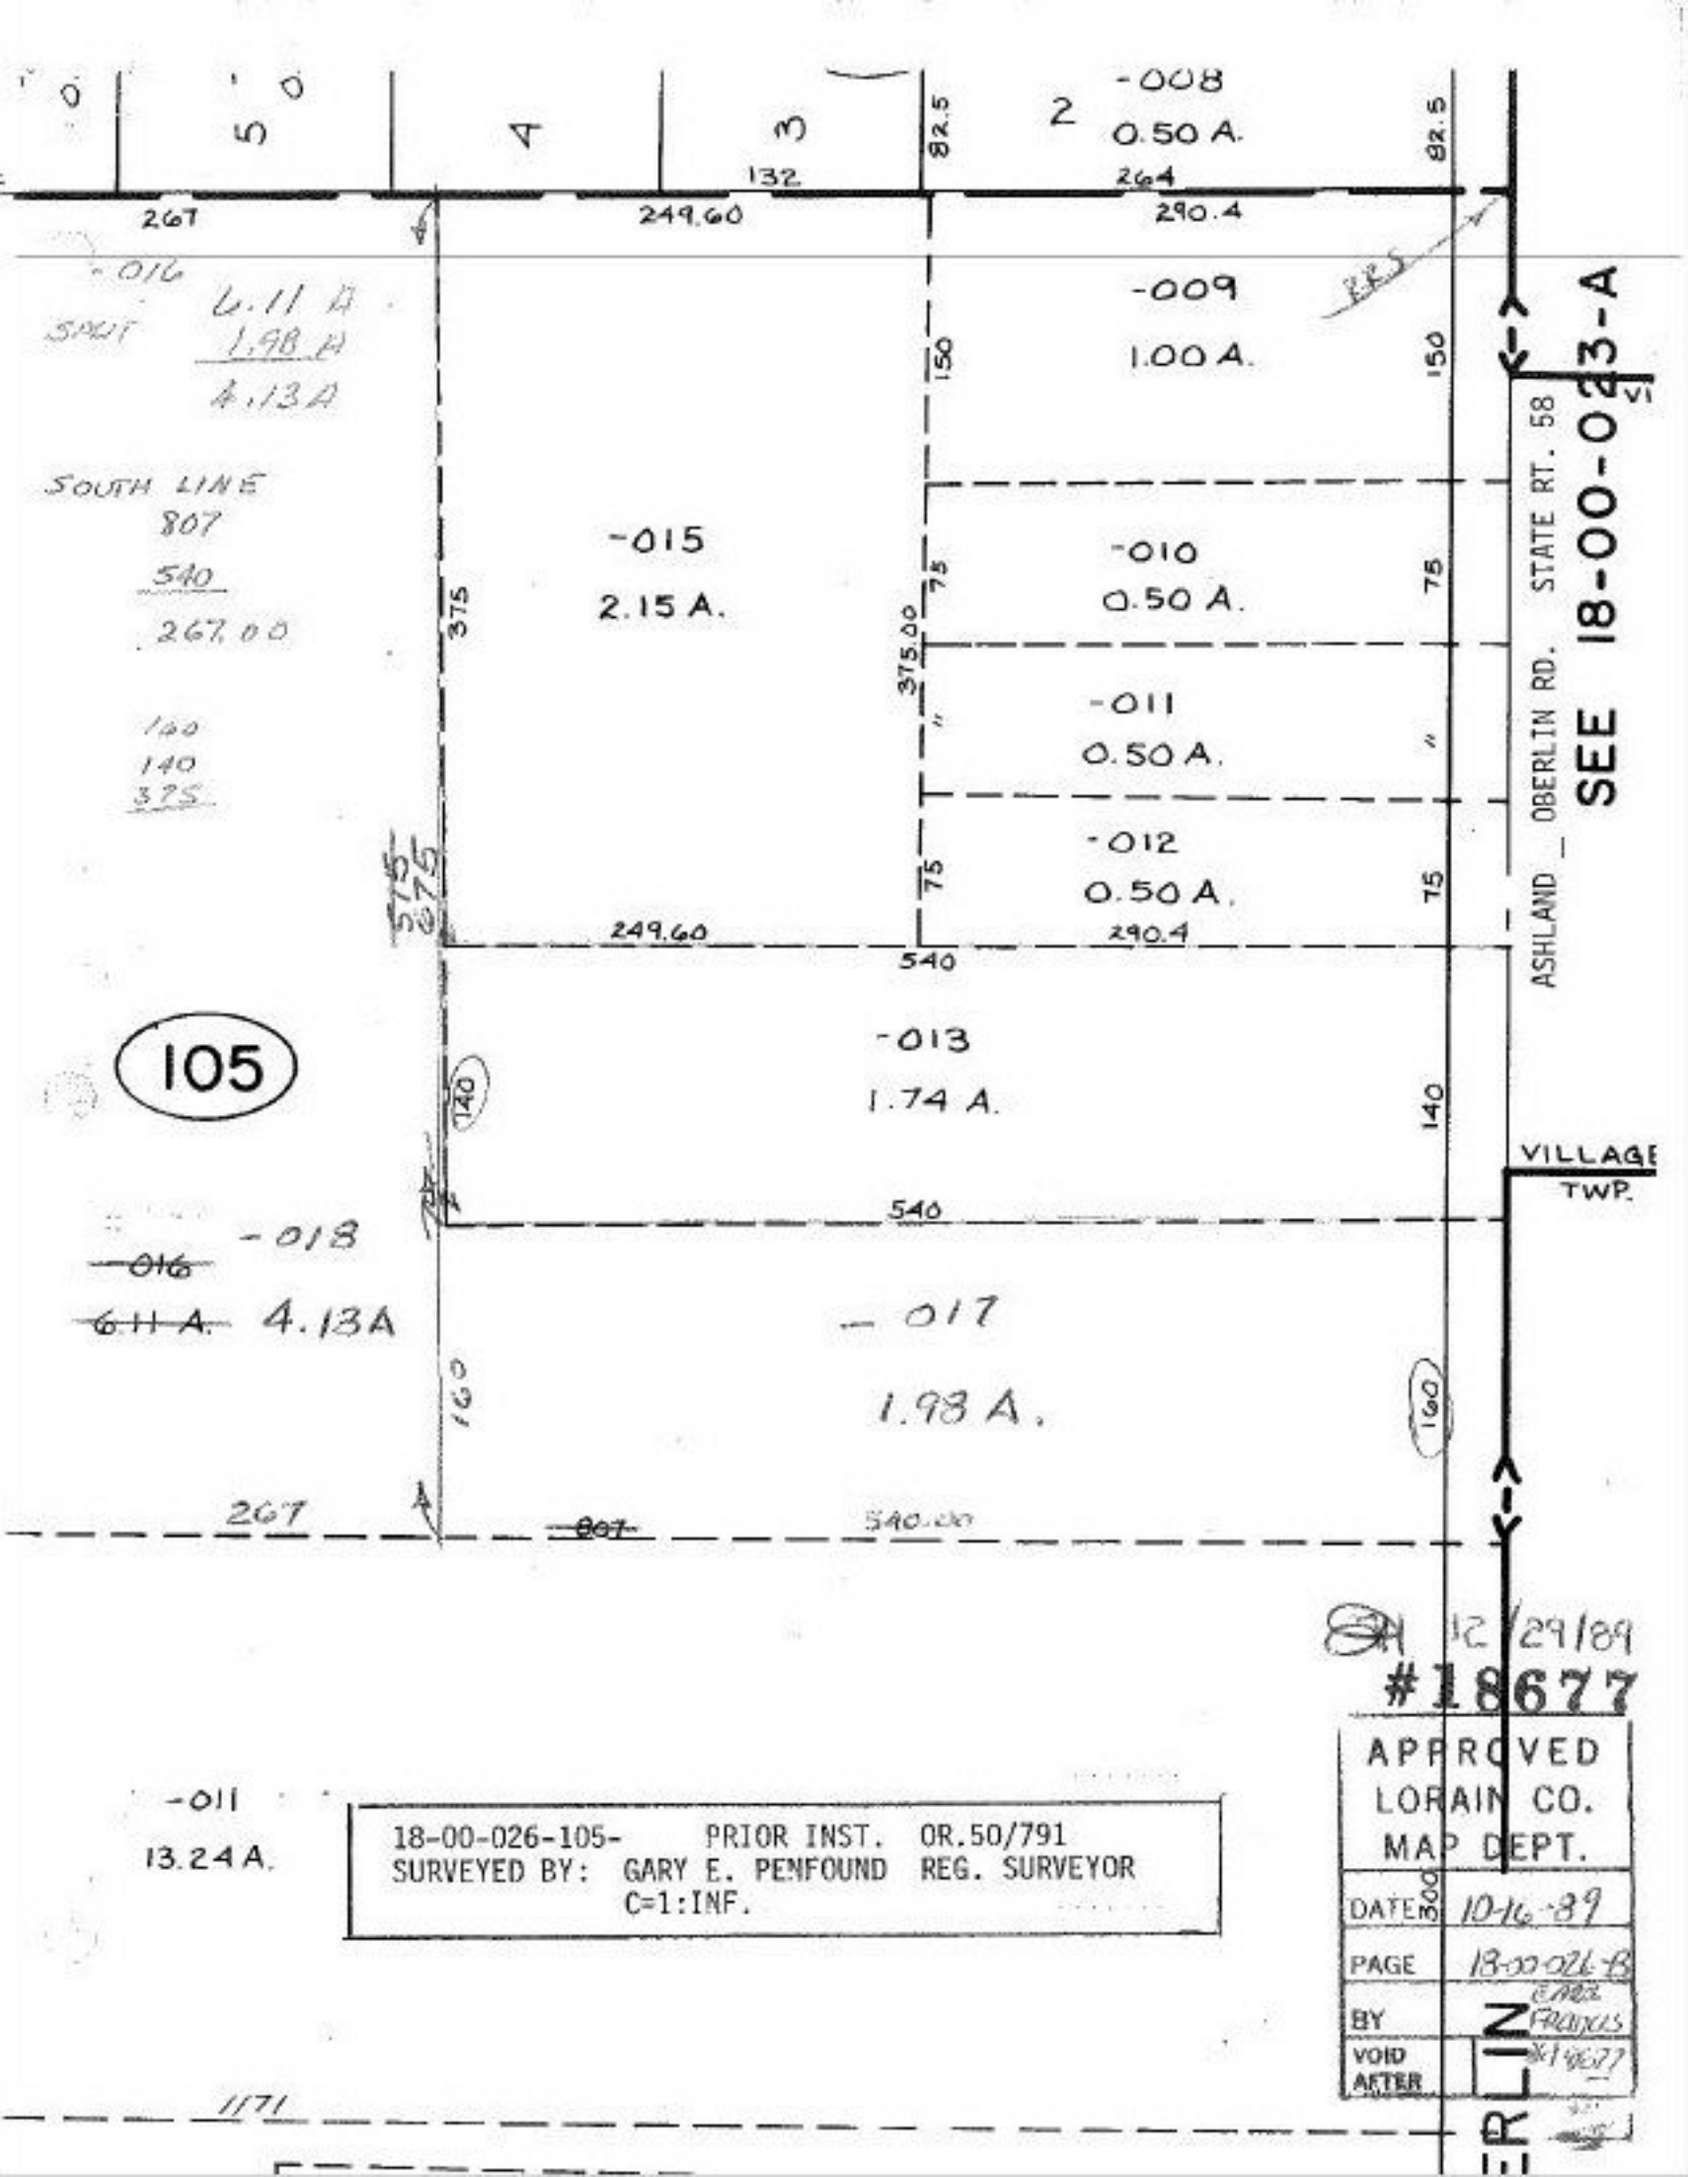
5
4
3
2
-008
0.50 A.
82.5
132
264
267
249.60
290.4
-016
6.11 A
SPLIT
1.98 A
4.13 A
-009
1.00 A.
150
SOUTH LINE
807
540
267.00
140
140
375
-015
2.15 A.
-010
0.50 A.
75
375.00
-011
0.50 A.
-012
0.50 A.
575
675
540
105
-013
1.74 A.
140
-018
-016
6.11 A. 4.13A
-017
1.98 A.
160
267
807
540.00
-011
13.24 A.
1171
ASHLAND _ OBERLIN RD. STATE RT. 58
SEE 18-00-023-A
VILLAGE
TWP.
18-00-026-105- PRIOR INST. OR.50/791
SURVEYED BY: GARY E. PENFOUND REG. SURVEYOR
C=1:INF.
12/29/89
#18677
APPROVED
LORAIN CO.
MAP DEPT.
DATE 10-16-89
PAGE 18-00-026-B
BY
VOID AFTER