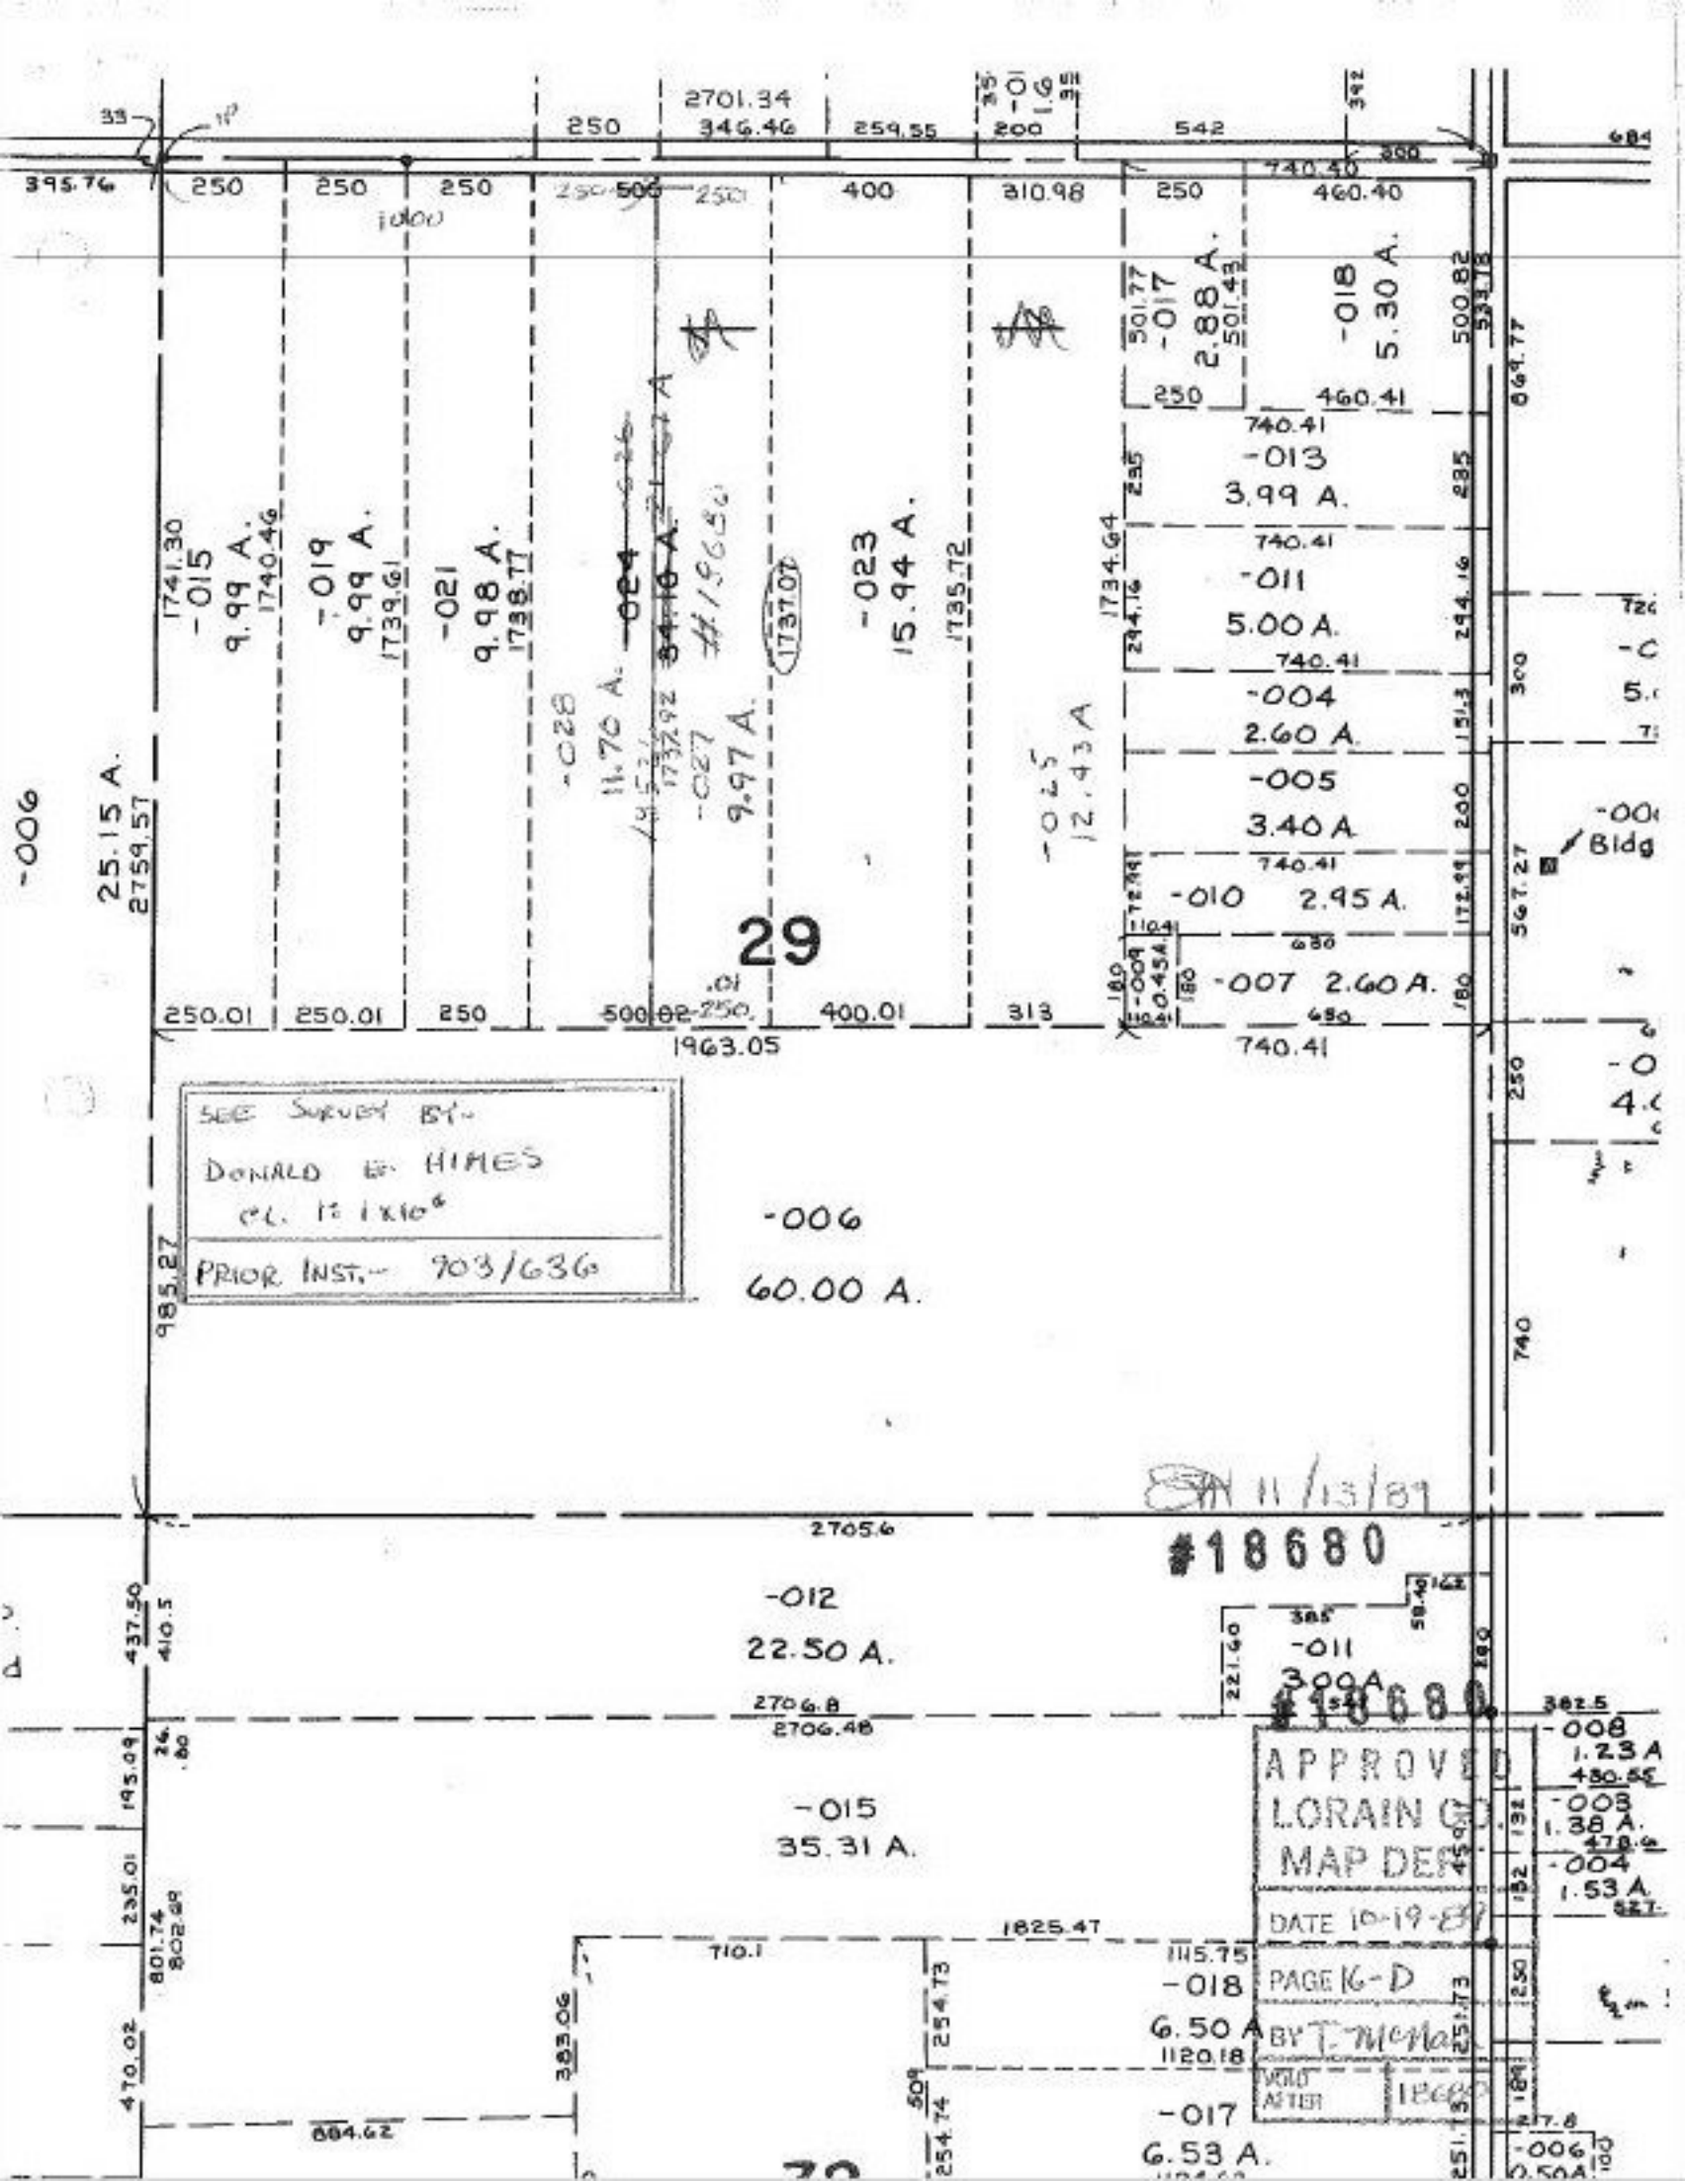
2701.34
346.46
259.55
200
542
740.40
460.40
310.98
400
250
1000
-015
9.99 A.
-019
9.99 A.
-021
9.98 A.
-024
11.70 A.
-027
9.97 A.
-023
15.94 A.
-025
12.43 A.
-018
5.30 A.
2.88 A.
-017
-013
3.99 A.
-011
5.00 A.
-004
2.60 A.
-005
3.40 A.
-010 2.95 A.
-007 2.60 A.
-009
-006
25.15 A.
2759.57
29
1963.05
SEE SURVEY BY-
DONALD E. HIMES
CL. II: 1x10⁶
-006
60.00 A.
985.27
11/13/89
#18680
2705.6
-012
22.50 A.
2706.8
2706.48
-011
3.09A
#18680
-015
35.31 A.
APPROVED
LORAIN CO.
MAP DEPT.
DATE 10-19-89
PAGE 16-D
BY T. McHale
-008
1.23 A.
-008
1.38 A.
-004
1.53 A.
1825.47
710.1
-018
6.50 A
1120.18
-017
6.53 A.
-006
0.50A
Bldg