-004 37.15 2623.60
SPLIT 5.44 750.
31.71 1873.60

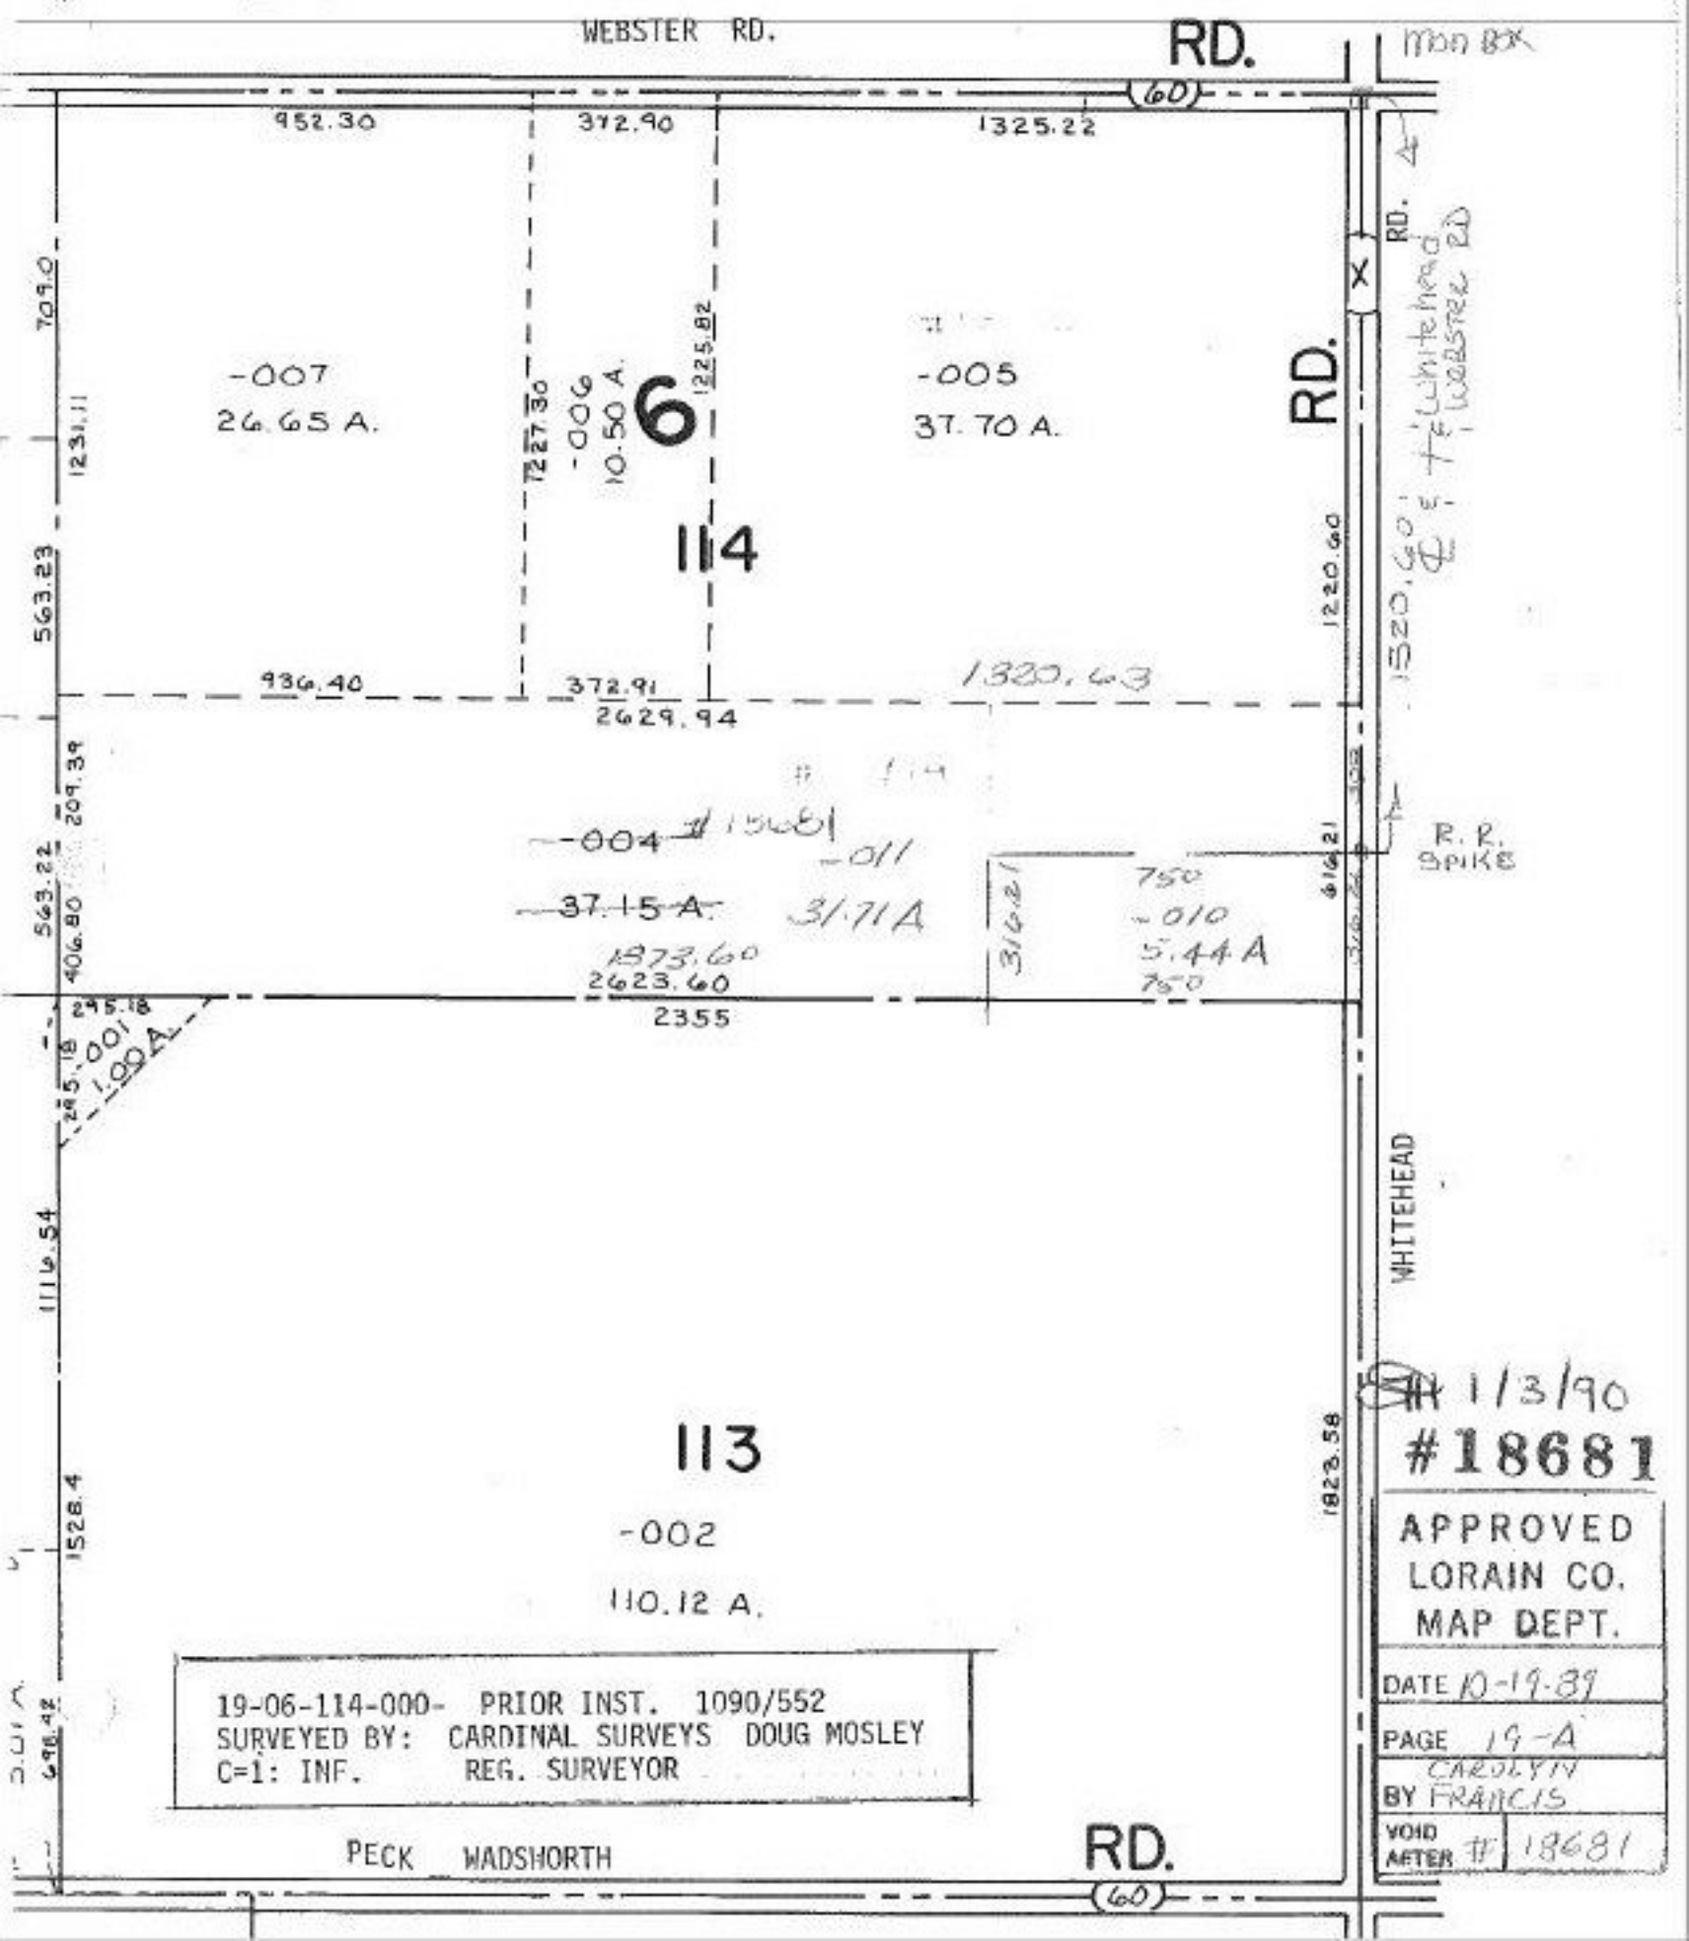

19-06-114-000- PRIOR INST. 1090/552
SURVEYED BY: CARDINAL SURVEYS DOUG MOSLEY
C=1: INF. REG. SURVEYOR

11/3/90
#18681
APPROVED
LORAIN CO.
MAP DEPT.
DATE 10-19-89
PAGE 19-A
BY CAROLYN FRANCIS
VOID AFTER # 18681