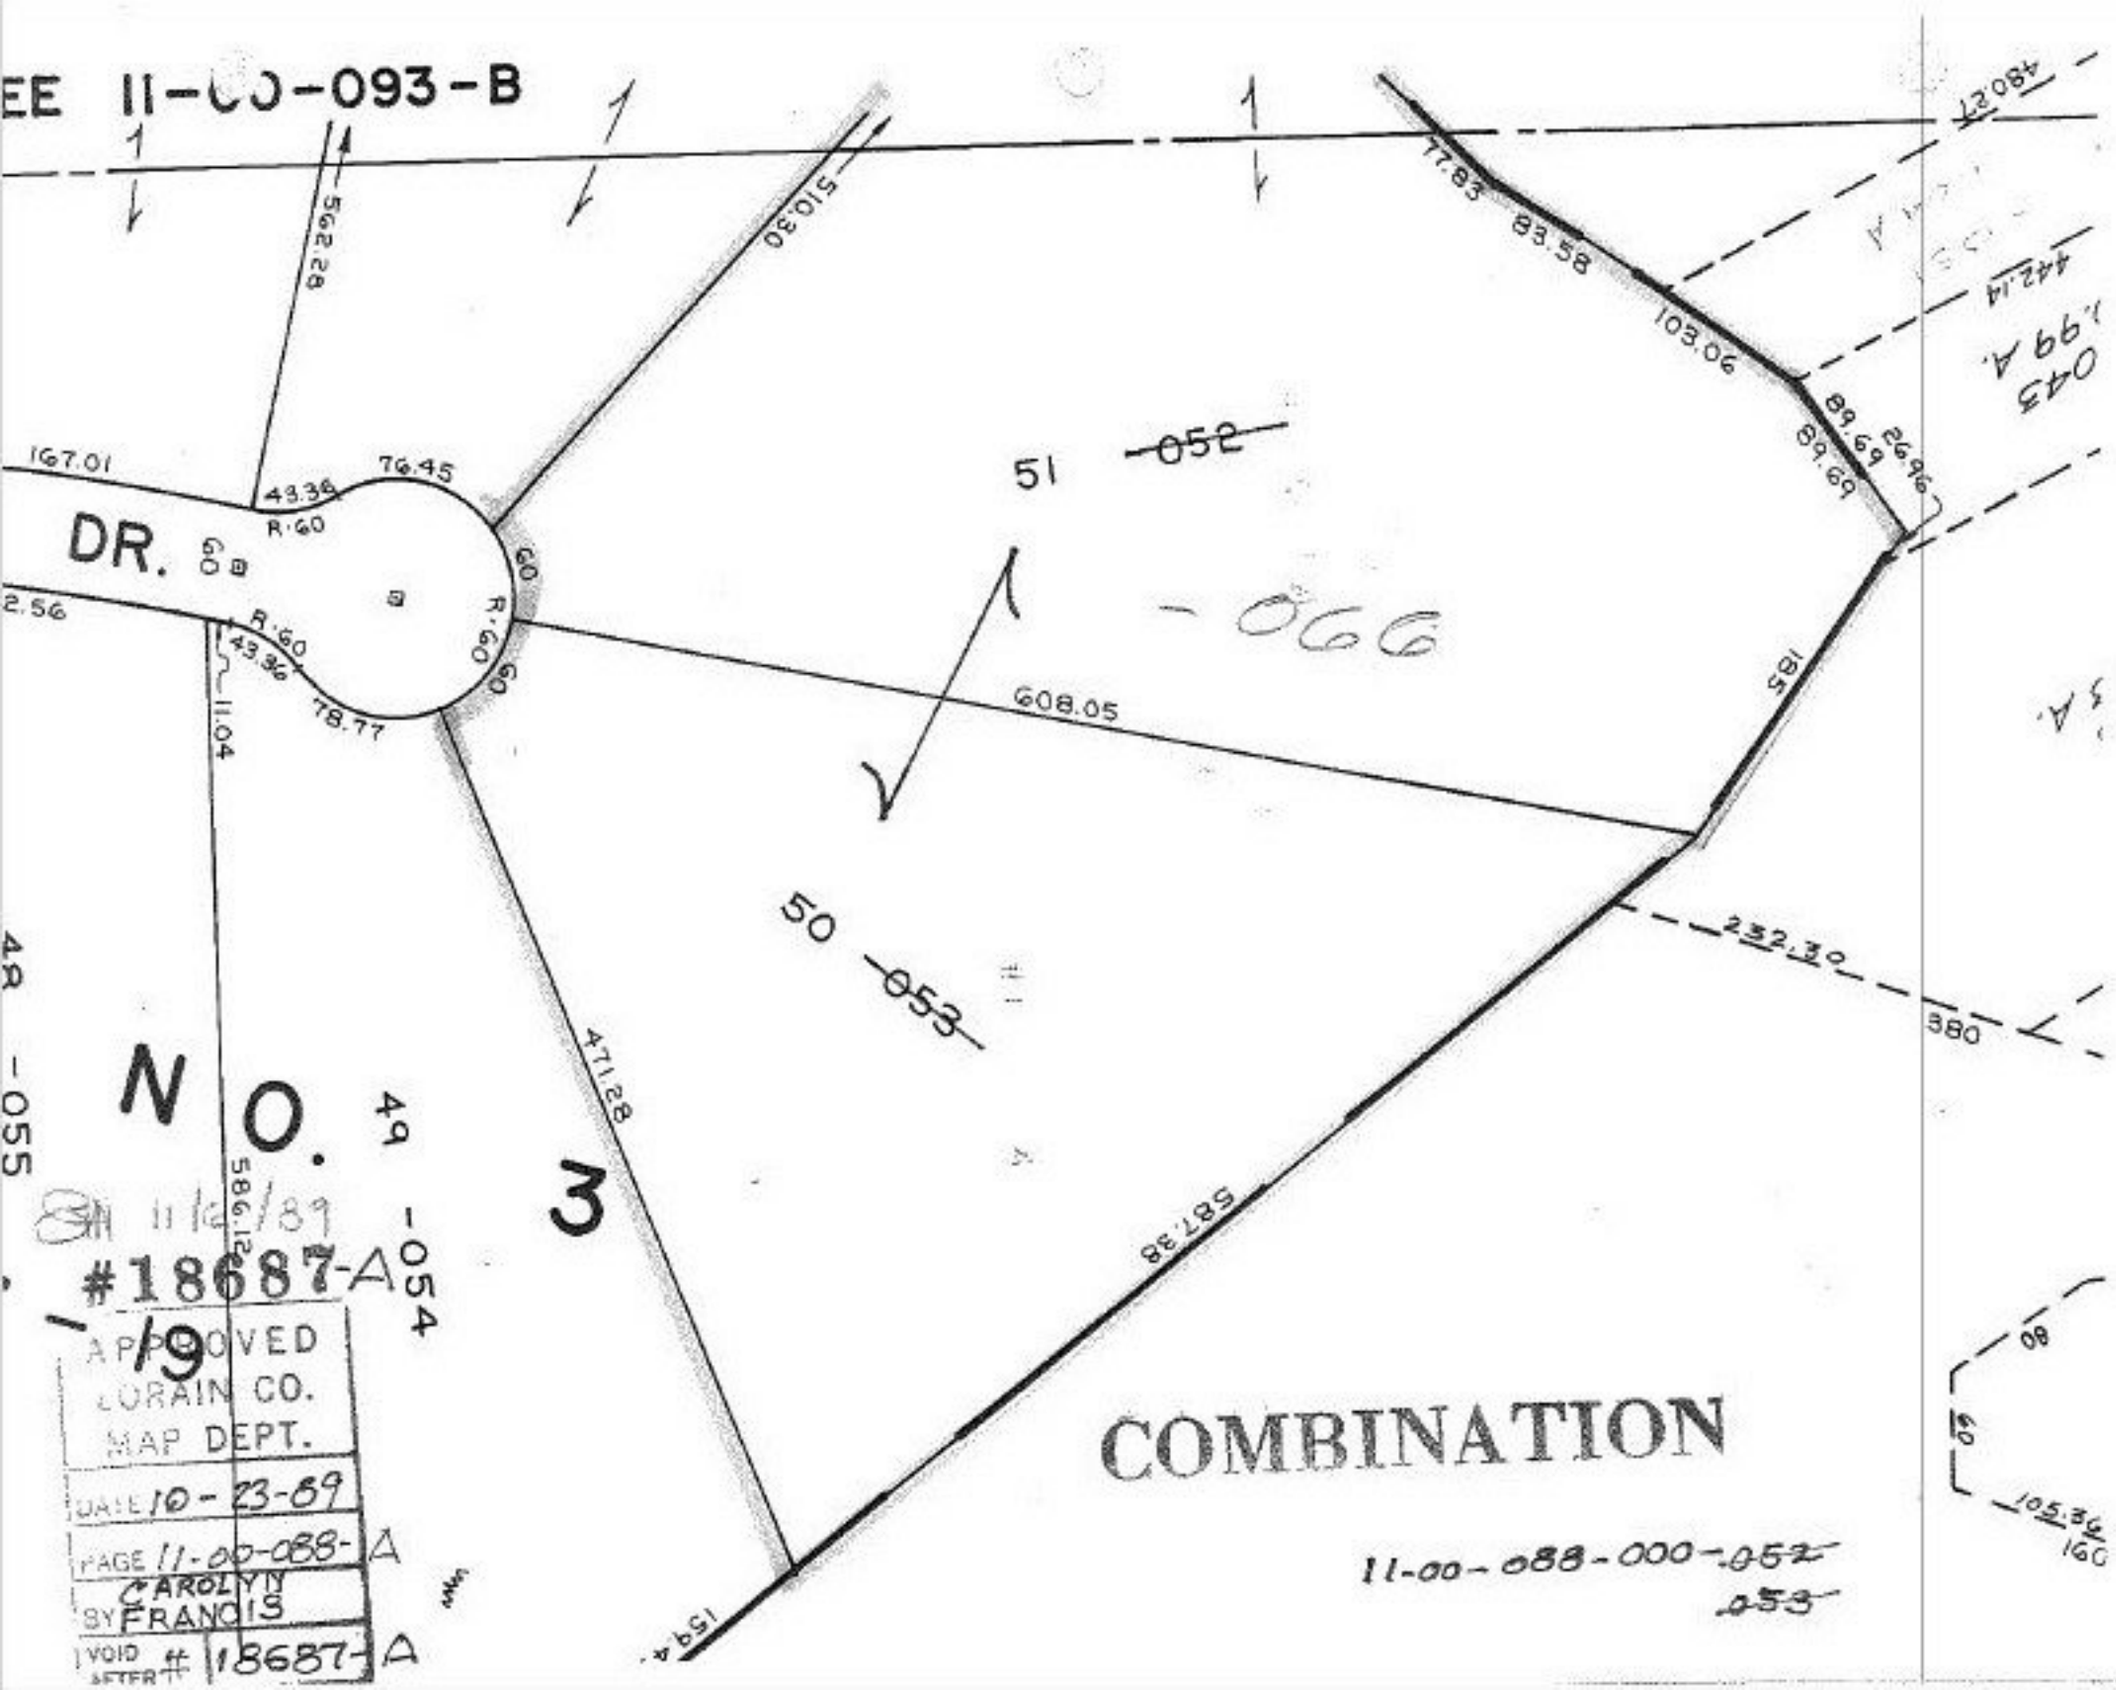
EE 11-00-093-B
562.28
510.30
77.83
83.58
103.06
89.69
26.96
480.27
442.14
167.01
43.36
76.45
R.60
DR.
60
R.60
60
60
2.56
R.60
43.36
78.77
11.04
608.05
185
51
052
1-066
50
053
232.30
380
471.28
587.38
586.12
49
-054
48
-055
NO.
3
11/2/89
#18687-A
1/9
APPROVED
LORAIN CO.
MAP DEPT.
DATE 10-23-69
PAGE 11-00-088-A
BY CAROLYN FRANCIS
VOID AFTER # 18687-A
COMBINATION
11-00-088-000-052
053
105.34
150
60
60
150'