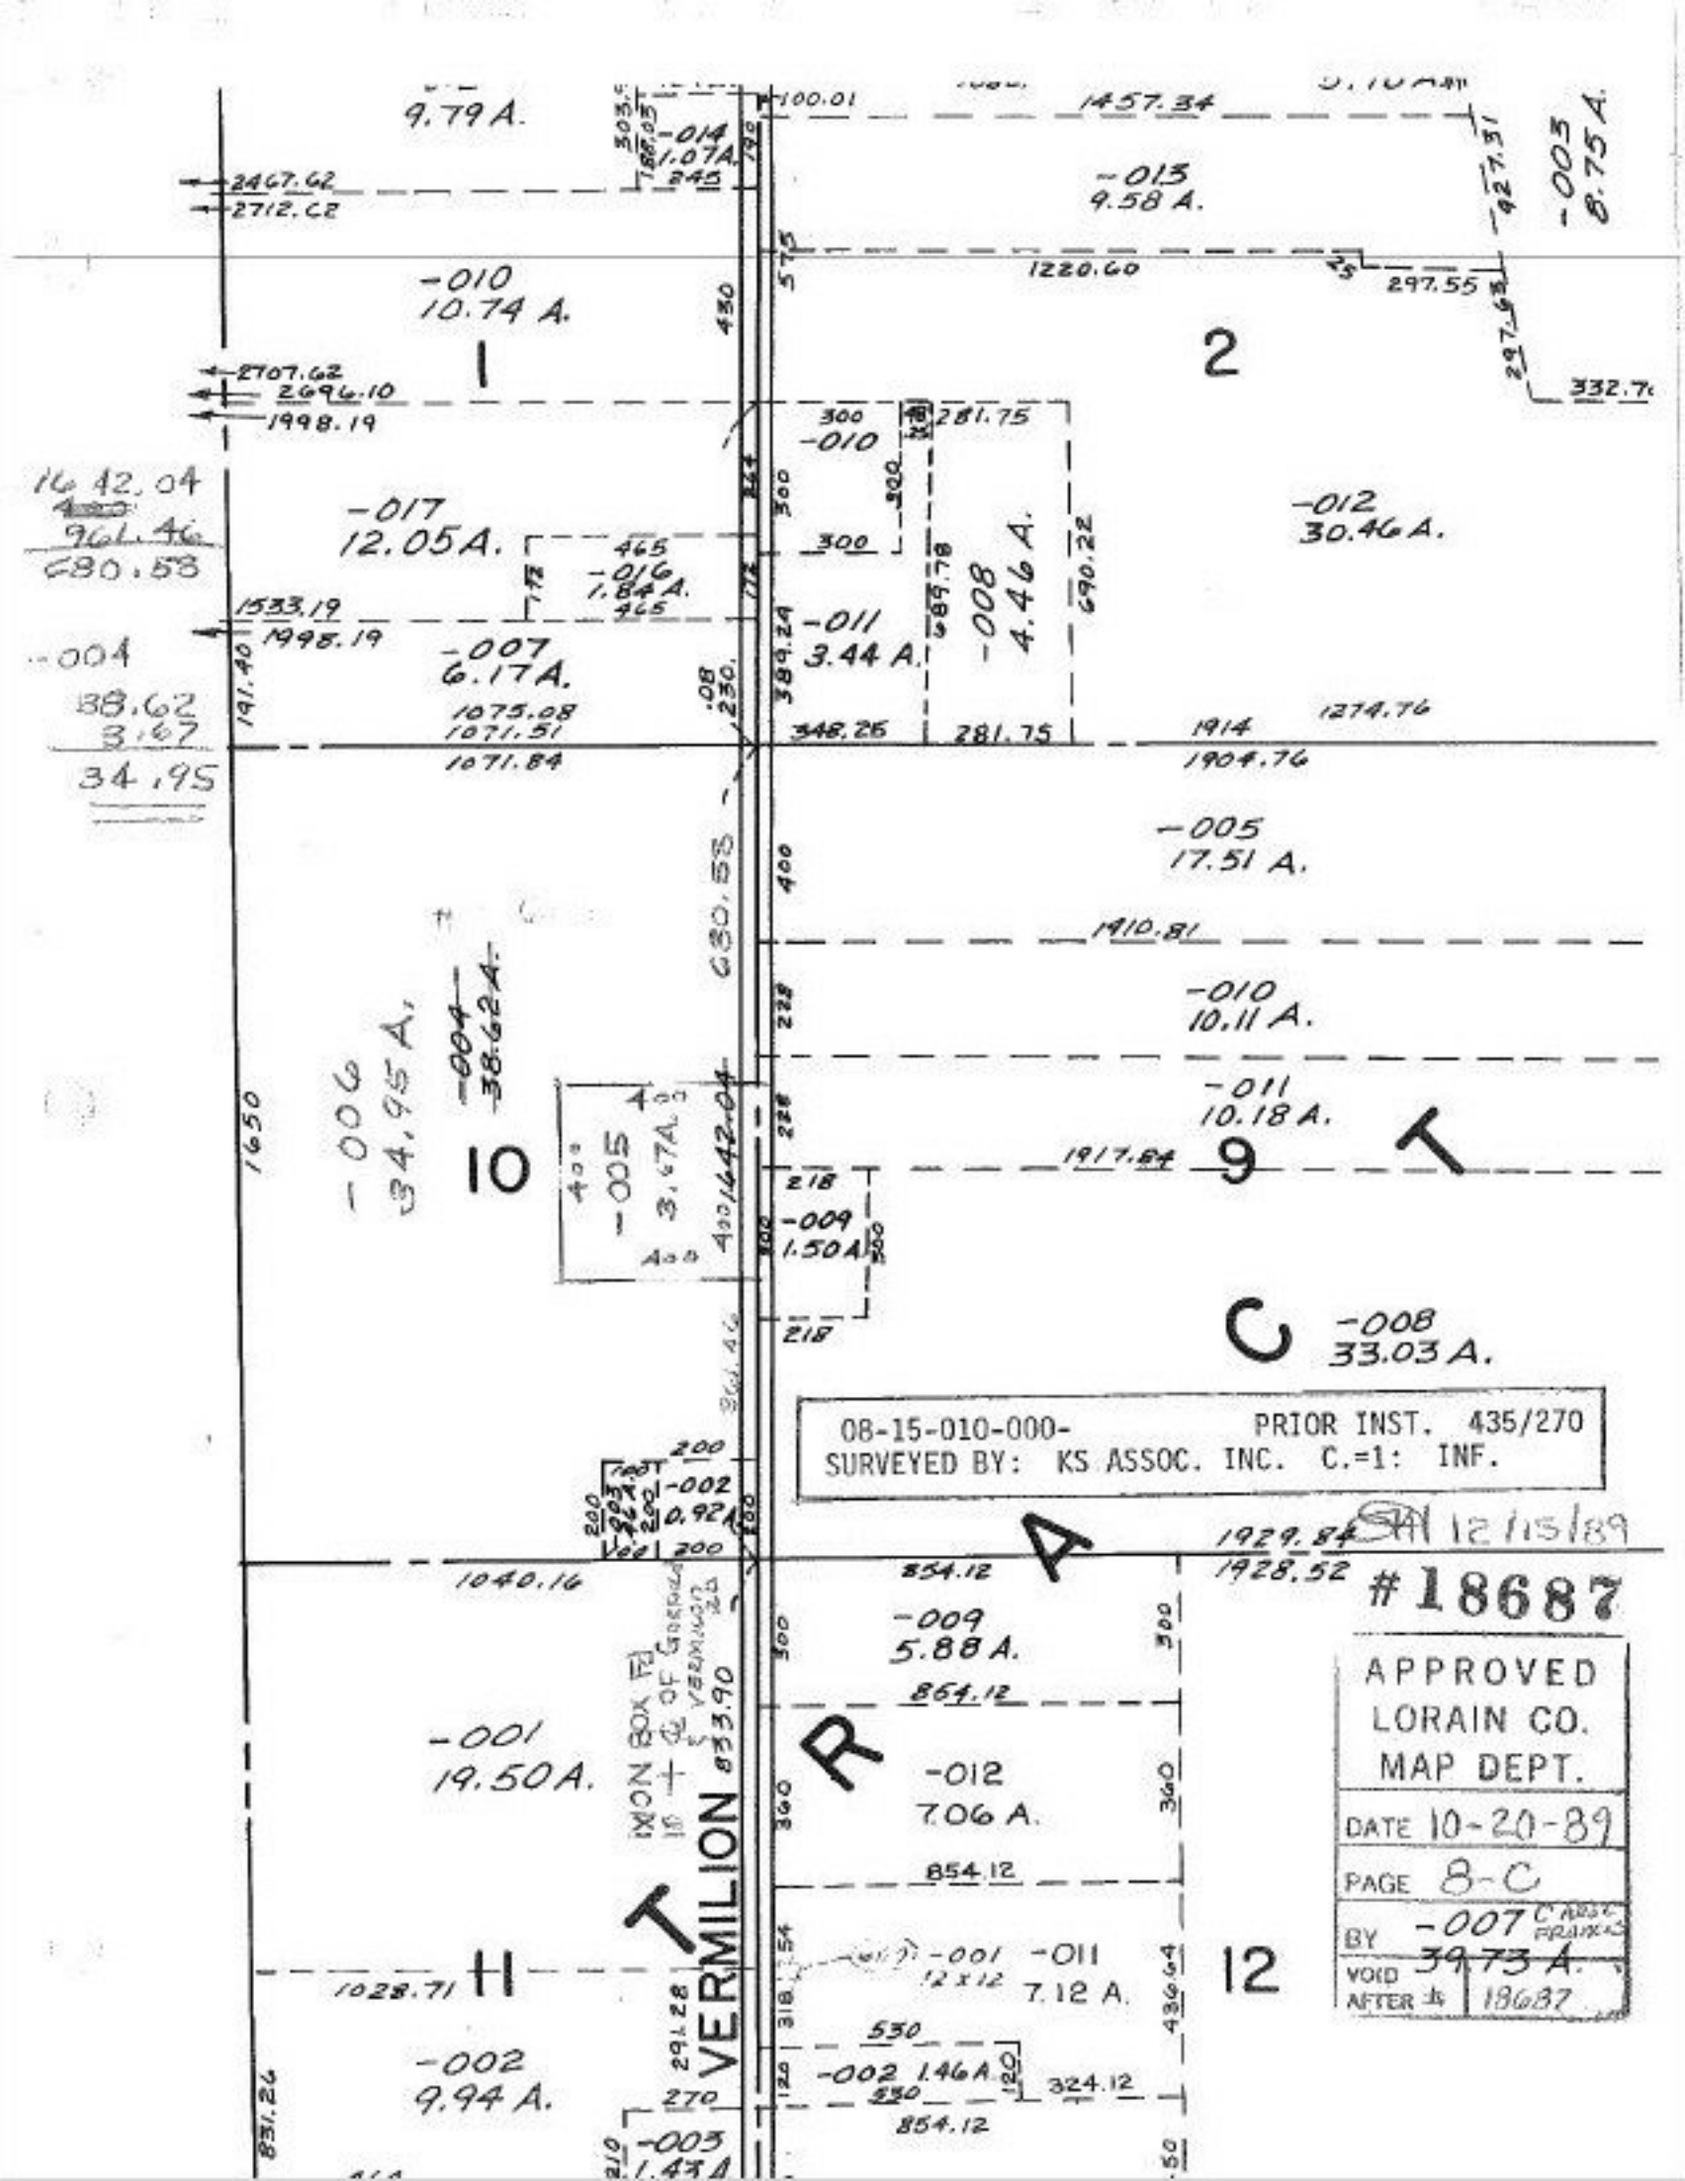

9.79 A.
-014
1.07 A.
100.01
1457.34
-013
9.58 A.
-003
8.75 A.
2467.62
2712.62
-010
10.74 A.
1220.60
297.55
1
2
2707.62
2696.10
1998.19
-010
281.75
16 42.04
961.46
680.58
-017
12.05 A.
-016
1.84 A.
-012
30.46 A.
-008
4.46 A.
1533.19
1998.19
-011
3.44 A.
-004
38.62
3.67
34.95
-007
6.17 A.
1075.08
1071.51
1071.84
348.25
281.75
1914
1904.76
1274.76
-005
17.51 A.
1910.81
-010
10.11 A.
-011
10.18 A.
-006
34.95 A.
-004
38.62 A.
-005
3.67 A.
10
9
1917.84
-009
1.50 A.
C
-008
33.03 A.
08-15-010-000- PRIOR INST. 435/270
SURVEYED BY: KS ASSOC. INC. C.=1: INF.
-002
0.92 A.
1929.84
1928.52
12/15/89
#18687
1040.16
854.12
-009
5.88 A.
APPROVED
LORAIN CO.
MAP DEPT.
-001
19.50 A.
-012
7.06 A.
DATE 10-20-89
PAGE 8-C
BY -007
VOID AFTER 18687
VERMILION
-001
-011
7.12 A.
12
11
1028.71
-002
9.94 A.
-002 1.46 A.
324.12
854.12
-003
1.43 A.