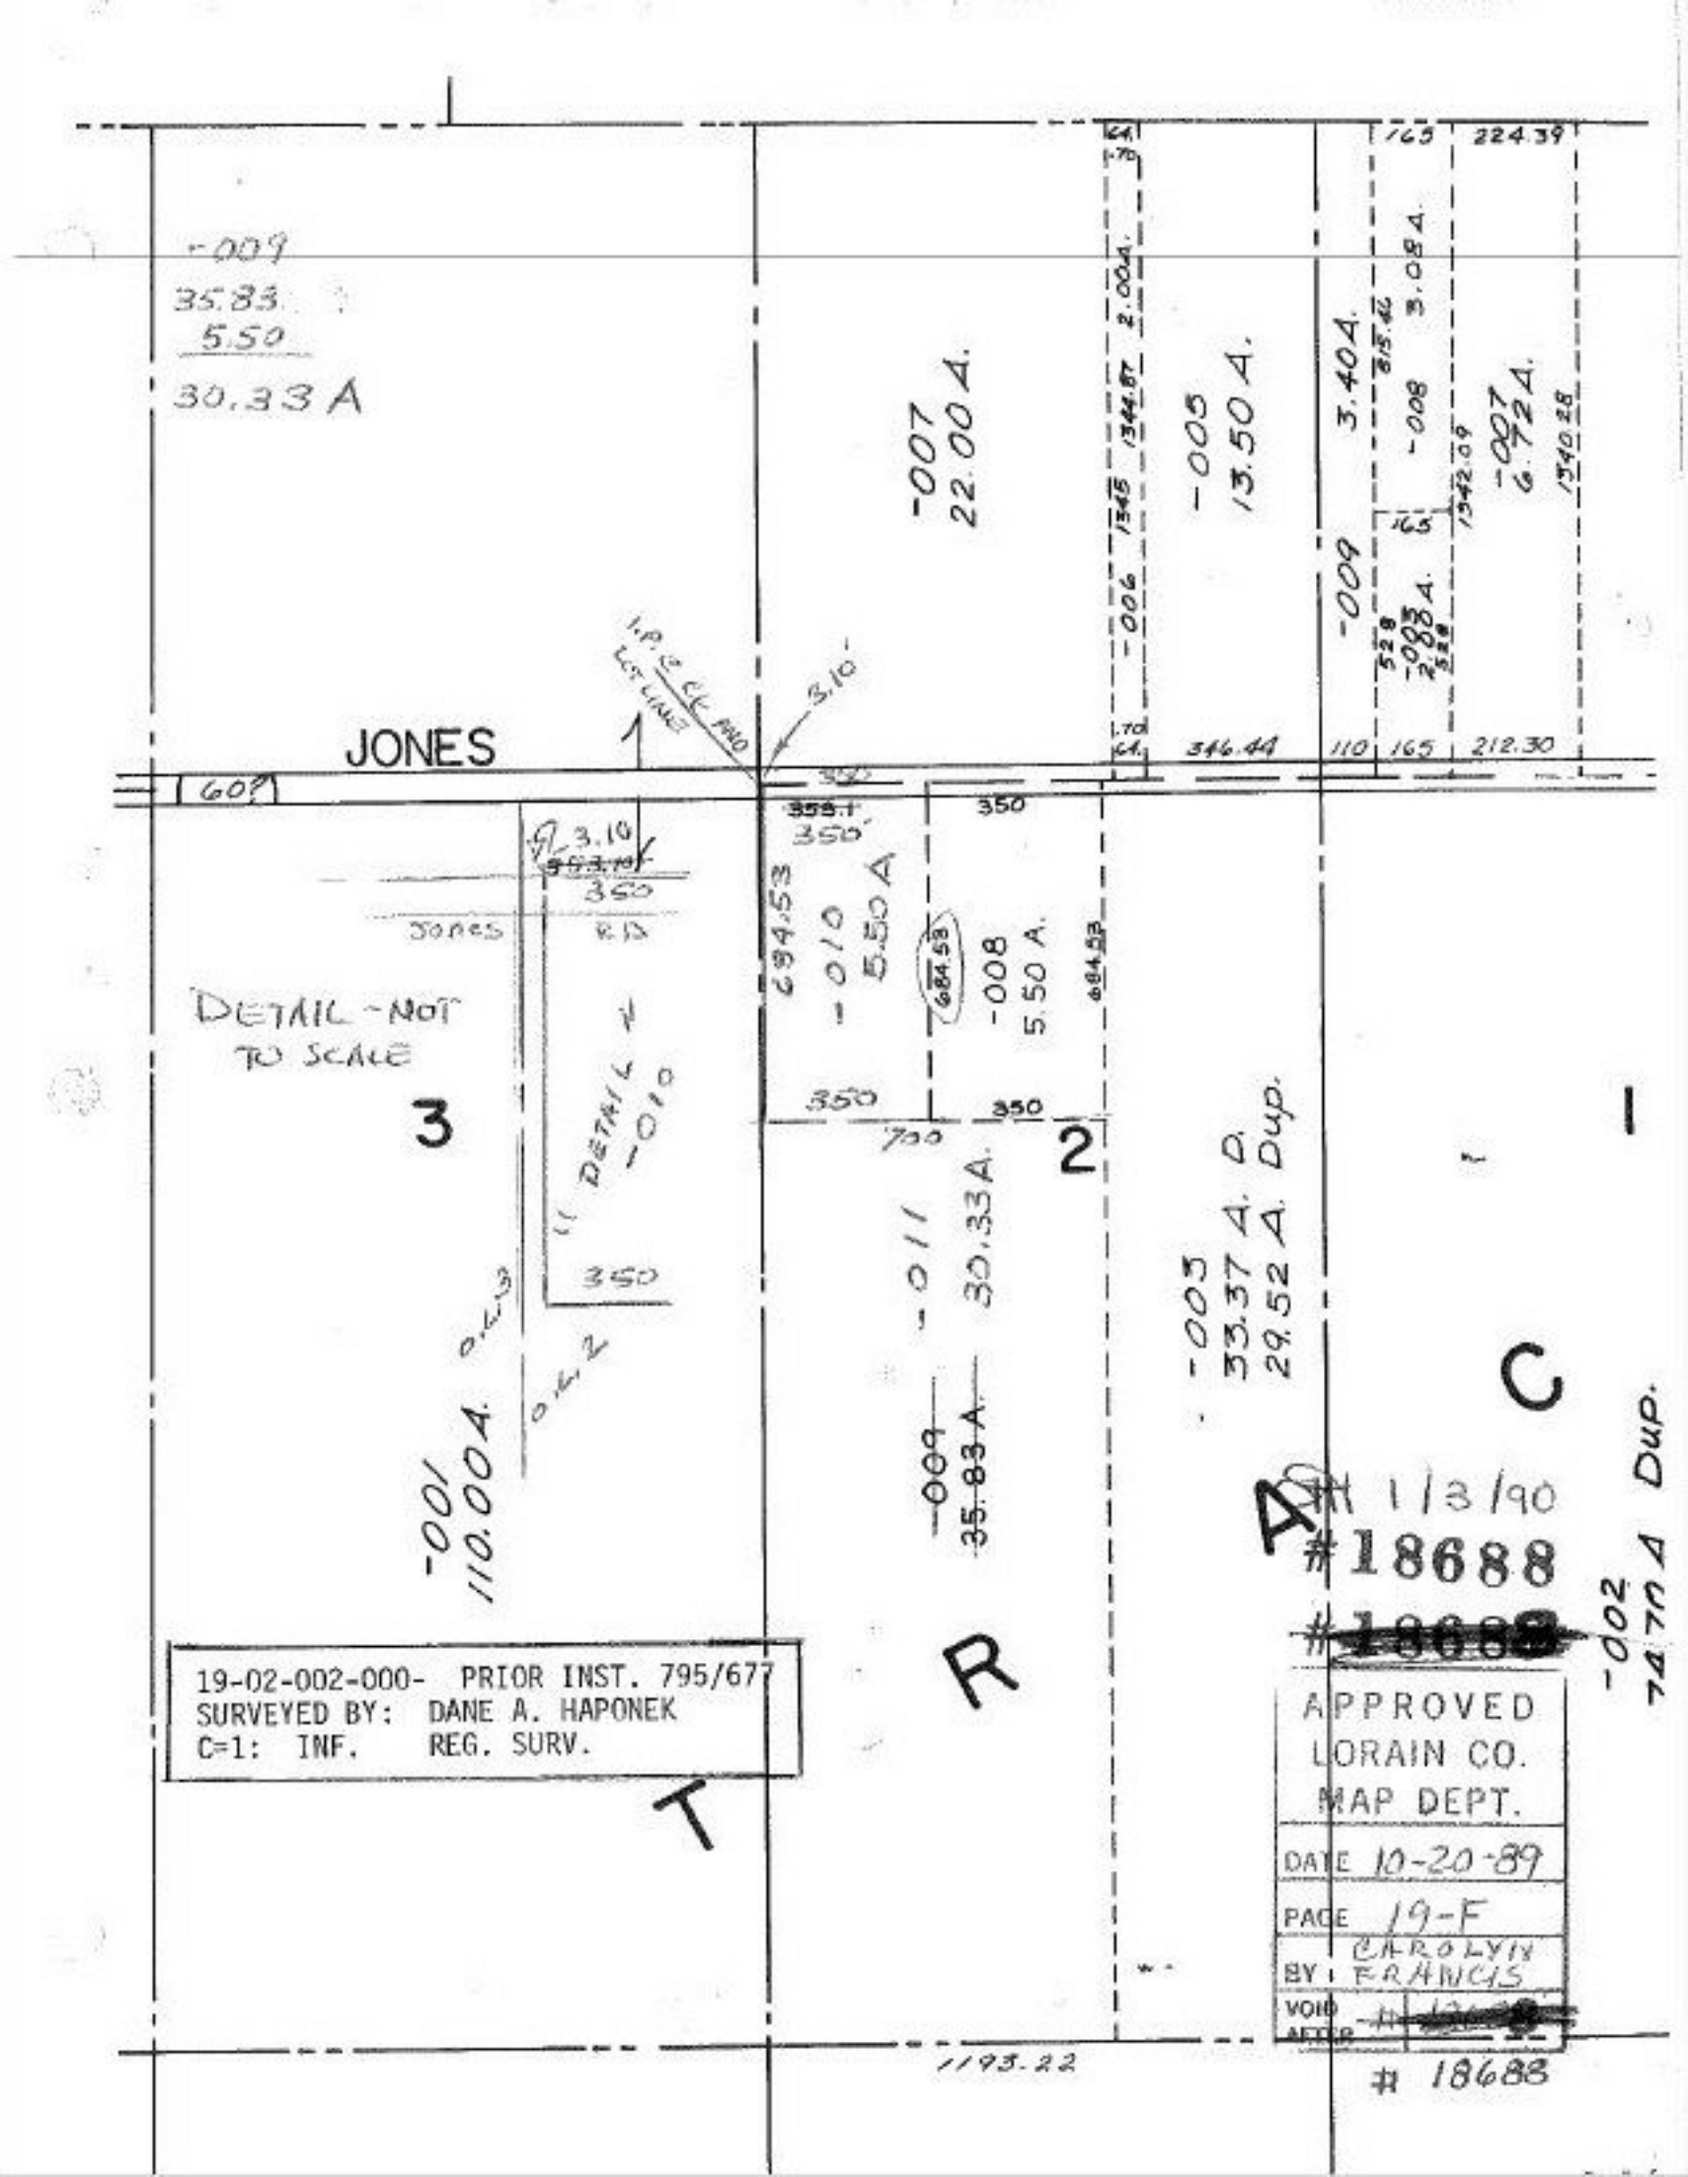
-009
35.83
5.50
30.33 A
-007
22.00 A.
-005
13.50 A.
-006
-009
3.404.
-008
3.084.
-007
6.724.
JONES
60'
I.P. & C/L PKD
1.70
346.44
110
165
212.30
224.39
1340.28
1342.09
1345
1344.87
2.004.
3.10-
350
358.1
694.53
-010
5.50 A
684.53
-008
5.50 A.
DETAIL - NOT TO SCALE
3
2
DETAIL
-010
-001
110.004.
-011
30.33 A.
35.83 A.
-009
-003
33.37 A. &
29.52 A. Dup.
-002
74.704 Dup.
1193.22
19-02-002-000- PRIOR INST. 795/677
SURVEYED BY: DANE A. HAPONEK
C=1: INF. REG. SURV.
APPROVED
LORAIN CO.
MAP DEPT.
DATE 10-20-89
PAGE 19-F
BY: CAROLYN FRANCIS
VOID AFTER
11/3/90
#18688
#18688
18688