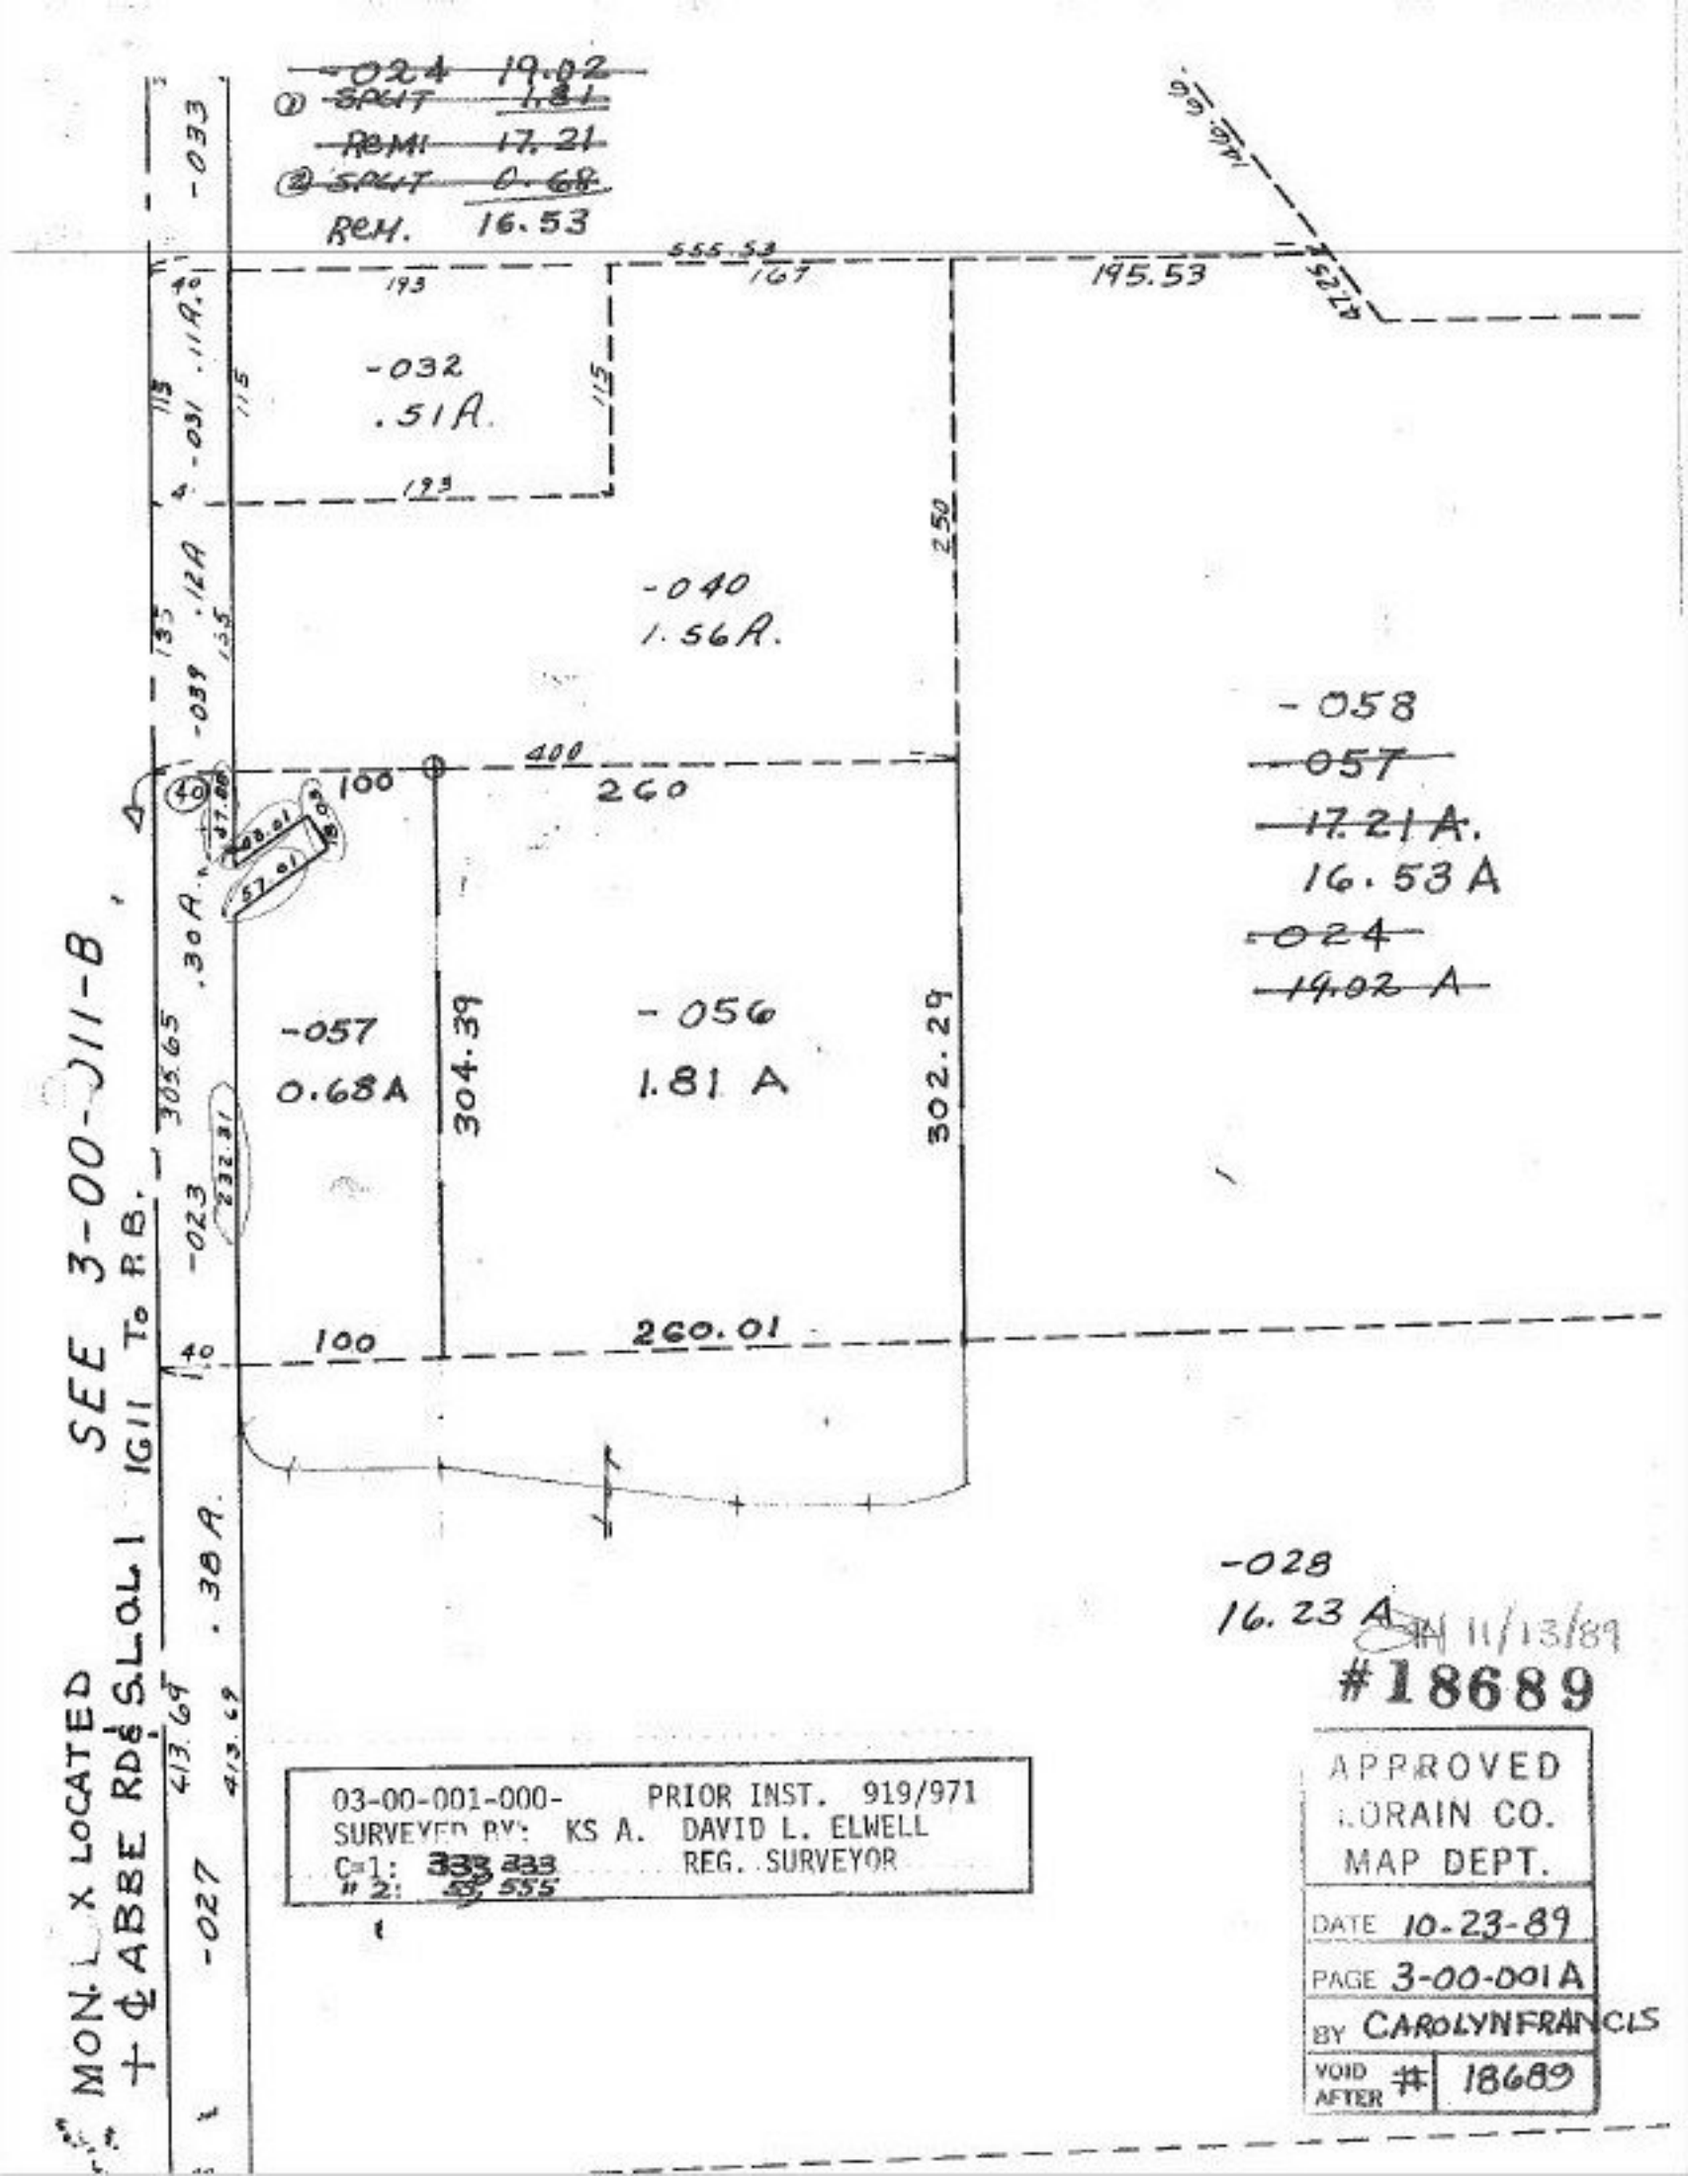

~~-024 19.02~~
① ~~SPLIT 1.81~~
~~REMI 17.21~~
② ~~SPLIT 0.68~~
REM. 16.53
-033
555.53
167
195.53
193
-032
.51A.
115
-031 .11A.
-040
1.56A.
250
-039 .12A
135
-058
~~-057~~
~~17.21 A.~~
16.53 A
~~-024~~
~~19.02 A~~
400
100
260
.30A.
-057
0.68A
304.39
-056
1.81 A
302.29
305.65
-023
232.31
100
260.01
40
SEE 3-00-011-B
1G11 To R.B.
MON. BOX LOCATED
+ ℄ ABBE RD & S.L.O.L.
.38A.
413.69
-027
-028
16.23 A
11/13/89
#18689
03-00-001-000- PRIOR INST. 919/971
SURVEYED BY: KS A. DAVID L. ELWELL
C=1: 333 333
#2: 55 555
REG. SURVEYOR
APPROVED
LORAIN CO.
MAP DEPT.
DATE 10-23-89
PAGE 3-00-001A
BY CAROLYN FRANCIS
VOID AFTER # 18689