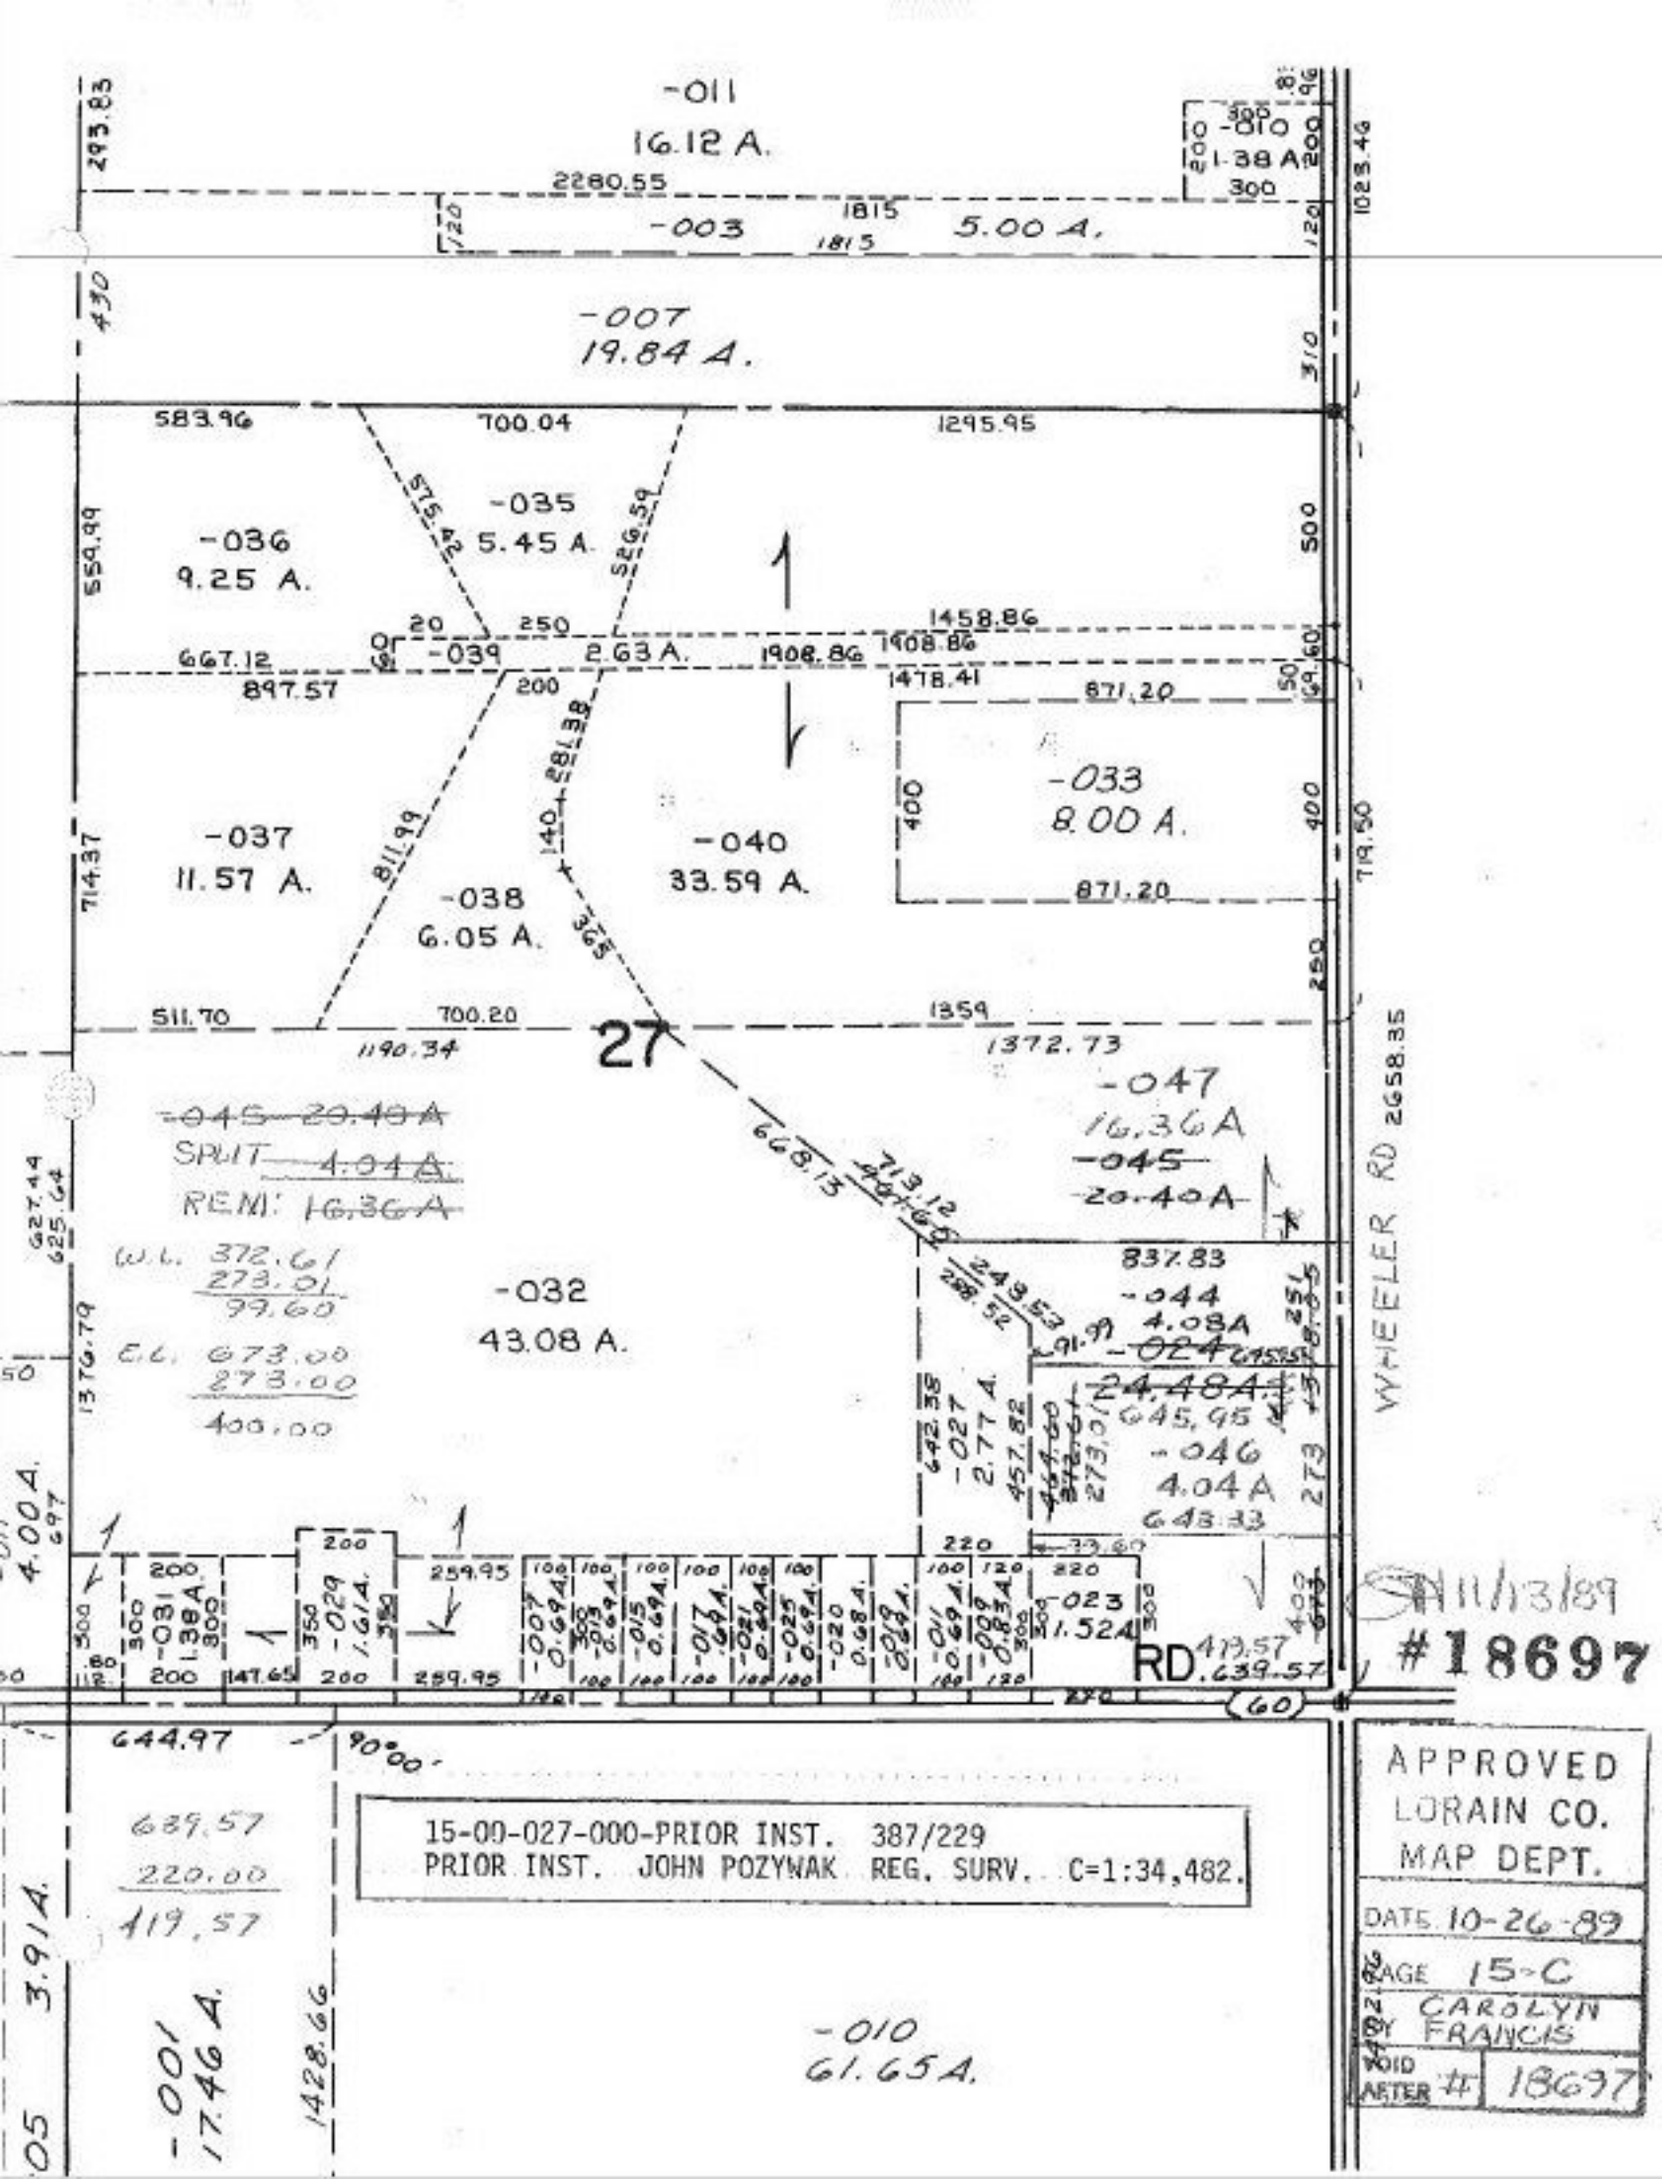
-011
16.12 A.
-010
1.38 A
-003
5.00 A.
-007
19.84 A.
-036
9.25 A.
-035
5.45 A.
-039
2.63 A.
-033
8.00 A.
-037
11.57 A.
-040
33.59 A.
-038
6.05 A.
27
-047
16.36A
-045
20.40A
-045 20.40A
SPLIT 4.04A.
REM: 16.36A
-032
43.08 A.
-044
4.08A
-024
24.48A.
-046
4.04A
-027
2.77 A.
-029
1.614.
-031
1.38A.
-023
1.52A
-001
17.46A.
-010
61.65A.
WHEELER RD
RD.
15-00-027-000-PRIOR INST. 387/229
PRIOR INST. JOHN POZYWAK REG. SURV. C=1:34,482.
APPROVED
LORAIN CO.
MAP DEPT.
DATE 10-26-89
PAGE 15-C
BY CAROLYN FRANCIS
VOID AFTER # 18697
11/13/89
#18697