SEE 12-00-076-B

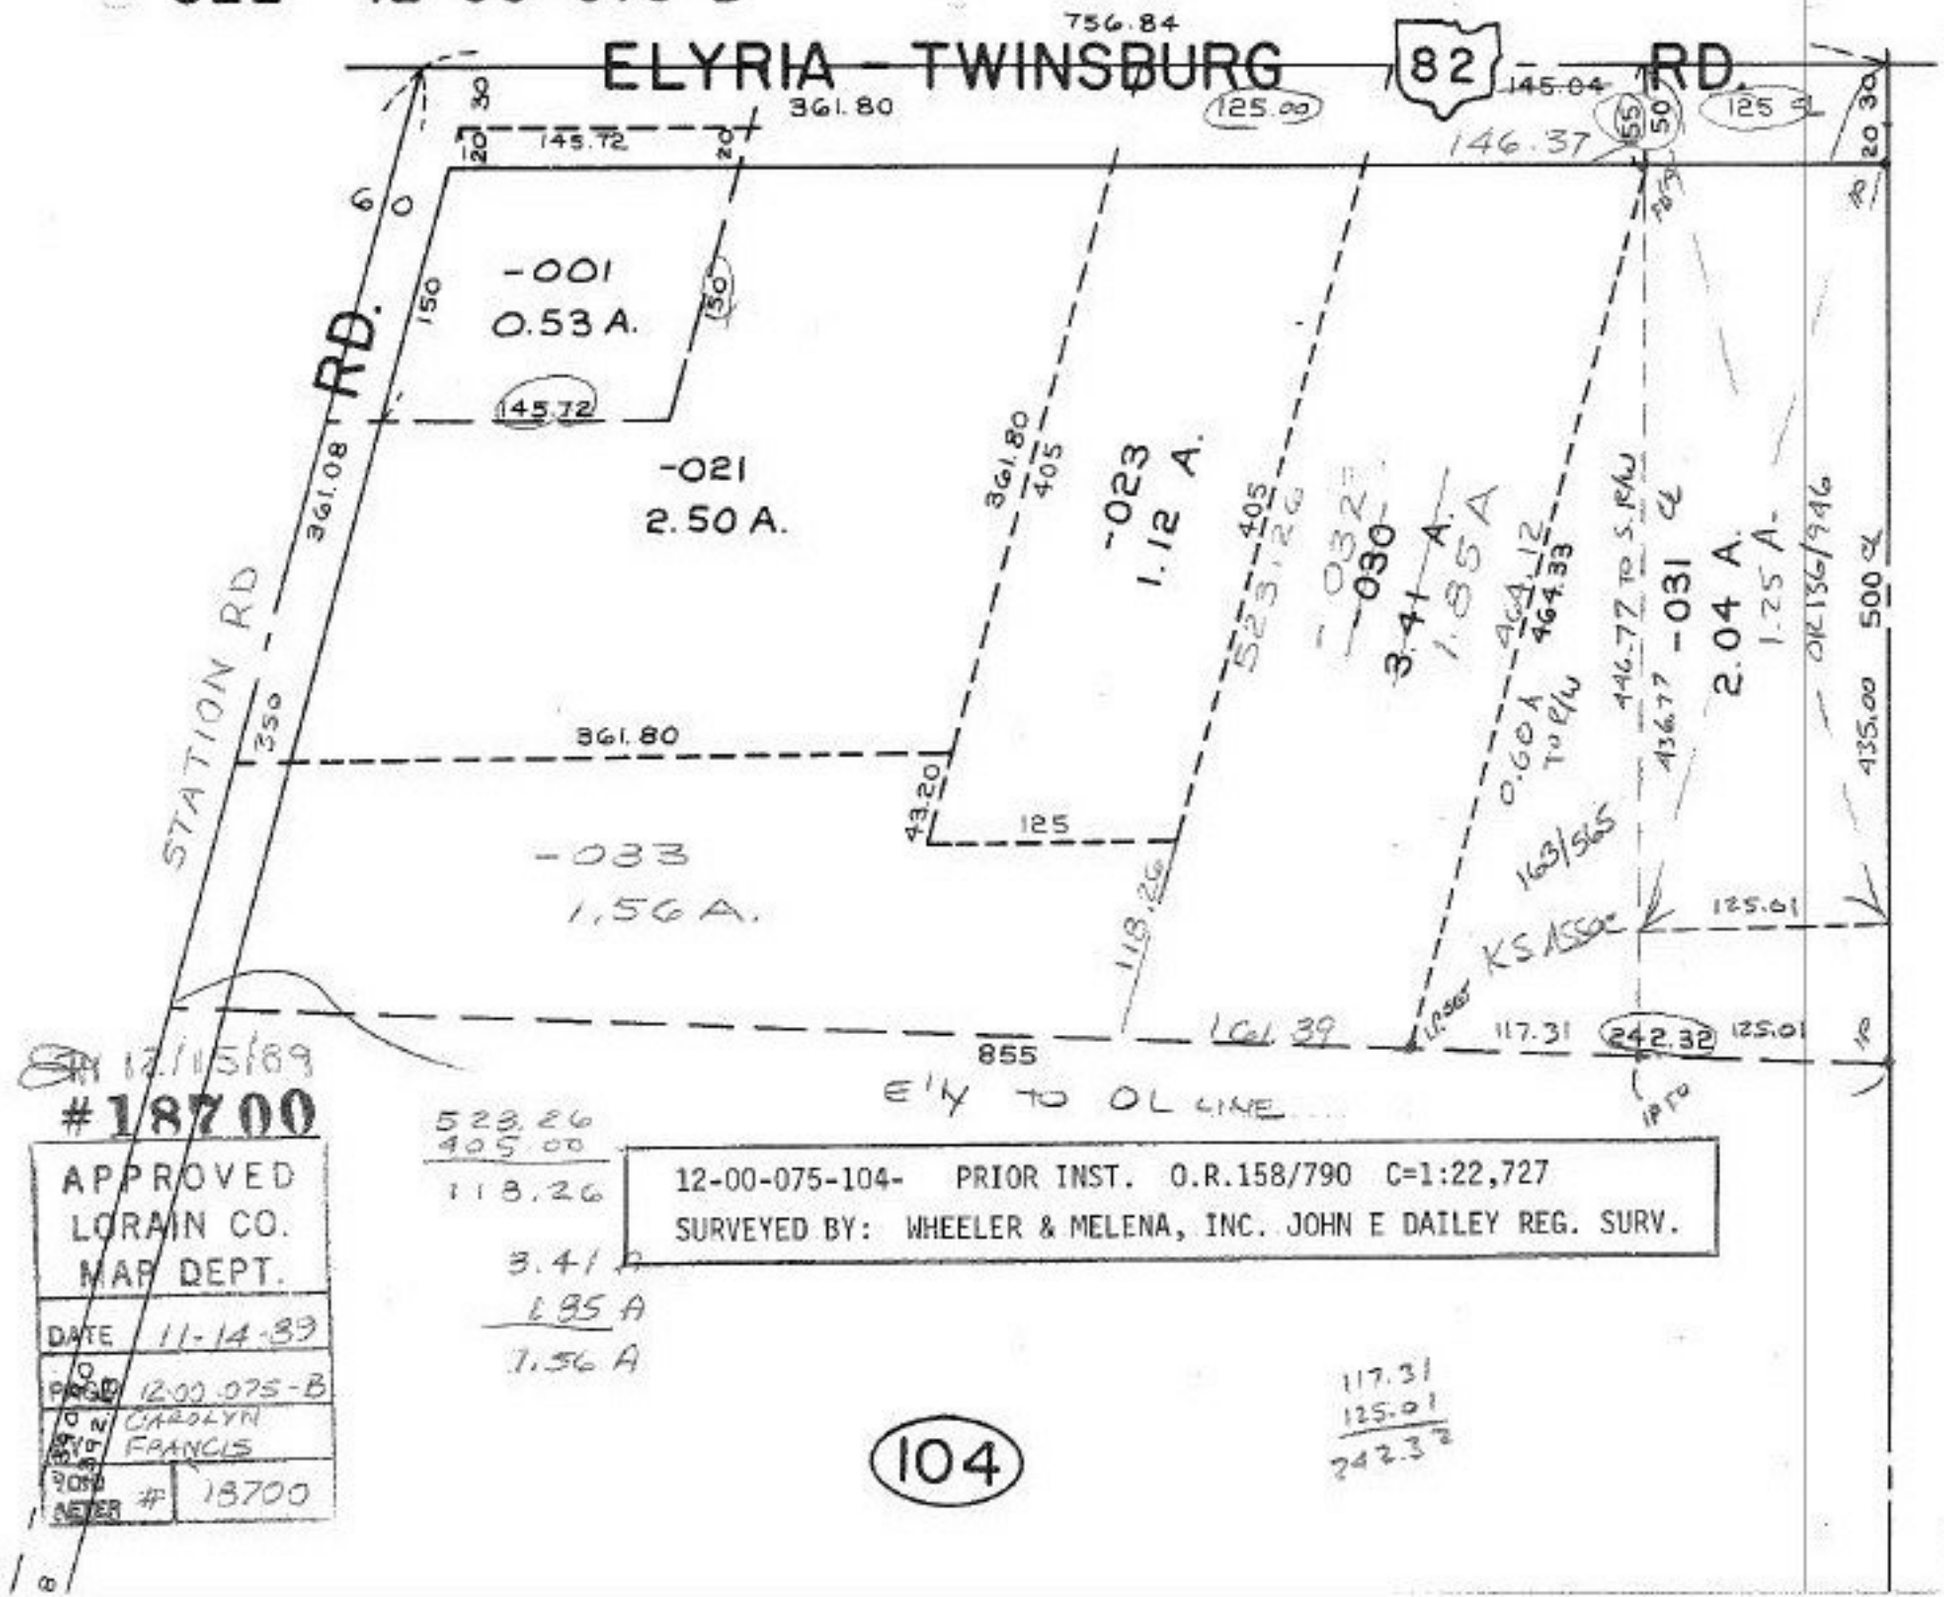

12-00-075-104- PRIOR INST. O.R.158/790 C=1:22,727
SURVEYED BY: WHEELER & MELENA, INC. JOHN E DAILEY REG. SURV.

104

12/15/89
#18700

APPROVED LORAIN CO. MAP DEPT.	
DATE	11-14-89
PROP ID	12-00-075-B
OWNER	CAROLYN FRANCIS
WATER METER #	18700