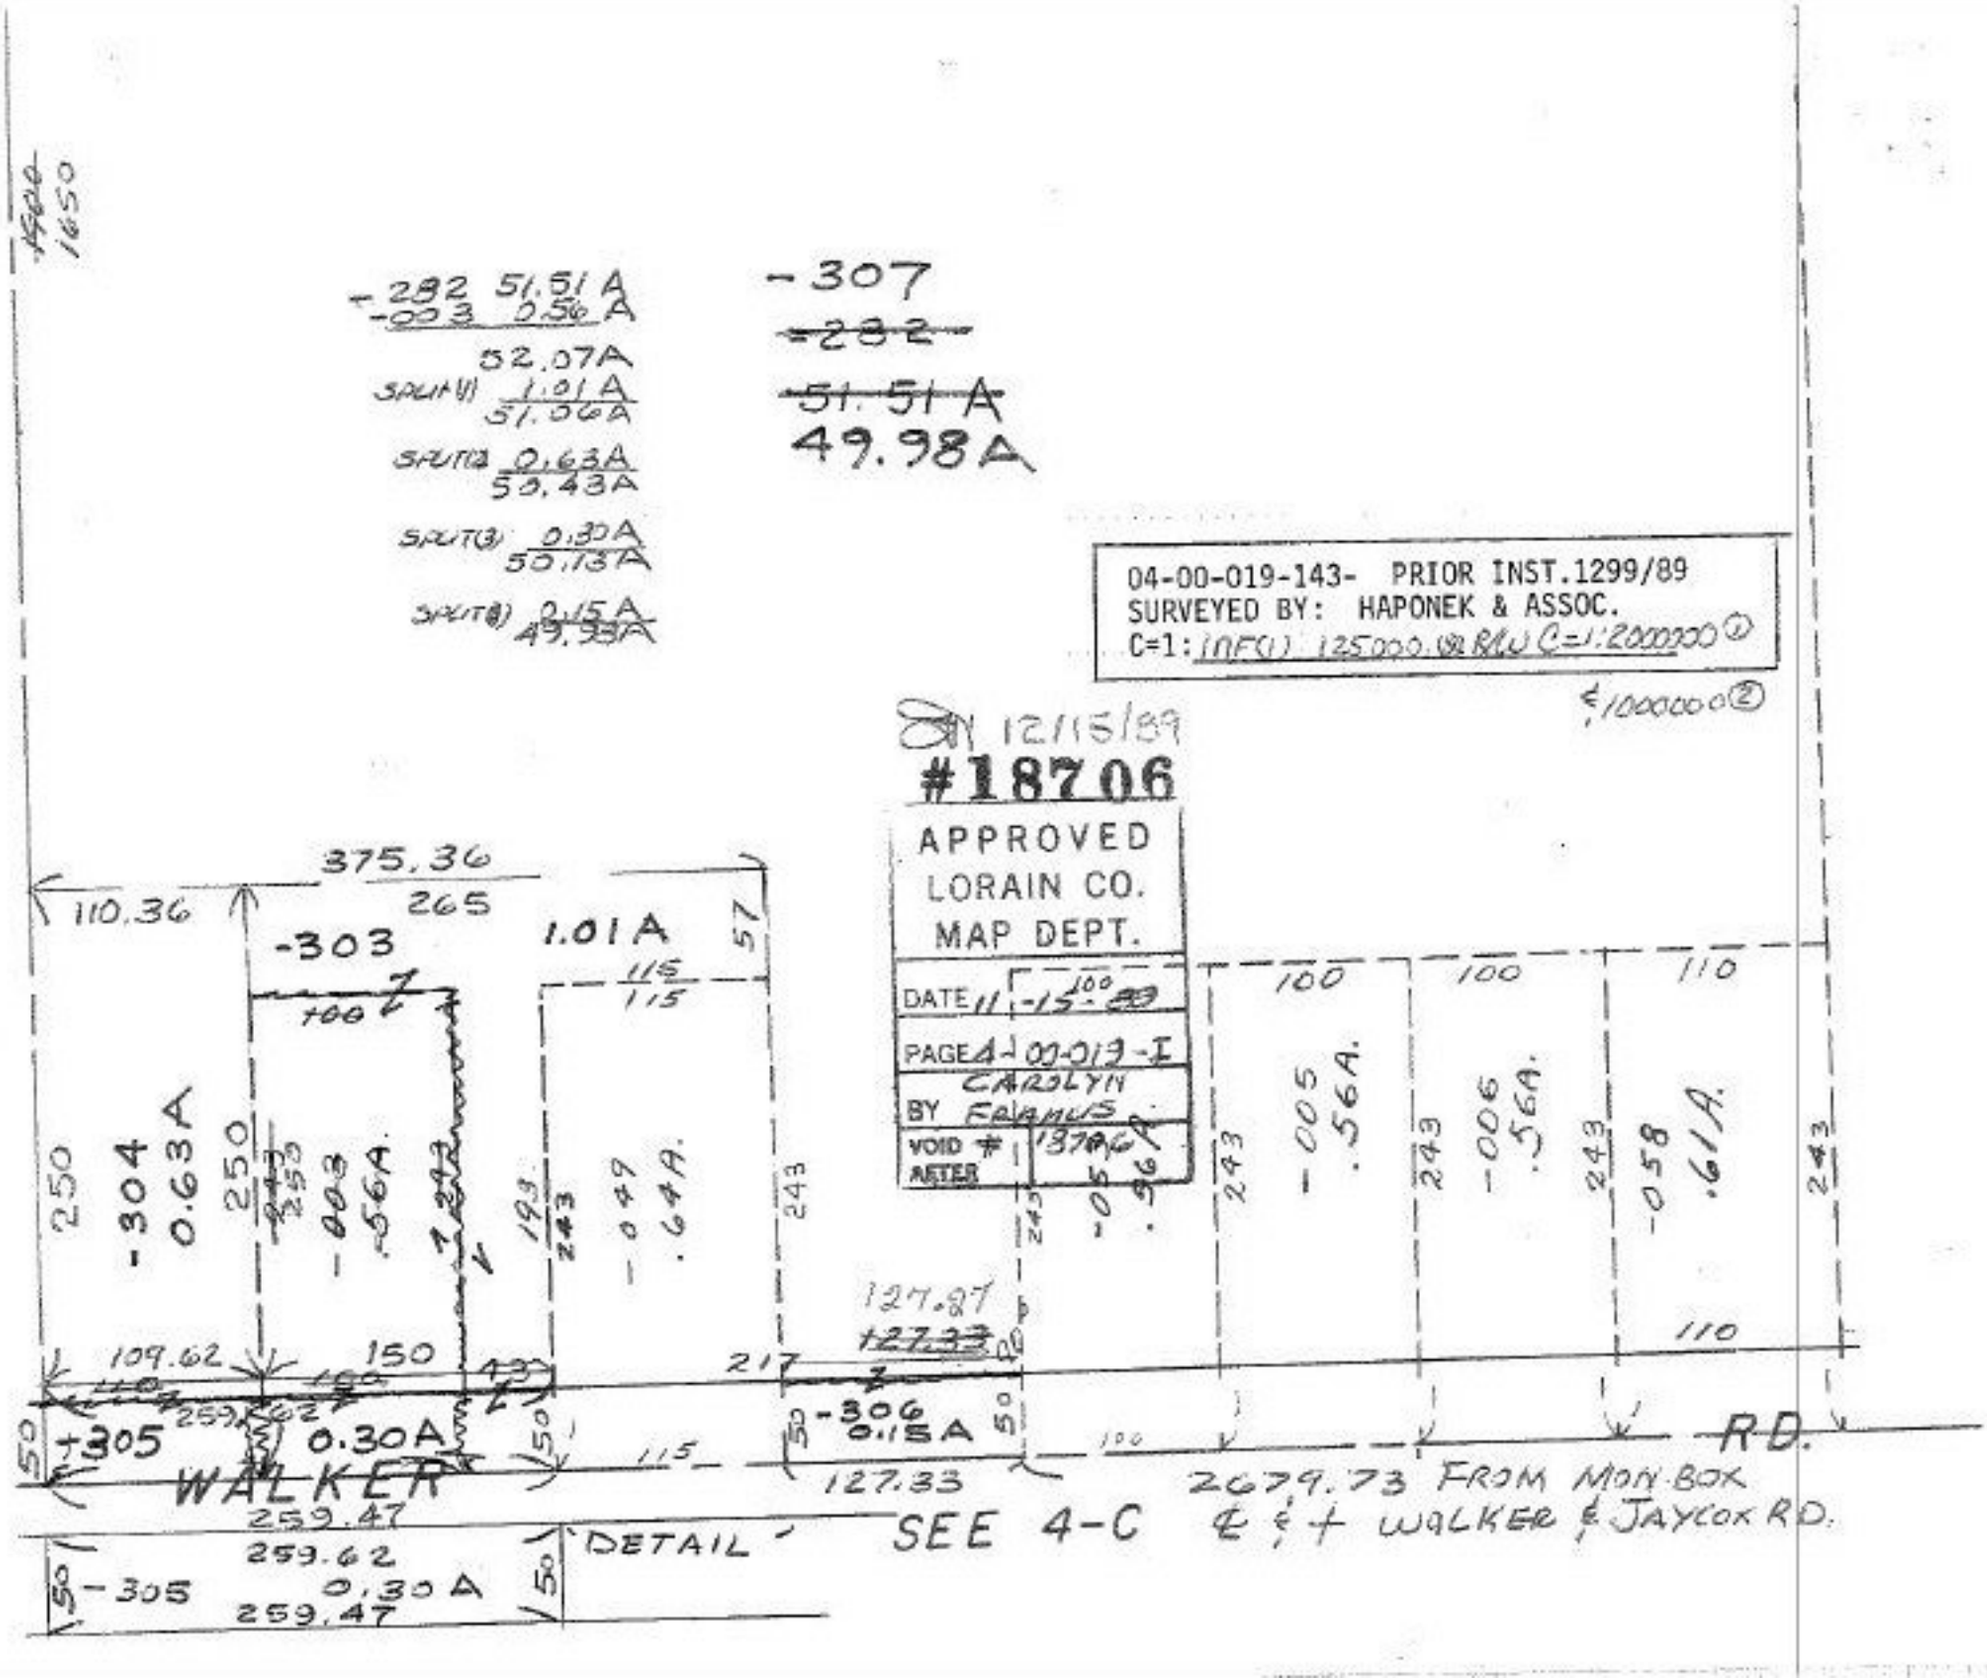
Page 1650
-292 51.51 A
-003 0.56 A
52.07A
SPLIT(1) 1.01 A
51.06A
SPLIT(2) 0.63A
50.43A
SPLIT(3) 0.30A
50.13A
SPLIT(4) 0.15A
49.98A
-307
-292
51.51 A
49.98A
04-00-019-143- PRIOR INST. 1299/89
SURVEYED BY: HAPONEK & ASSOC.
C=1: INFO 1:25000 OR RLU C=1:2000000 ①
≤1000000 ②
12/15/89
#18706
APPROVED
LORAIN CO.
MAP DEPT.
DATE 11-15-89
PAGE 4-00-019-I
BY CAROLYN FRANCIS
VOID # 1 AFTER 13706
375.36
110.36
265
-303
1.01A
115
115
57
100
-304
0.63A
250
250
-003
.56A.
1.242 A
198
243
-049
.64A.
243
-005
.56A.
-006
.56A.
-058
.61A.
100
100
110
243
243
243
243
127.87
127.33
109.62
150
217
110
110
259.62
+305
0.30A
WALKER
50
50
115
-306
0.15A
50
50
100
RD.
259.47
2079.73 FROM MON. BOX
SEE 4-C ℄ & ℄ WALKER & JAYCOX RD.
DETAIL
259.62
-305
0.30A
259.47
50
50