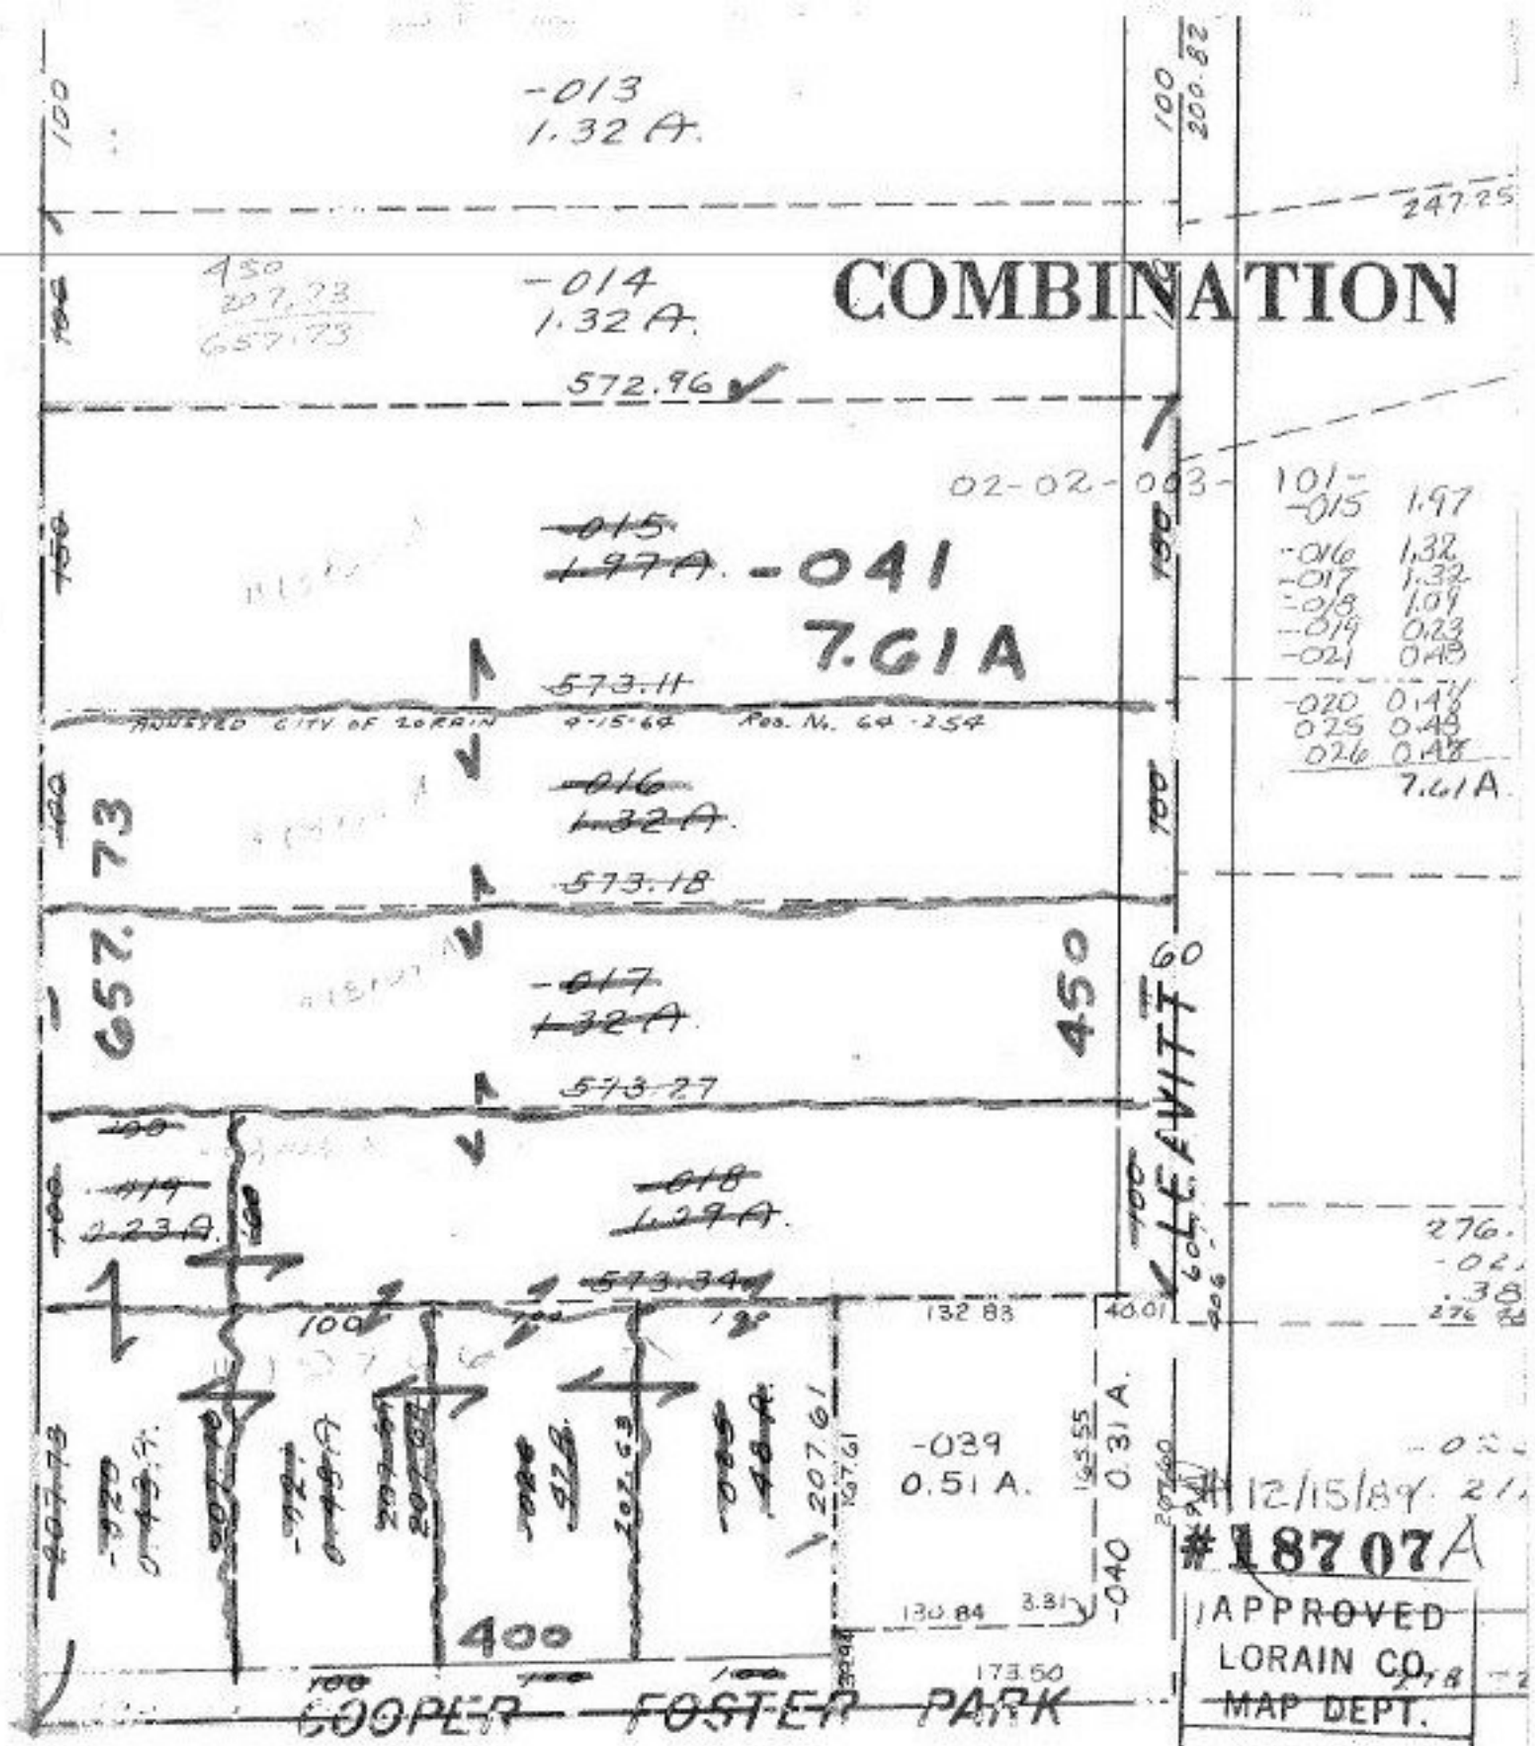
COMBINATION
-013
1.32 A.
-014
1.32 A.
572.96
-041
7.61A
573.11
573.18
573.27
573.34
-039
0.51 A.
-040
0.31 A.
132.83
130.84
173.50
207.61
202.63
400
450
COOPER FOSTER PARK
02-02-003
101-015 1.97
-016 1.32
-017 1.32
-018 1.09
-019 0.23
-021 0.48
-020 0.14
025 0.48
026 0.48
7.61A
#18707A
APPROVED
LORAIN CO.
MAP DEPT.
DATE 11-8-89
PAGE 2-02-003
BY FRANCIS
BLACK
SCALE 1" =