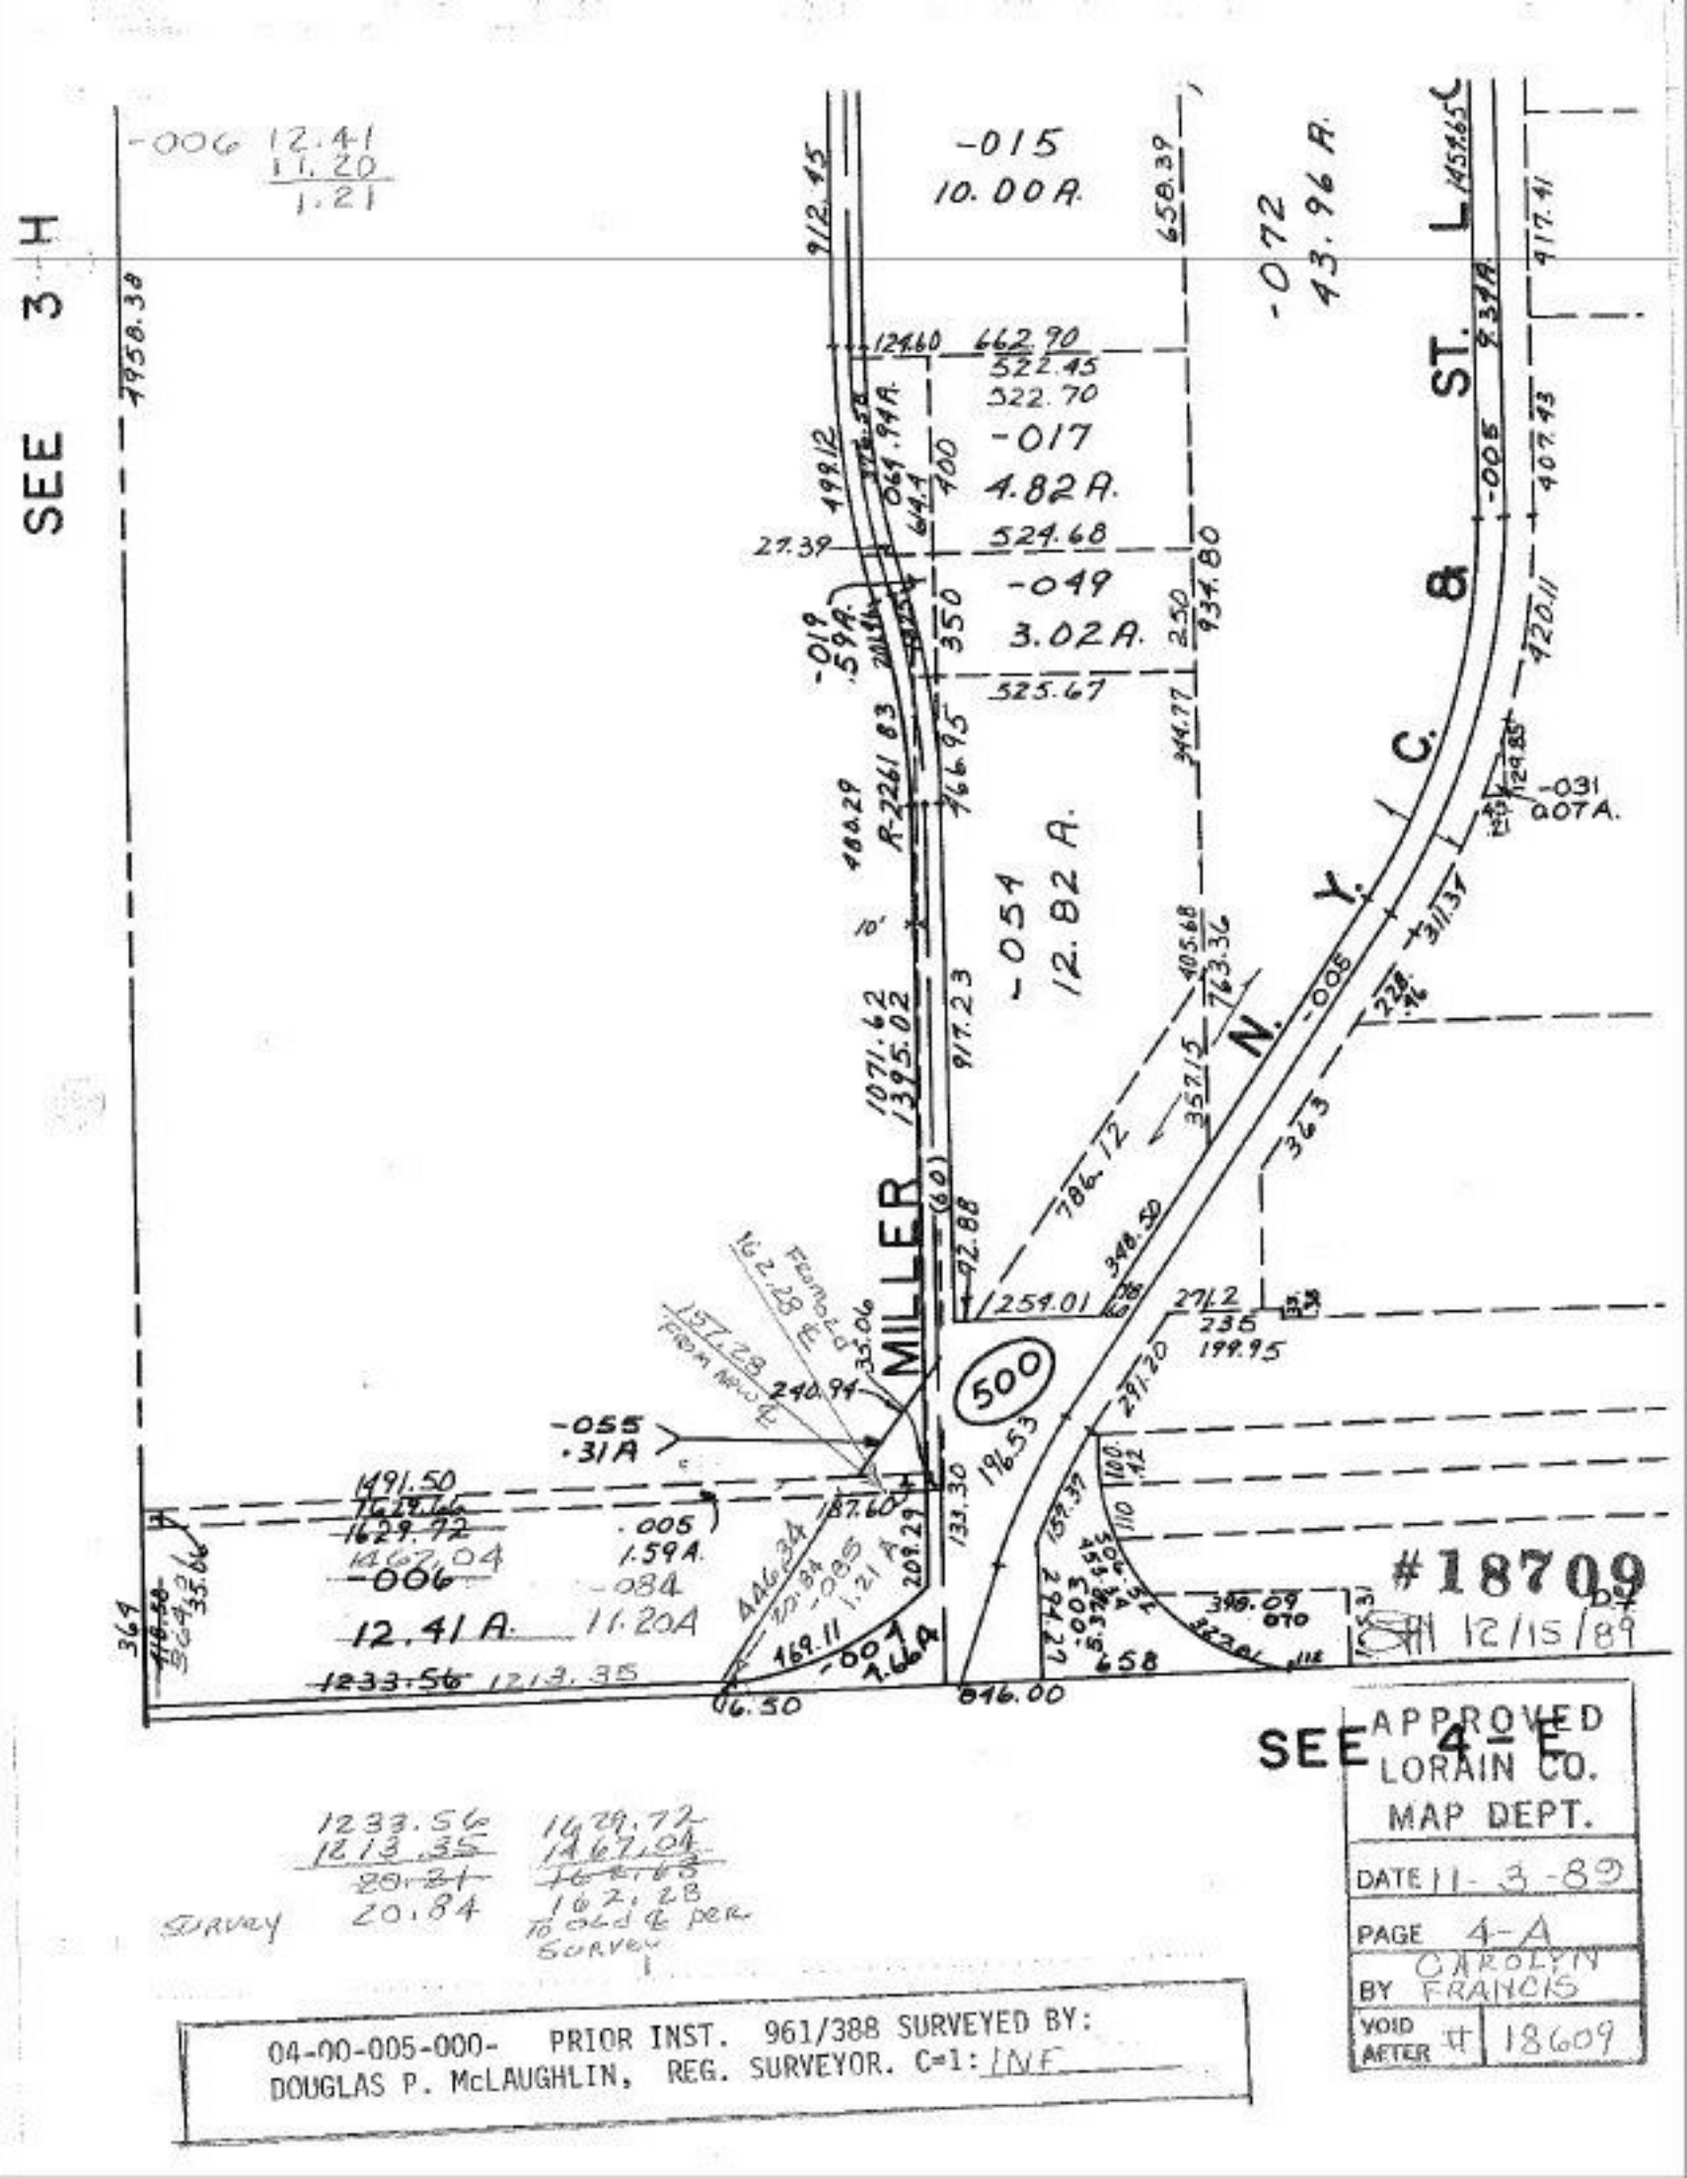
SEE 3 H
-006 12.41
11.20
1.21
-015
10.00A.
-072
43.96 A.
MILLER
N.
ST.
-017
4.82A.
-049
3.02A.
-019
.59A.
-054
12.82 A.
-031
.07A.
-055
.31A
-005
1.59A.
-084
11.20A
-006
12.41 A.
-085
1.21 A.
-007
7.66A
500
#18709
12/15/89
SEE 4 E
APPROVED
LORAIN CO.
MAP DEPT.
DATE 11-3-89
PAGE 4-A
BY CAROLYN FRANCIS
VOID AFTER # 18609
1233.56
1213.35
20.21
20.84
SURVEY
TO CALC & PER SURVEY
04-00-005-000- PRIOR INST. 961/388 SURVEYED BY:
DOUGLAS P. McLAUGHLIN, REG. SURVEYOR. C=1: INF