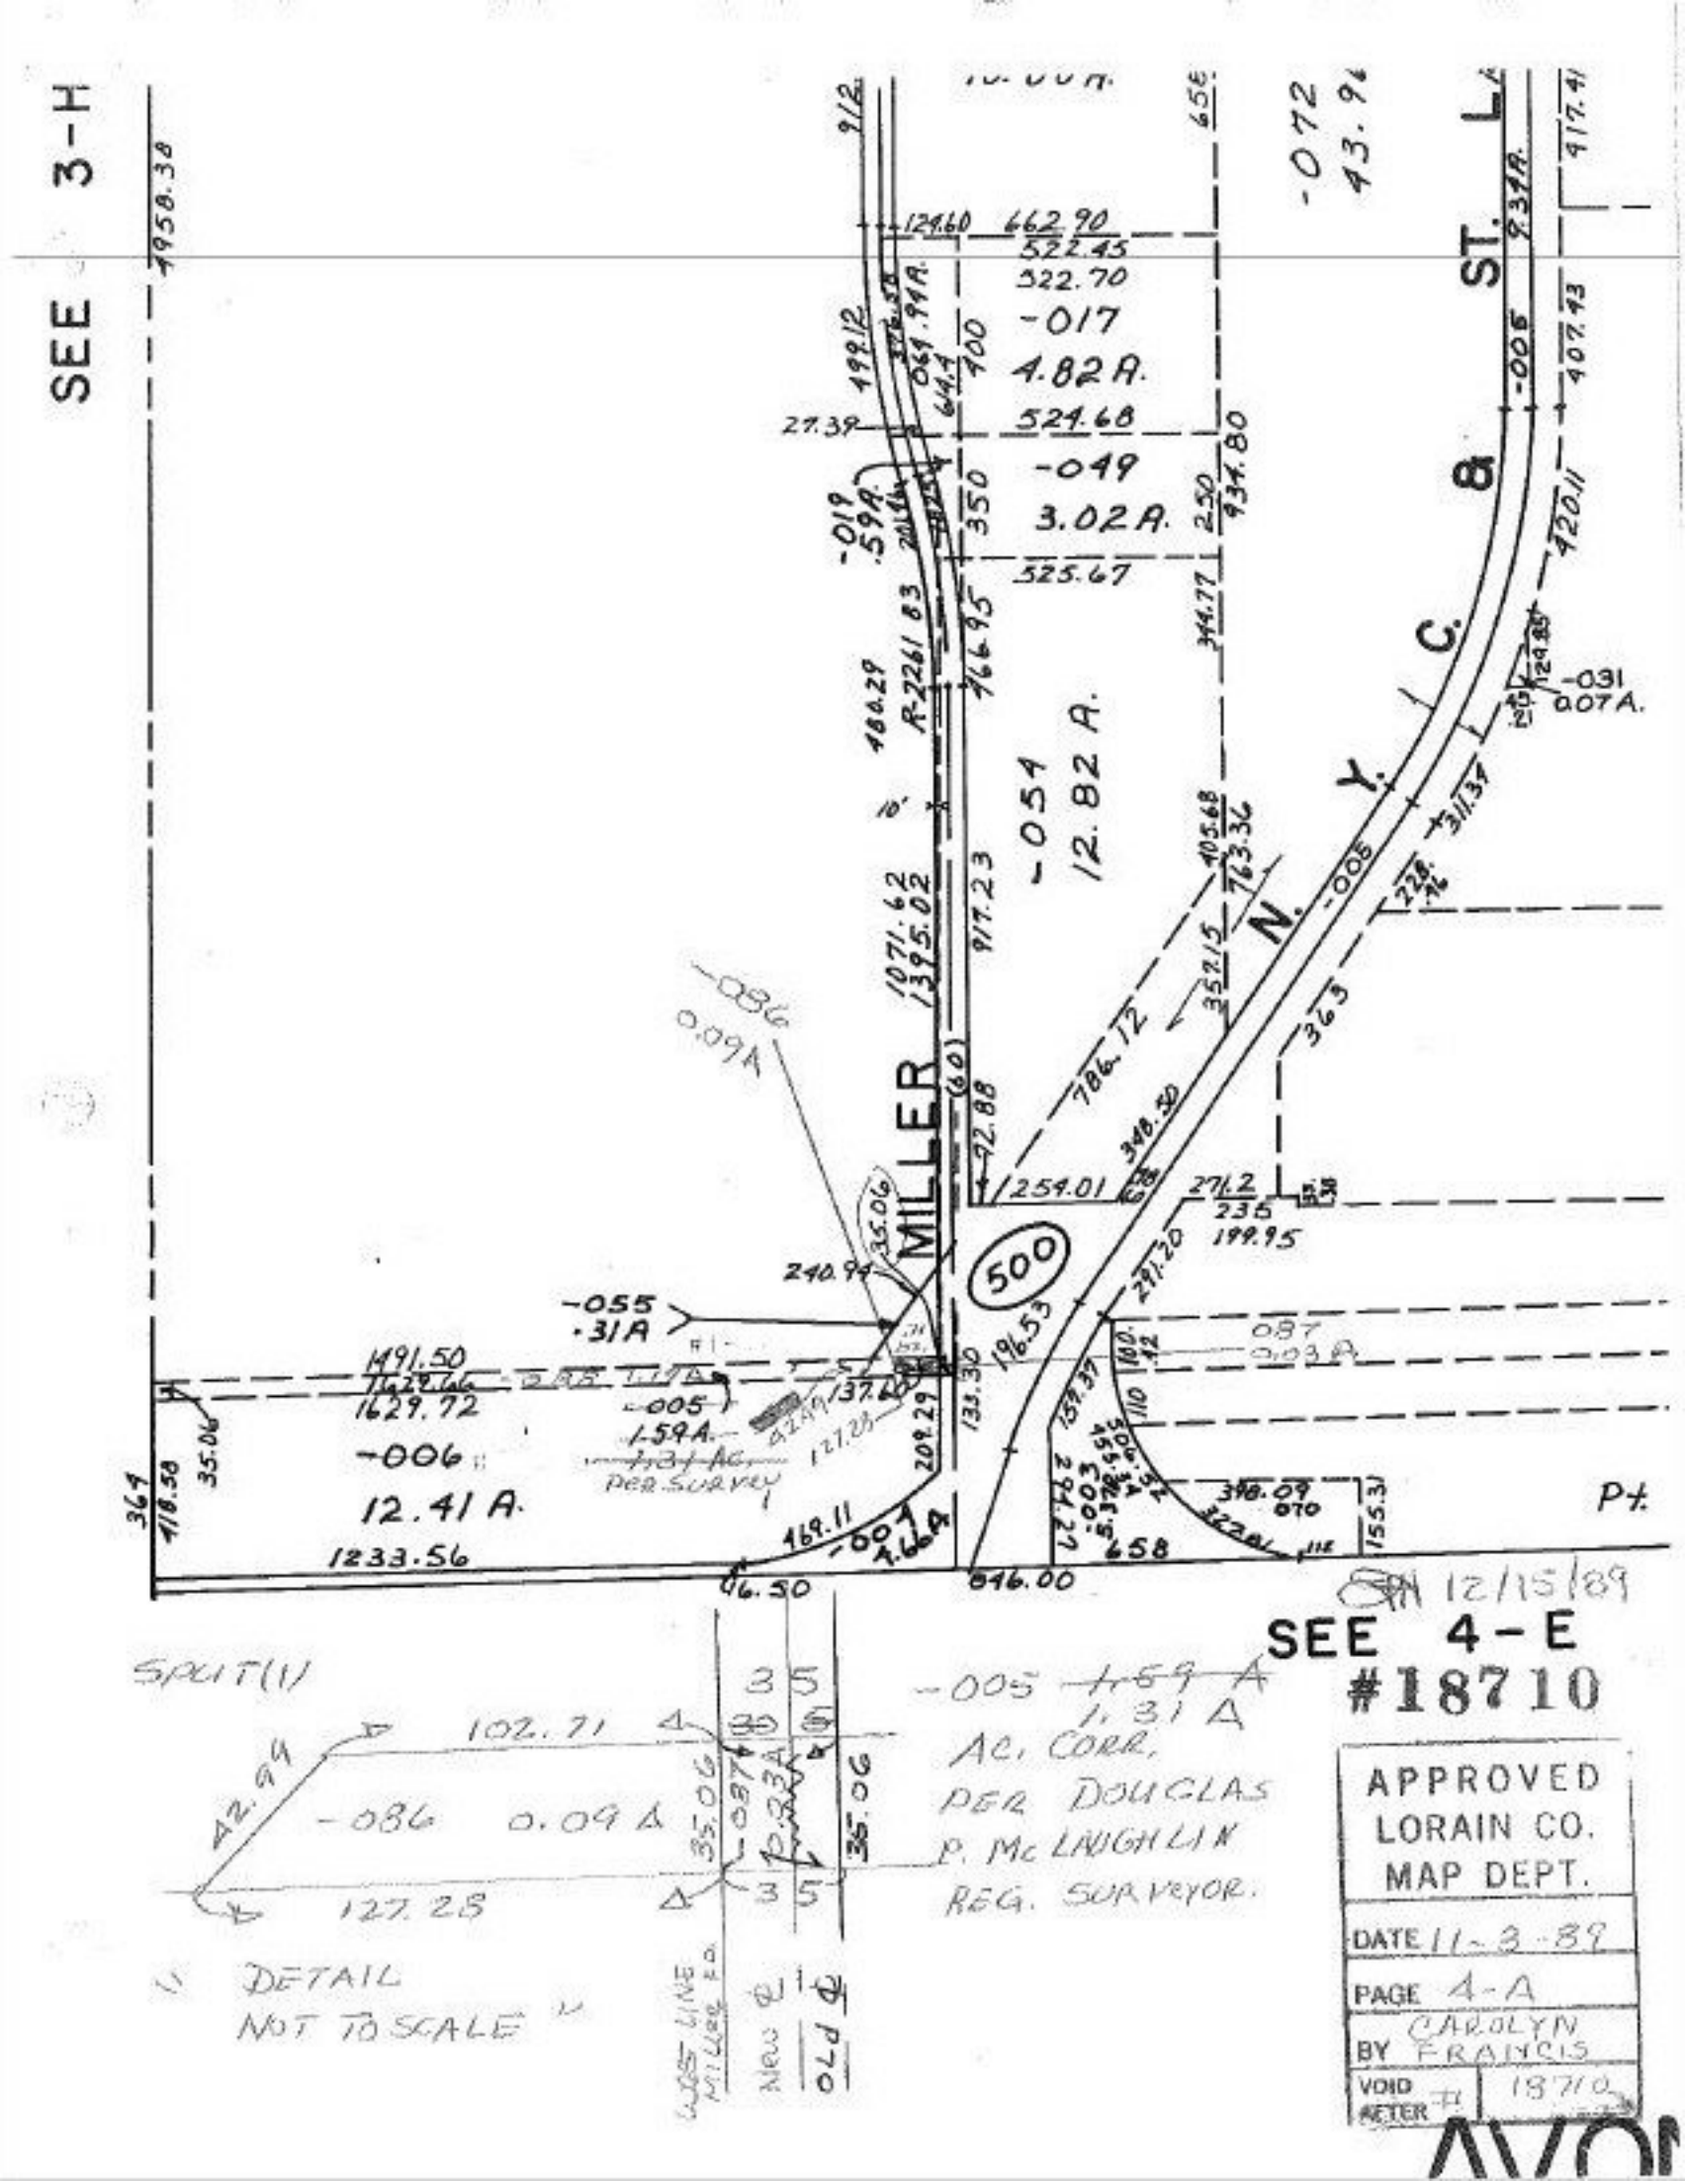
SEE 3-H
1958.30
129.60
662.90
522.45
322.70
-017
4.82 A.
524.68
-049
3.02 A.
525.67
-019
.594
-054
12.82 A.
MILLER
(60)
1071.62
1395.02
917.23
R-2261.83
184.29
786.72
352.15
105.68
763.36
N. Y. C. & ST. L.
-005
-006
-031
0.07 A.
-086
0.09 A
-055
.31 A
1491.50
1629.72
-005
1.59 A.
1.31 Ac.
Per Survey
-006
12.41 A.
1233.56
1259.01
92.88
348.50
271.2
235
199.95
271.20
240.94
35.06
500
18.53
133.30
209.29
169.11
-007
1.64 A
46.50
846.00
364
418.58
35.06
SEE 4-E
#18710
SPLIT (1)
102.71
42.99
-086 0.09 A
127.25
35.06
-087
0.23 A
-005 1.59 A
1.31 A
AC. CORR.
PER DOUGLAS
P. McLAUGHLIN
REG. SURVEYOR.
(1) DETAIL
NOT TO SCALE
WEST LINE
MILLER E.A.
NEW
OLD
APPROVED
LORAIN CO.
MAP DEPT.
DATE 11-3-89
PAGE 4-A
BY CAROLYN
FRANCIS
VOID
AFTER #
18710