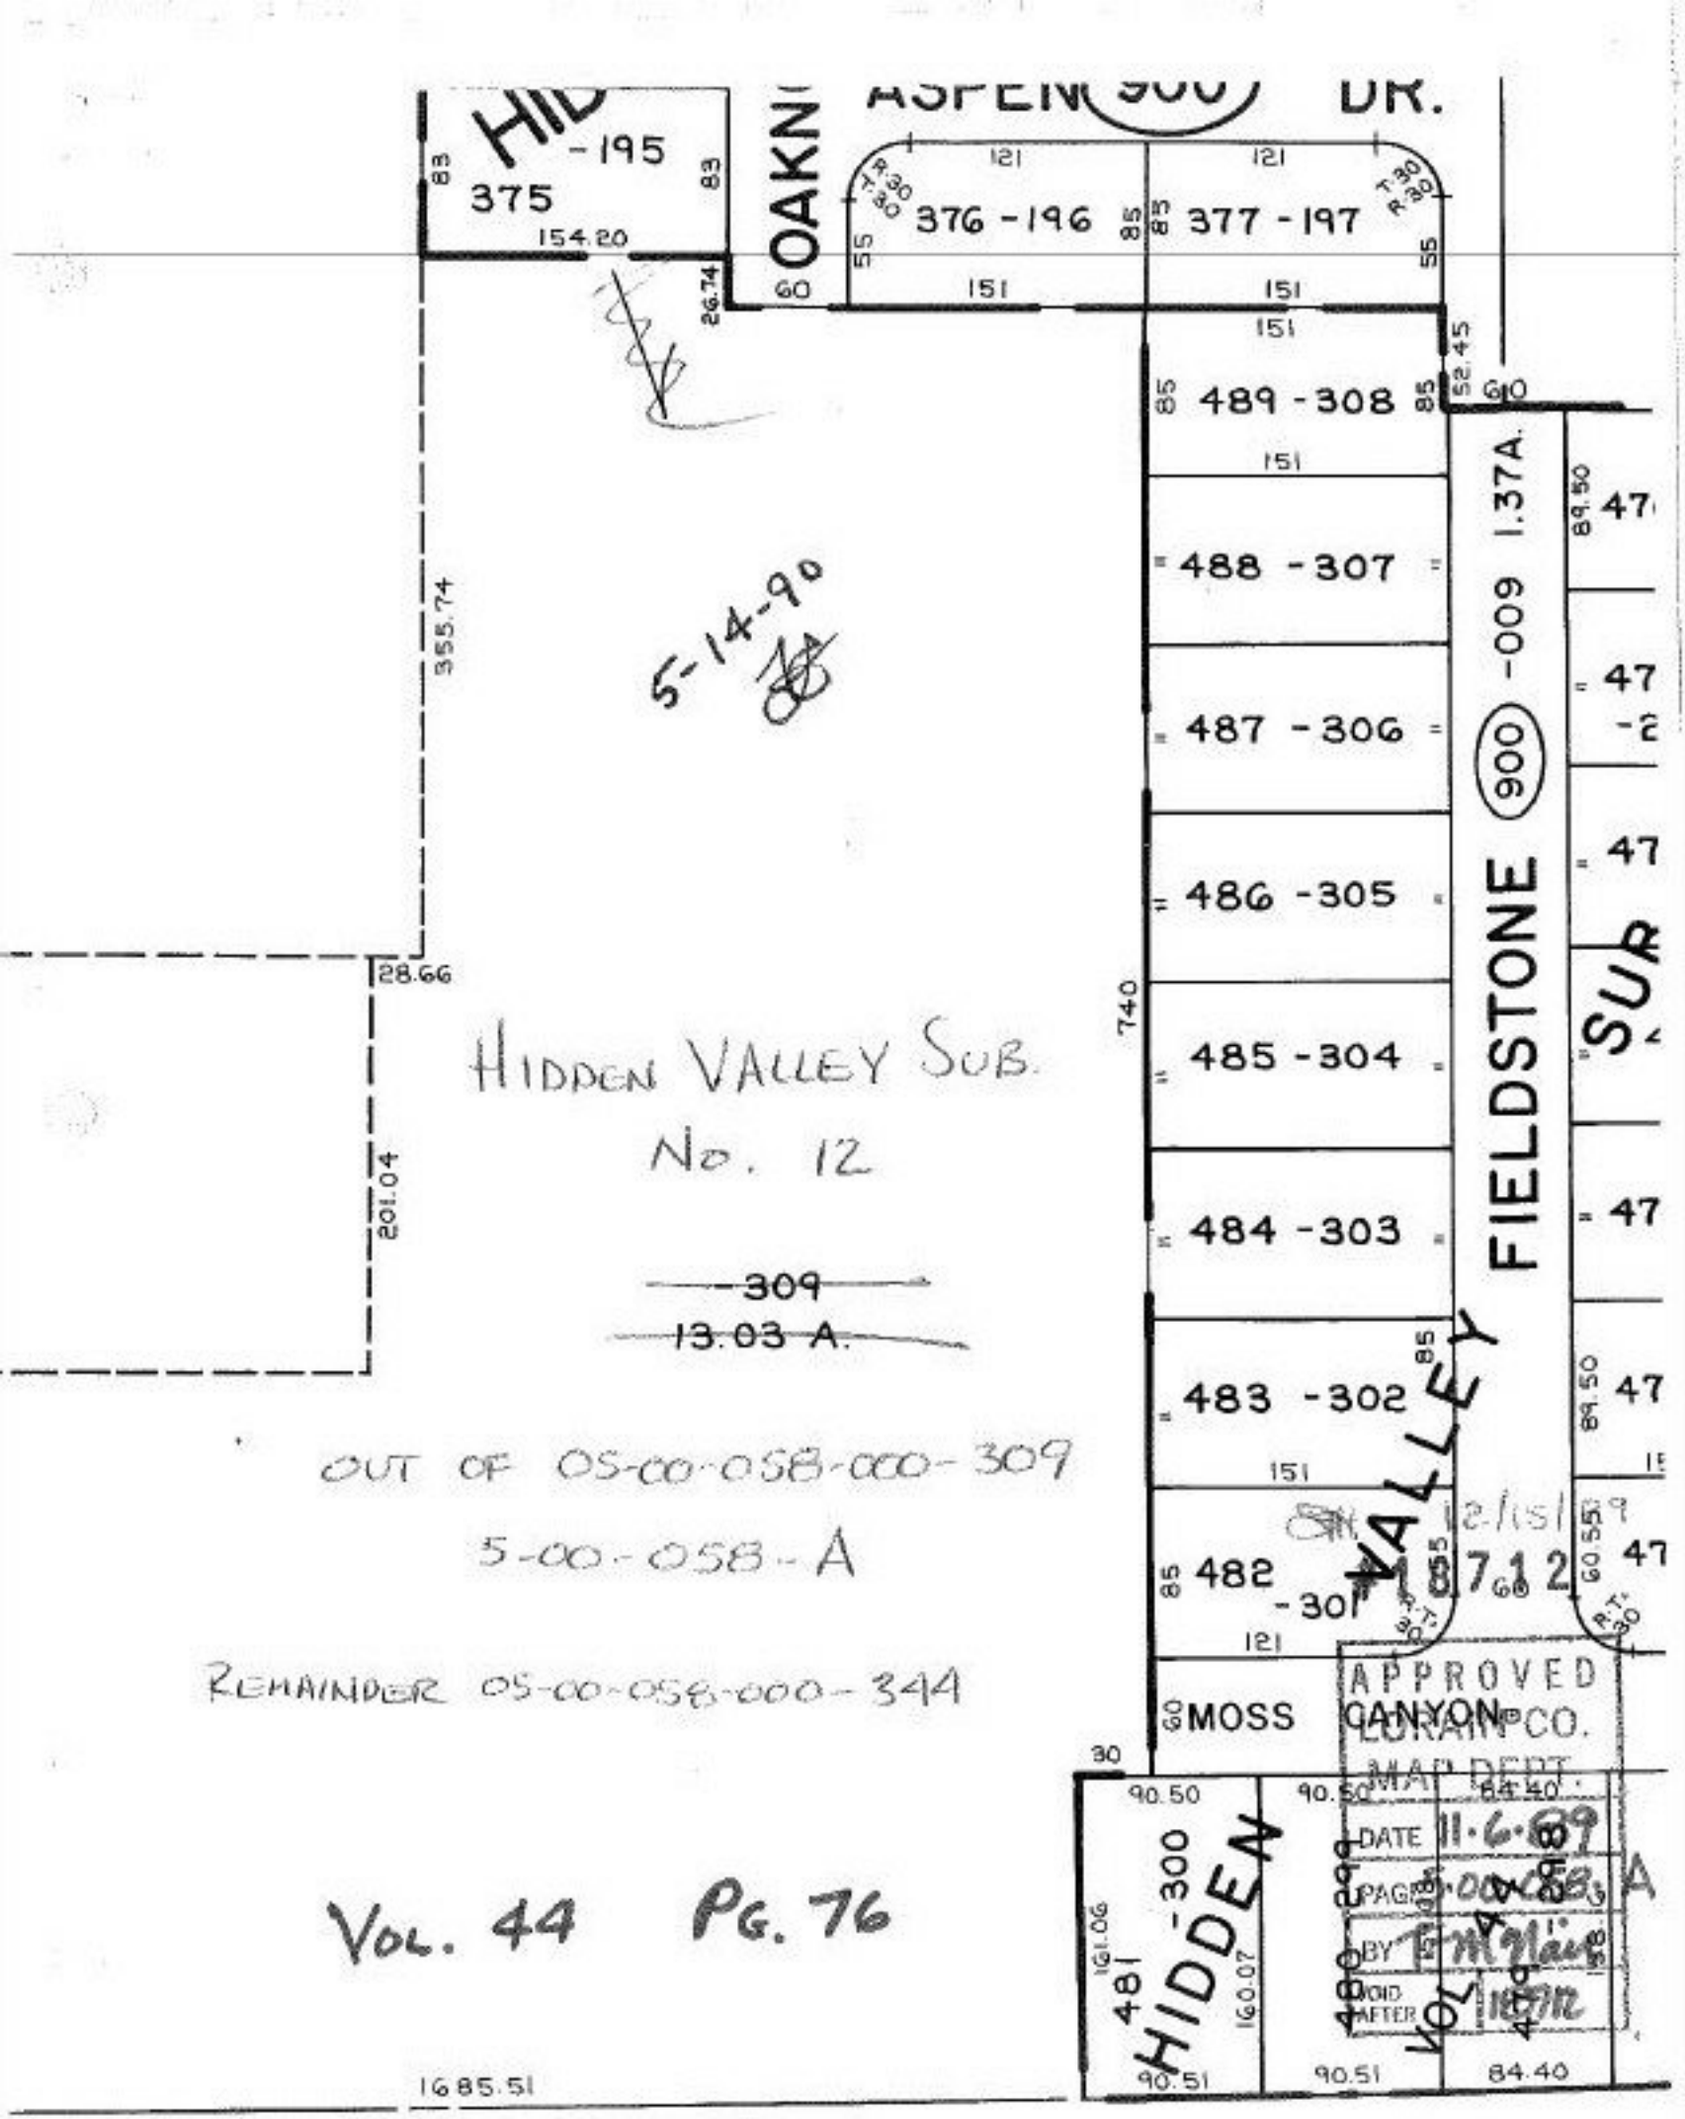
ASPEN
DR.
OAKN
375
376 - 196
377 - 197
489 - 308
488 - 307
487 - 306
486 - 305
485 - 304
484 - 303
483 - 302
482 - 301
FIELDSTONE
900
-009
1.37A.
VALLEY
HIDDEN
-300
MOSS CANYON
APPROVED
LORAIN CO.
MAP DEPT.
DATE 11-6-89
VOL. 44 PG. 76
5-14-90
HIDDEN VALLEY SUB.
No. 12
-309
13.03 A.
OUT OF 05-00-058-000-309
5-00-058-A
REMAINDER 05-00-058-000-344
355.74
28.66
201.04
740
1685.51