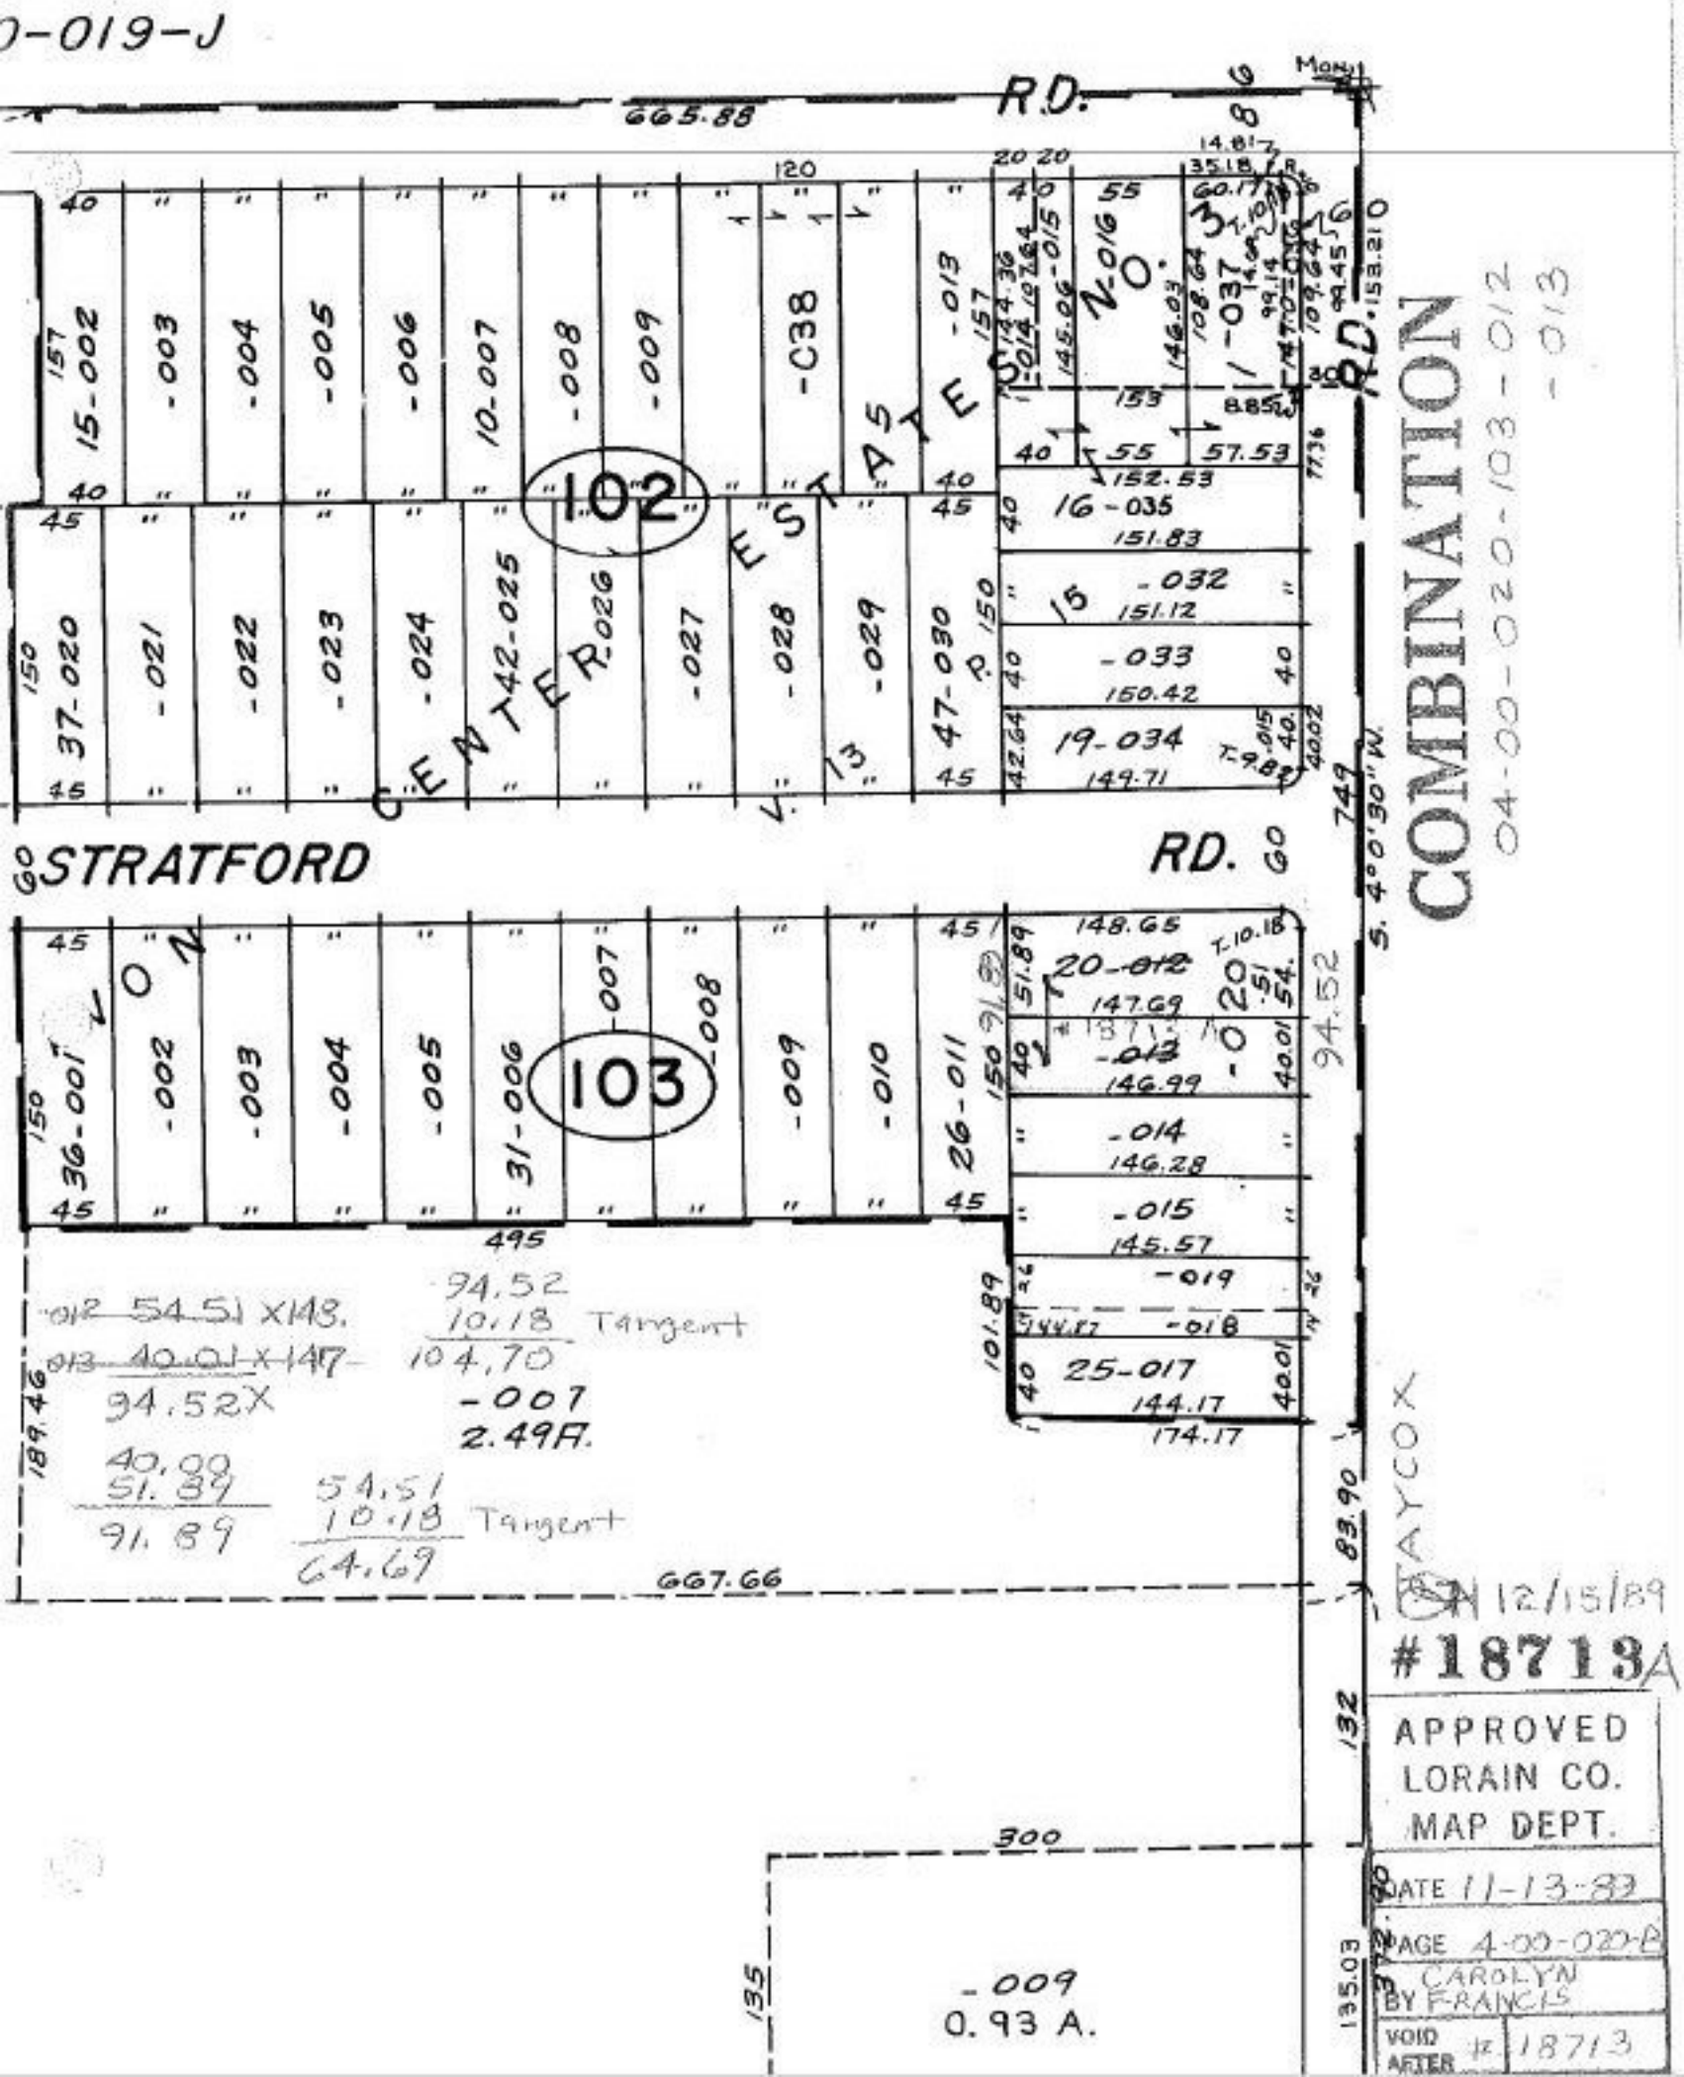

0-019-J
RD.
665.88
STRATFORD
RD.
102
103
CENTER ESTATES NO. 3
VON
15-002
-003
-004
-005
-006
10-007
-008
-009
-C38
-013
37-020
-021
-022
-023
-024
42-025
-026
-027
-028
-029
47-030
36-001
-002
-003
-004
-005
31-006
-007
-008
-009
-010
26-011
16-035
151.83
-032
151.12
-033
150.42
19-034
149.71
20-012
147.69
-013
146.99
-014
146.28
-015
145.57
-019
-018
25-017
144.17
174.17
-012 54.51 X148.
-013 40.01 X147
94.52X
40.00
51.89
91.89
94.52
10.18 Tangent
104.70
-007
2.49A.
54.51
10.18 Tangent
64.69
667.66
-009
0.93 A.
COMBINATION
04-00-020-103-012
-013
S. 4°0'30" W.
TAYCOX
12/15/89
#18713A
APPROVED
LORAIN CO.
MAP DEPT.
DATE 11-13-89
PAGE 4-00-020-B
BY CAROLYN FRANCIS
VOID AFTER # 18713