


SEE SKETCH # 1890

1764

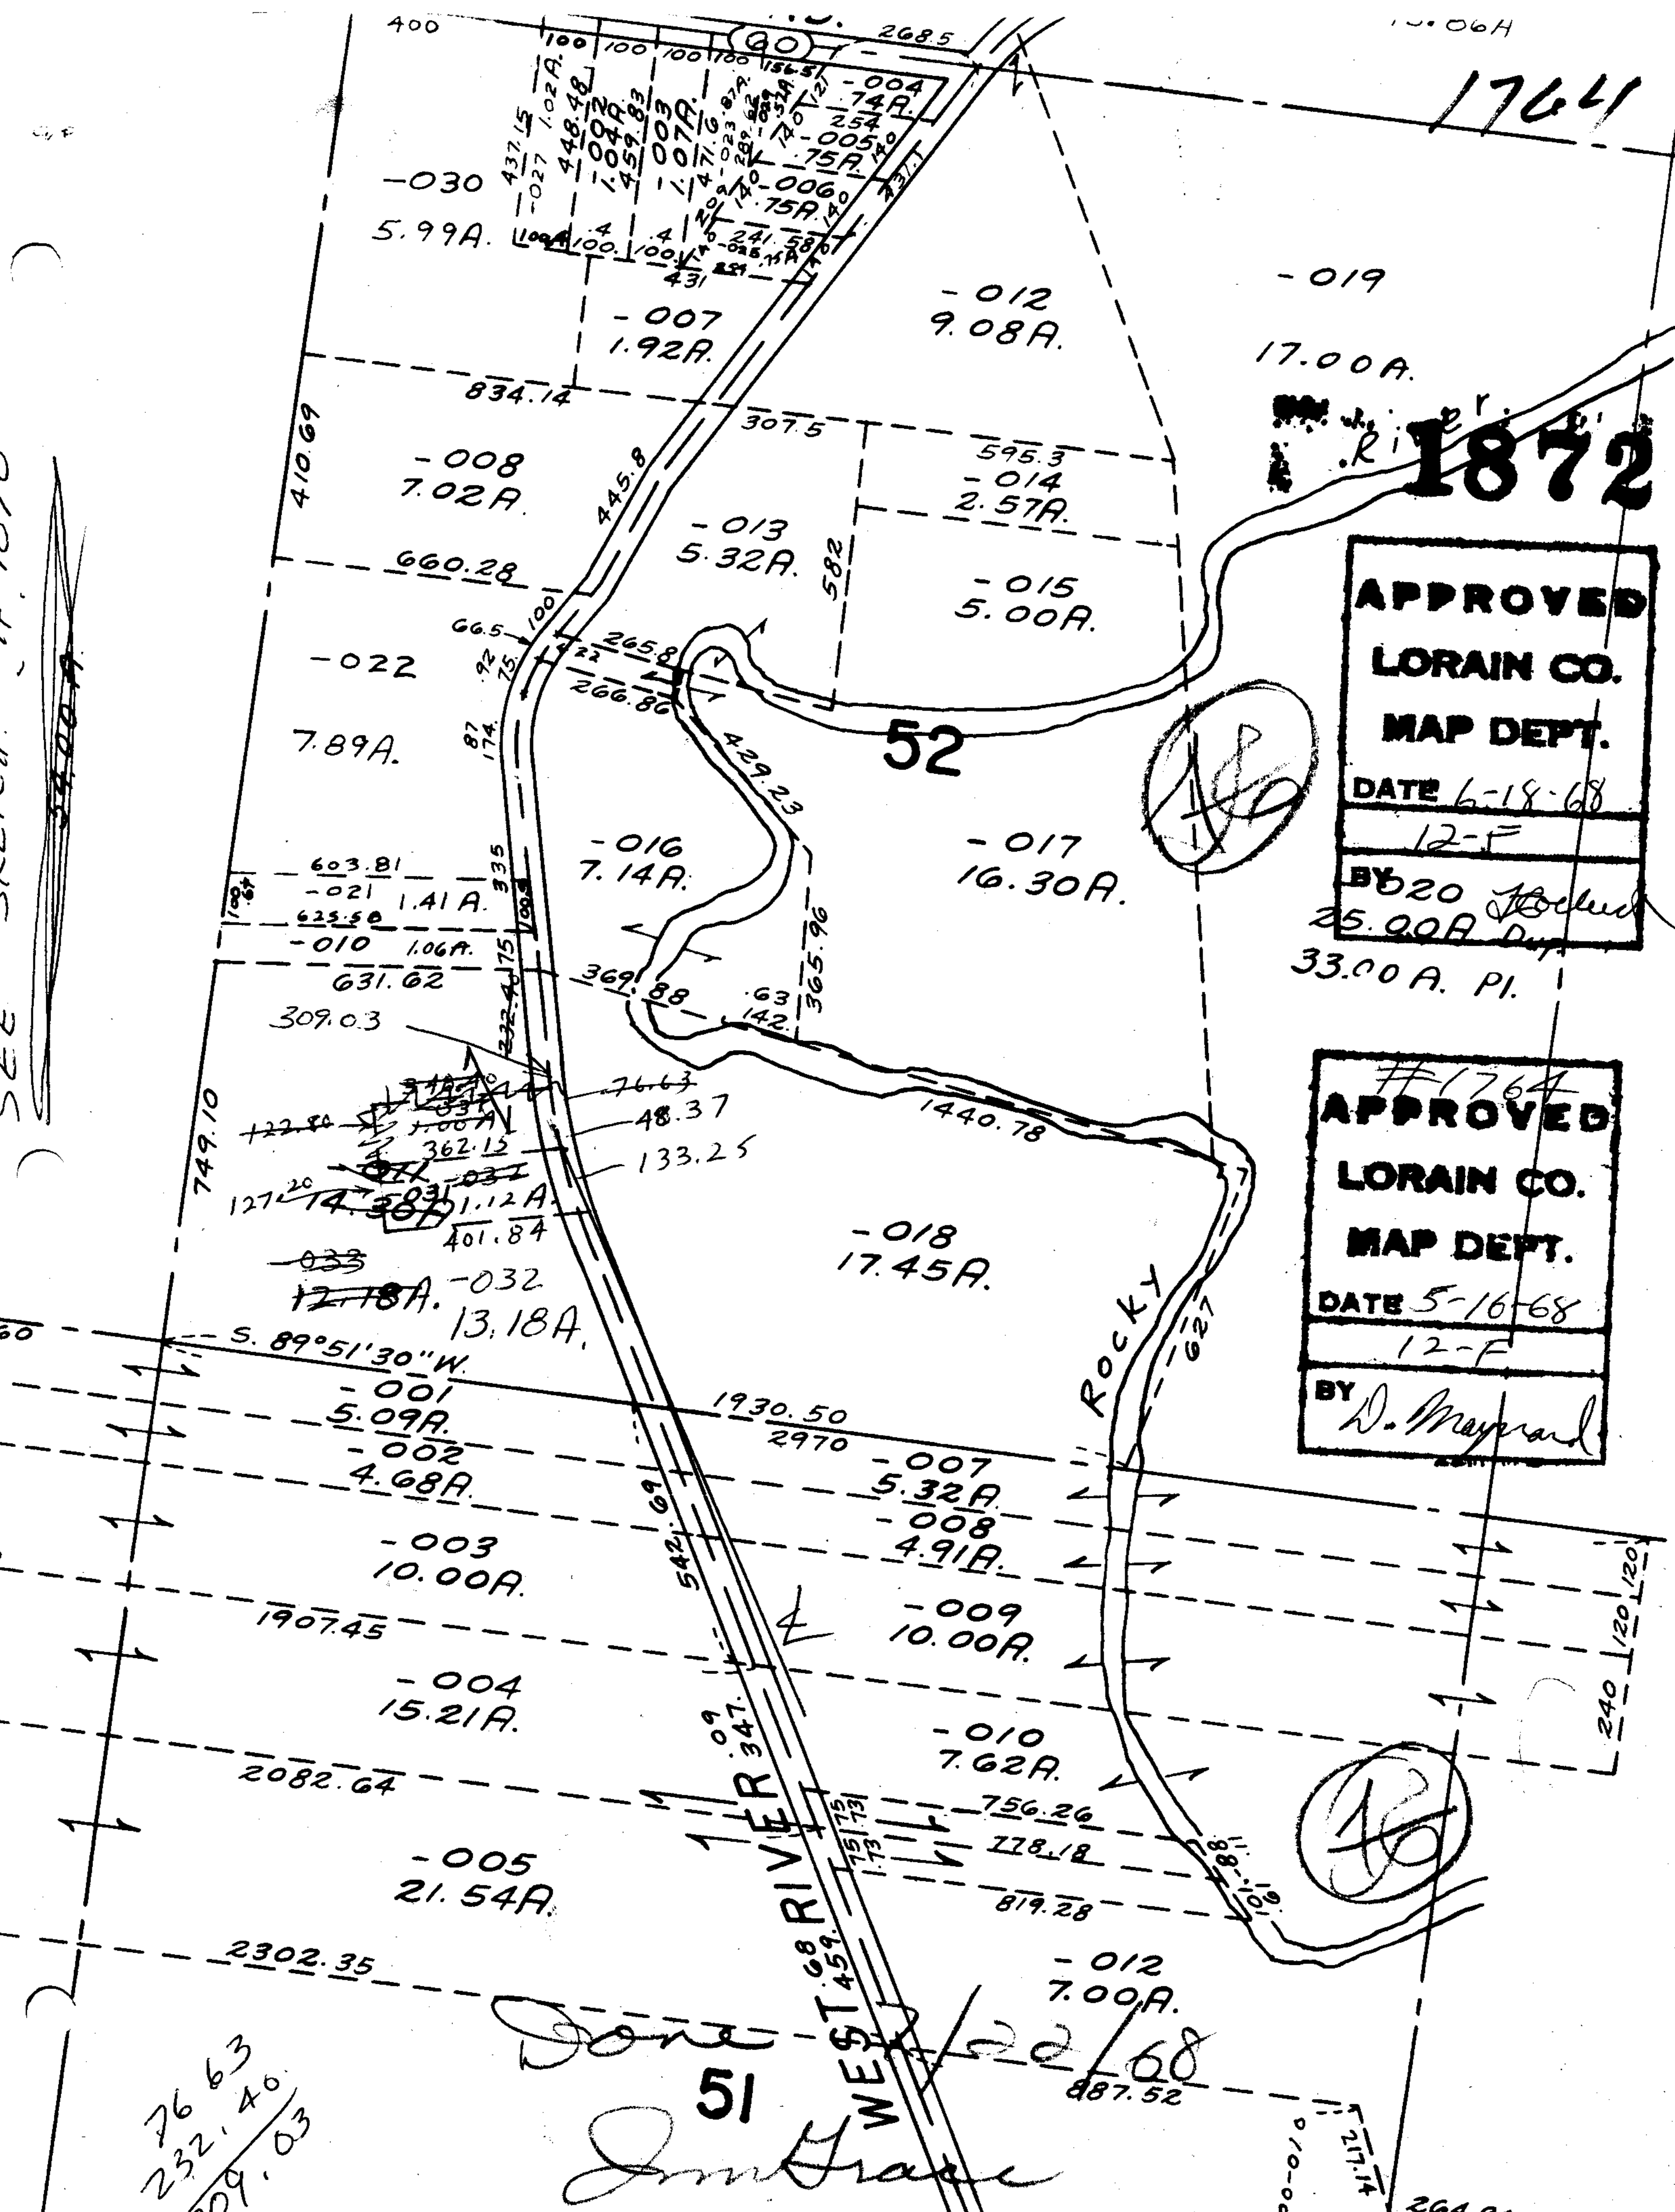

APPROVED
LORAIN CO.
MAP DEPT.
 DATE 6-18-68
 12-F
 BY 20 *[Signature]*
 25.00A
 33.00 A. PI.

#1764
APPROVED
LORAIN CO.
MAP DEPT.
 DATE 5-16-68
 12-F
 BY *D. Maynard*

76.63
 232.40
 309.03

51
West
22/68
887.52
Int Trace

264.94