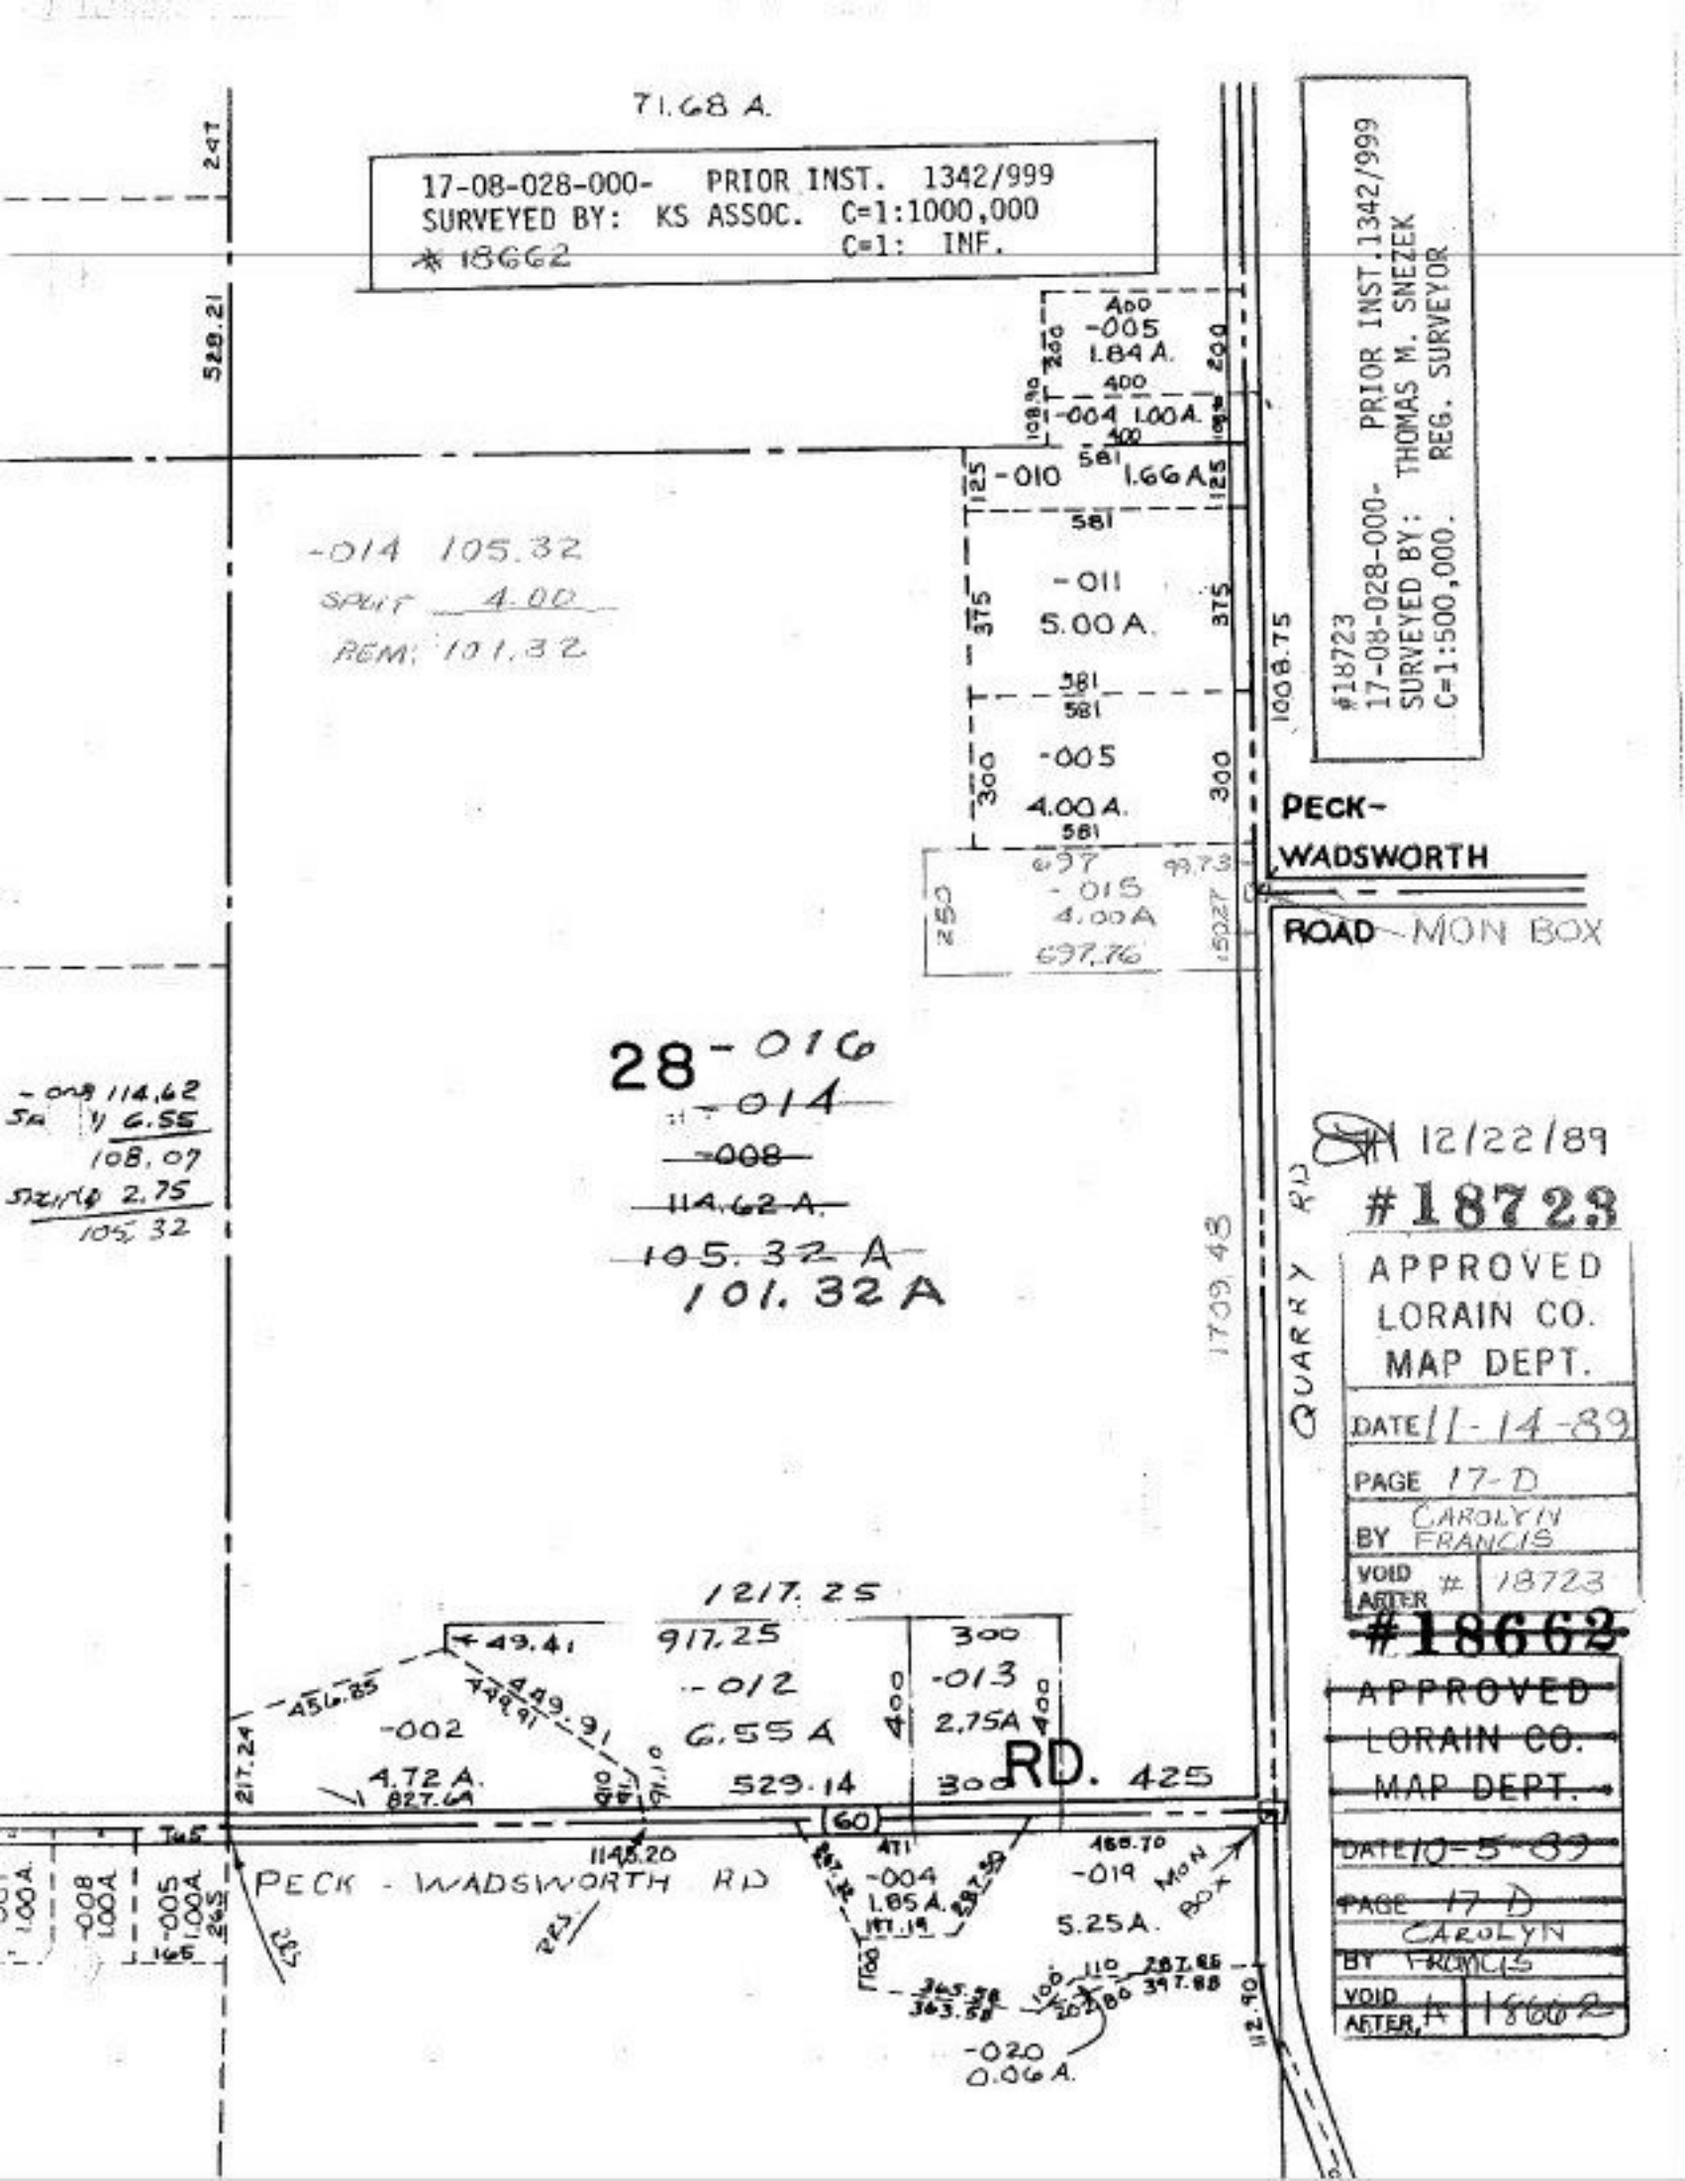
71.68 A.
17-08-028-000- PRIOR INST. 1342/999
SURVEYED BY: KS ASSOC. C=1:1000,000
C=1: INF.
* 18662
#18723
17-08-028-000- PRIOR INST. 1342/999
SURVEYED BY: THOMAS M. SNEZEK
C=1:500,000. REG. SURVEYOR
-005 1.84 A.
-004 1.00 A.
-010 1.66 A.
-011 5.00 A.
-005 4.00 A.
-015 4.00 A
-014 105.32
SPLIT 4.00
REM: 101.32
PECK-
WADSWORTH
ROAD
MON BOX
28-016
-014
-008
114.62 A.
105.32 A
101.32 A
-009 114.62
SPLIT 6.55
108.07
SPLIT 2.75
105.32
12/22/89
#18723
APPROVED
LORAIN CO.
MAP DEPT.
DATE 11-14-89
PAGE 17-D
BY CAROLYN FRANCIS
VOID AFTER # 18723
#18662
APPROVED
LORAIN CO.
MAP DEPT.
DATE 10-5-89
PAGE 17 D
BY CAROLYN FRANCIS
VOID AFTER # 18662
QUARRY RD
RD. 425
PECK - WADSWORTH RD
-002 4.72 A.
-012 6.55 A
-013 2.75A
-004 1.85 A.
-019
5.25A.
-020 0.06 A.
1217.25
917.25
529.14
1709.43
1008.75