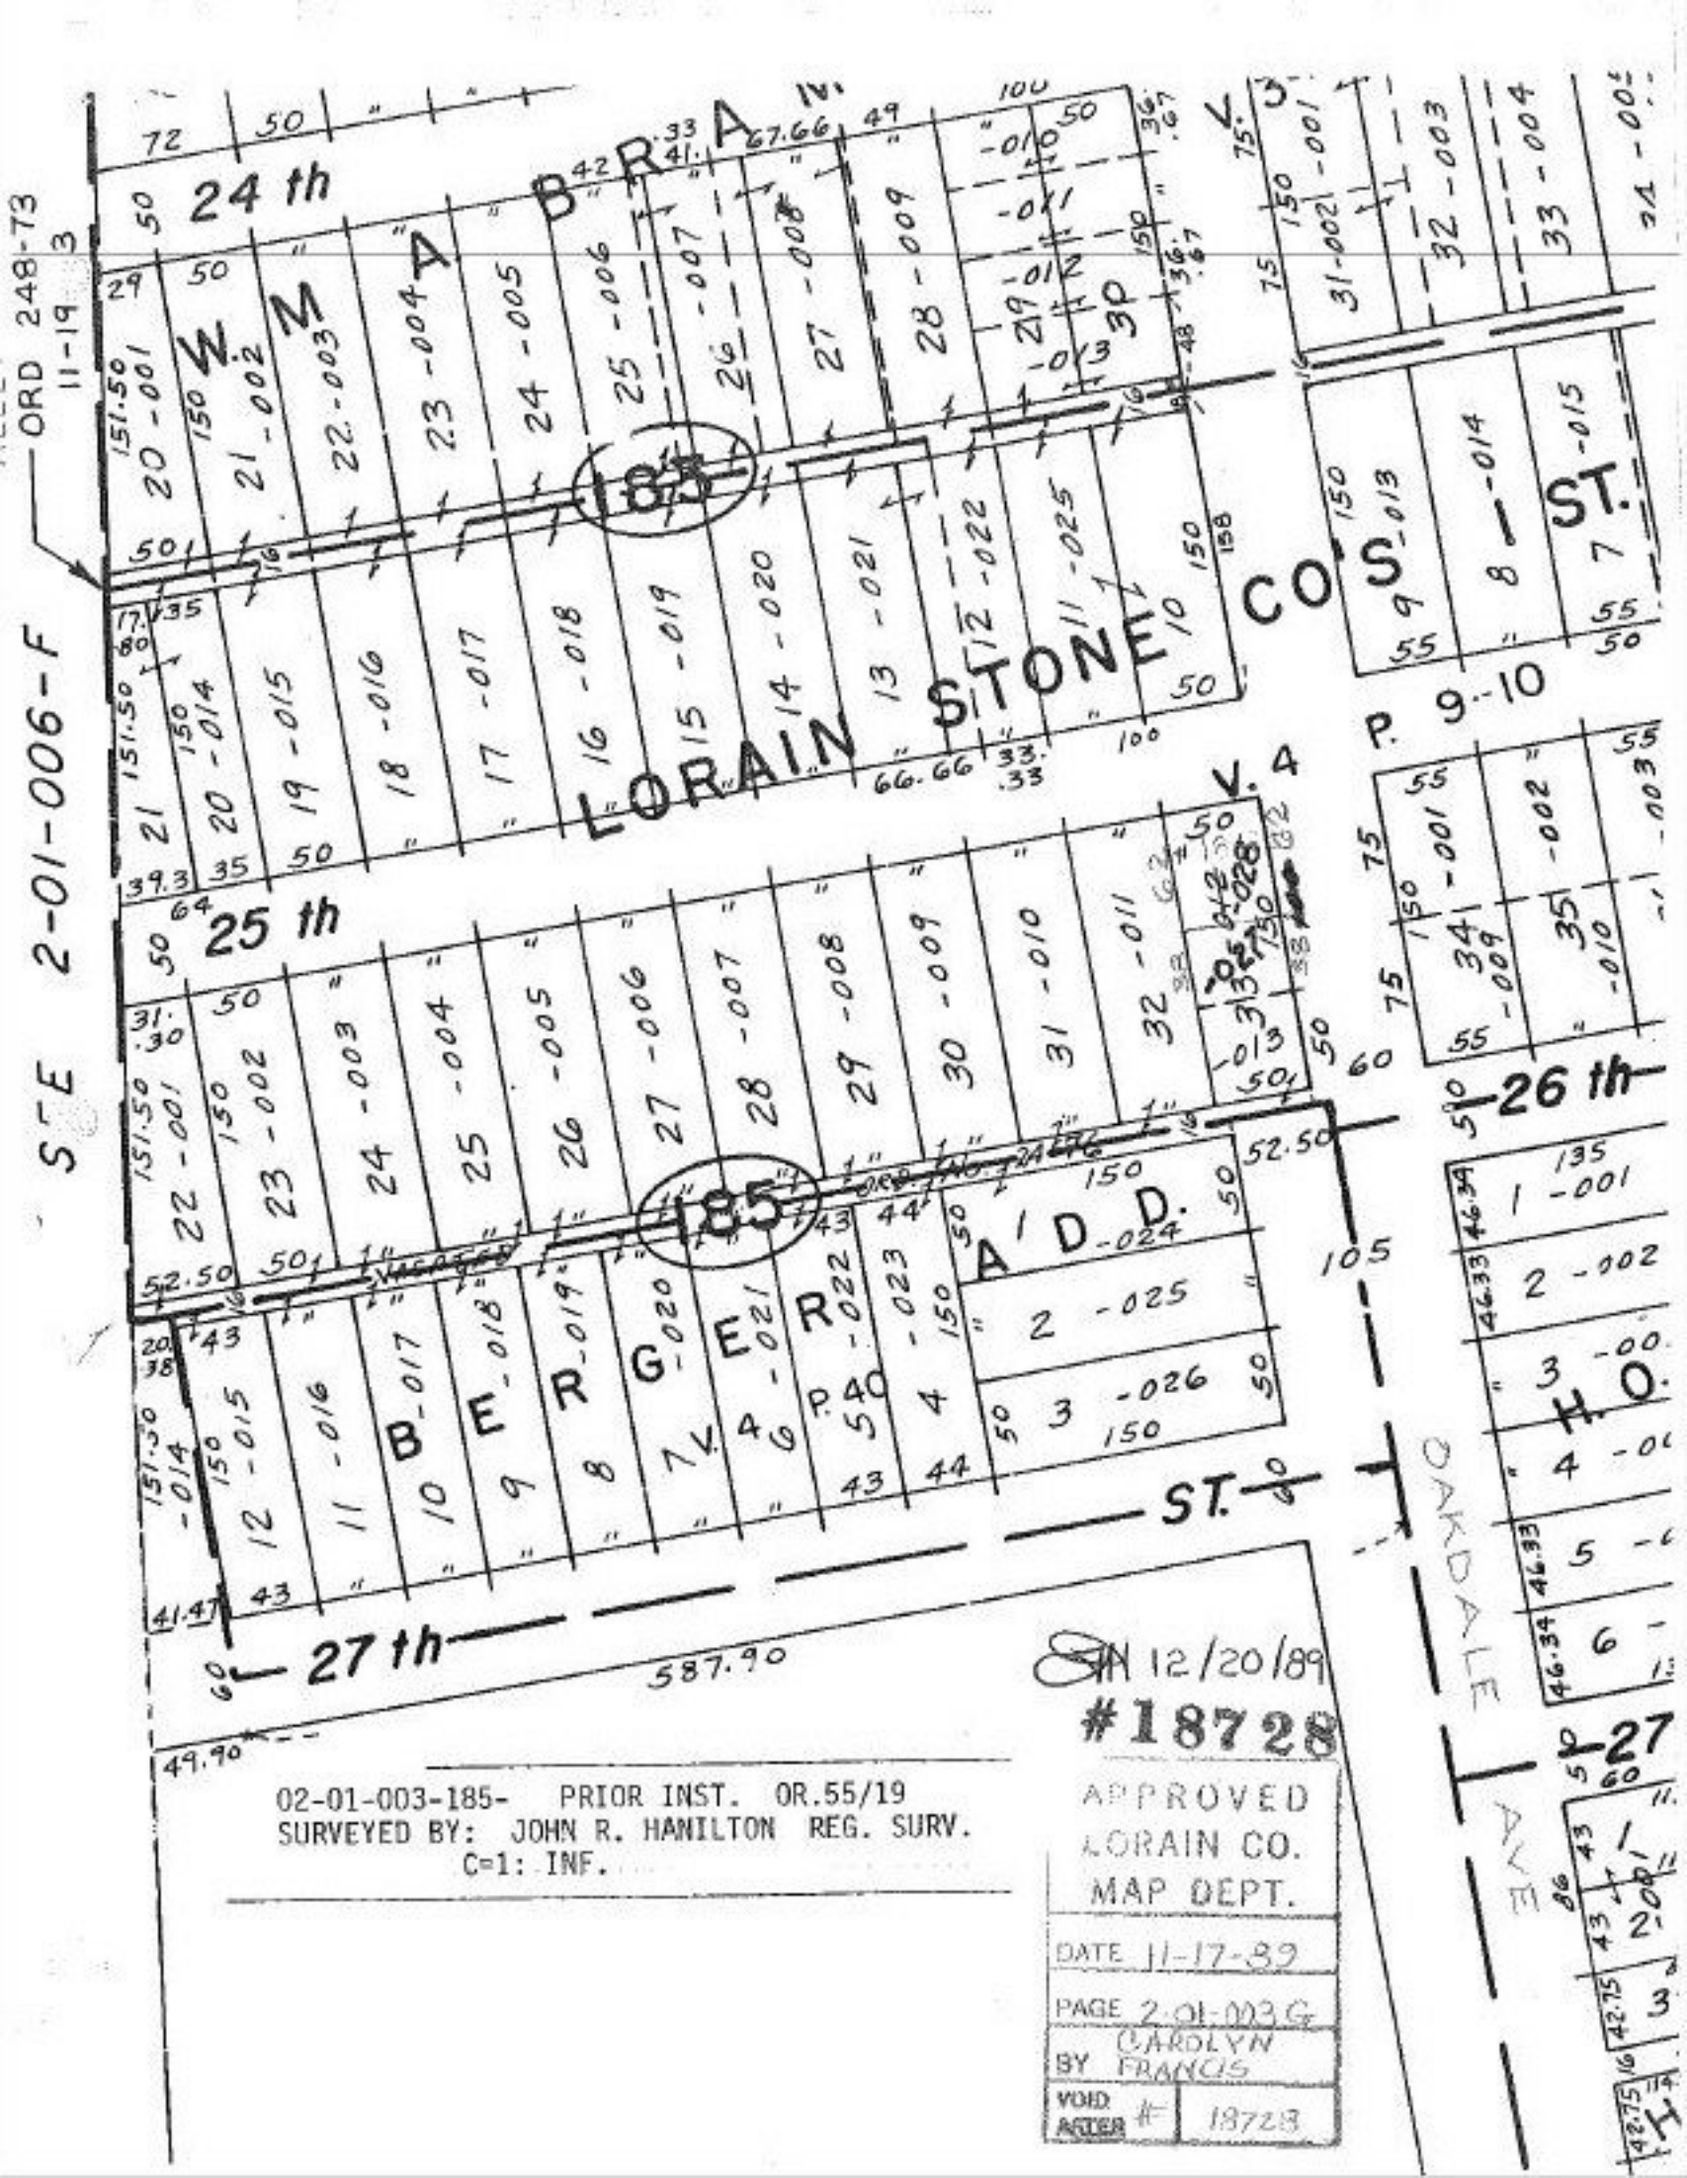

02-01-003-185- PRIOR INST. OR.55/19
SURVEYED BY: JOHN R. HANILTON REG. SURV.
C=1: INF.