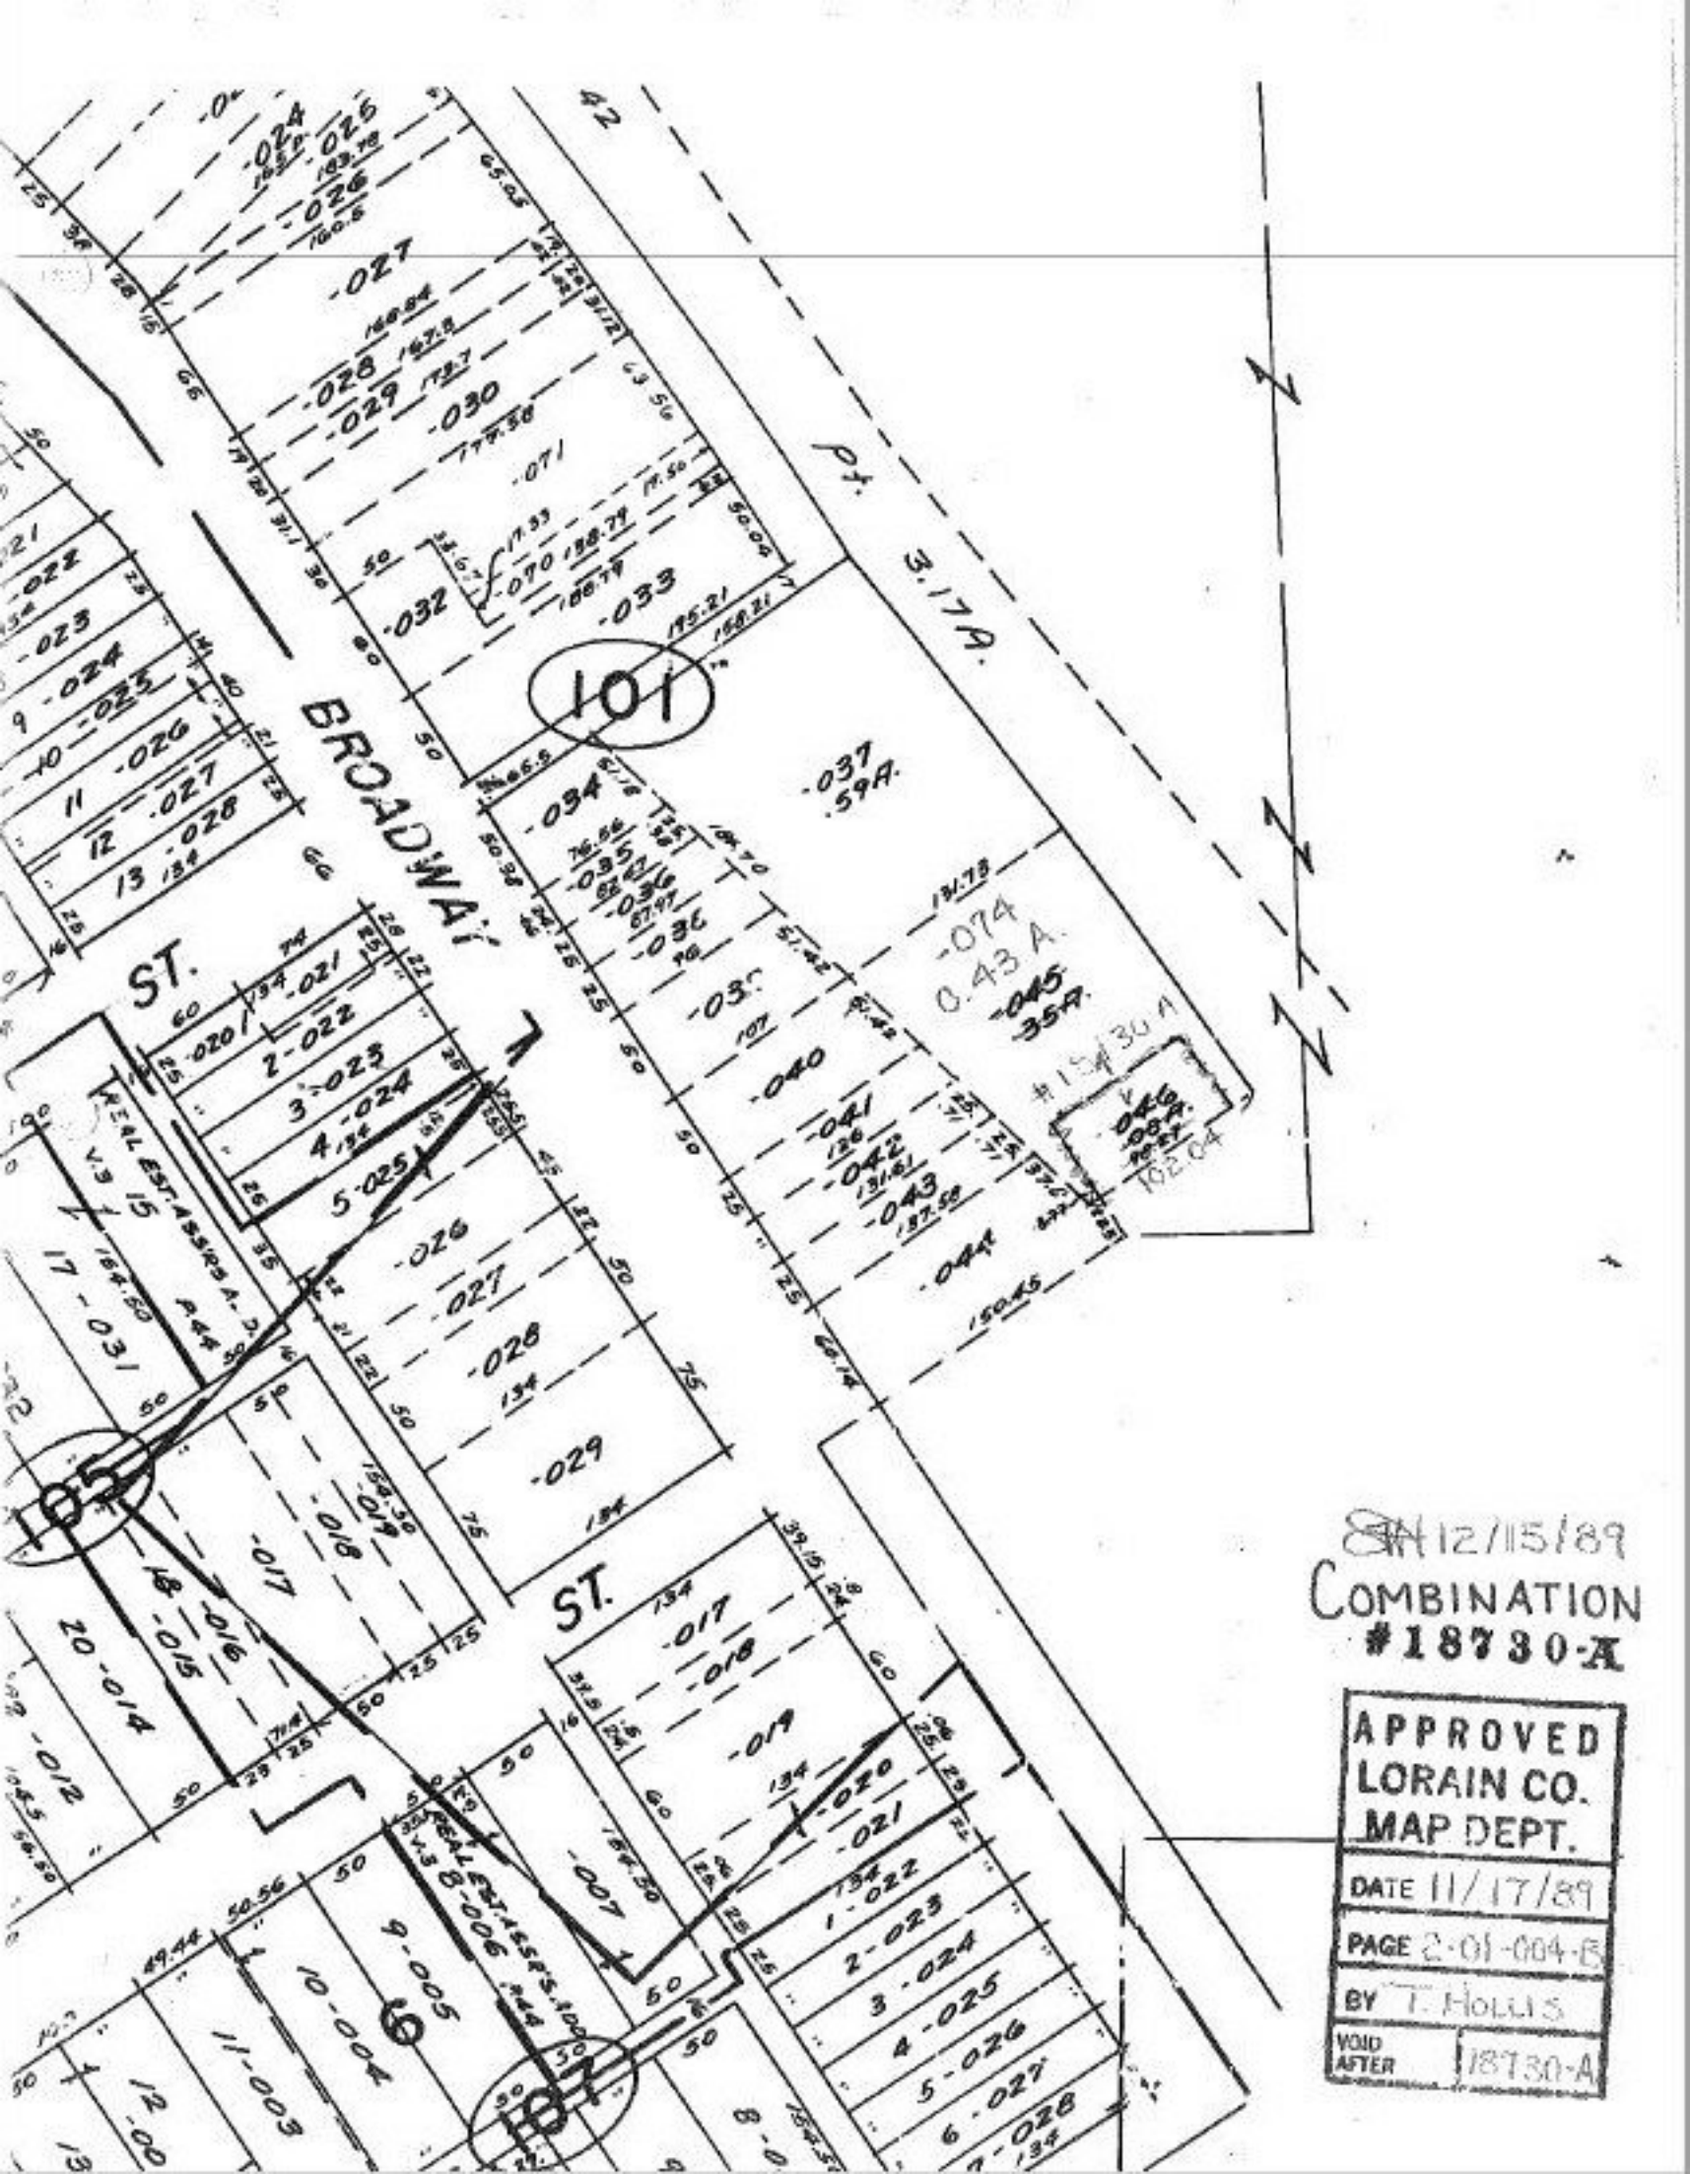
BROADWAY
ST.
ST.
Pt. 3.17A.
101
105
107
-037
.59A.
-074
0.43 A.
-045
.35A.
#18730 A
-040
-041
-042
-043
-044
-026
-027
-028
-029
-017
-018
-019
-020
-021
-022
-023
-024
-025
-032
-033
-034
-035
-036
-037
-070
-071
REAL EST. ASSTS A.D. P.44
V.3 15
17 - 031
20 - 014
18 - 016
18 - 015
9 - 005
10 - 004
11 - 003
12 - 002
1 - 022
2 - 023
3 - 024
4 - 025
5 - 026
6 - 027
7 - 028
8 - 007
8 - 006
12/15/89
COMBINATION
#18730-A
APPROVED
LORAIN CO.
MAP DEPT.
DATE 11/17/89
PAGE 2-01-004-B
BY T. HOLLIS
VOID AFTER 18730-A