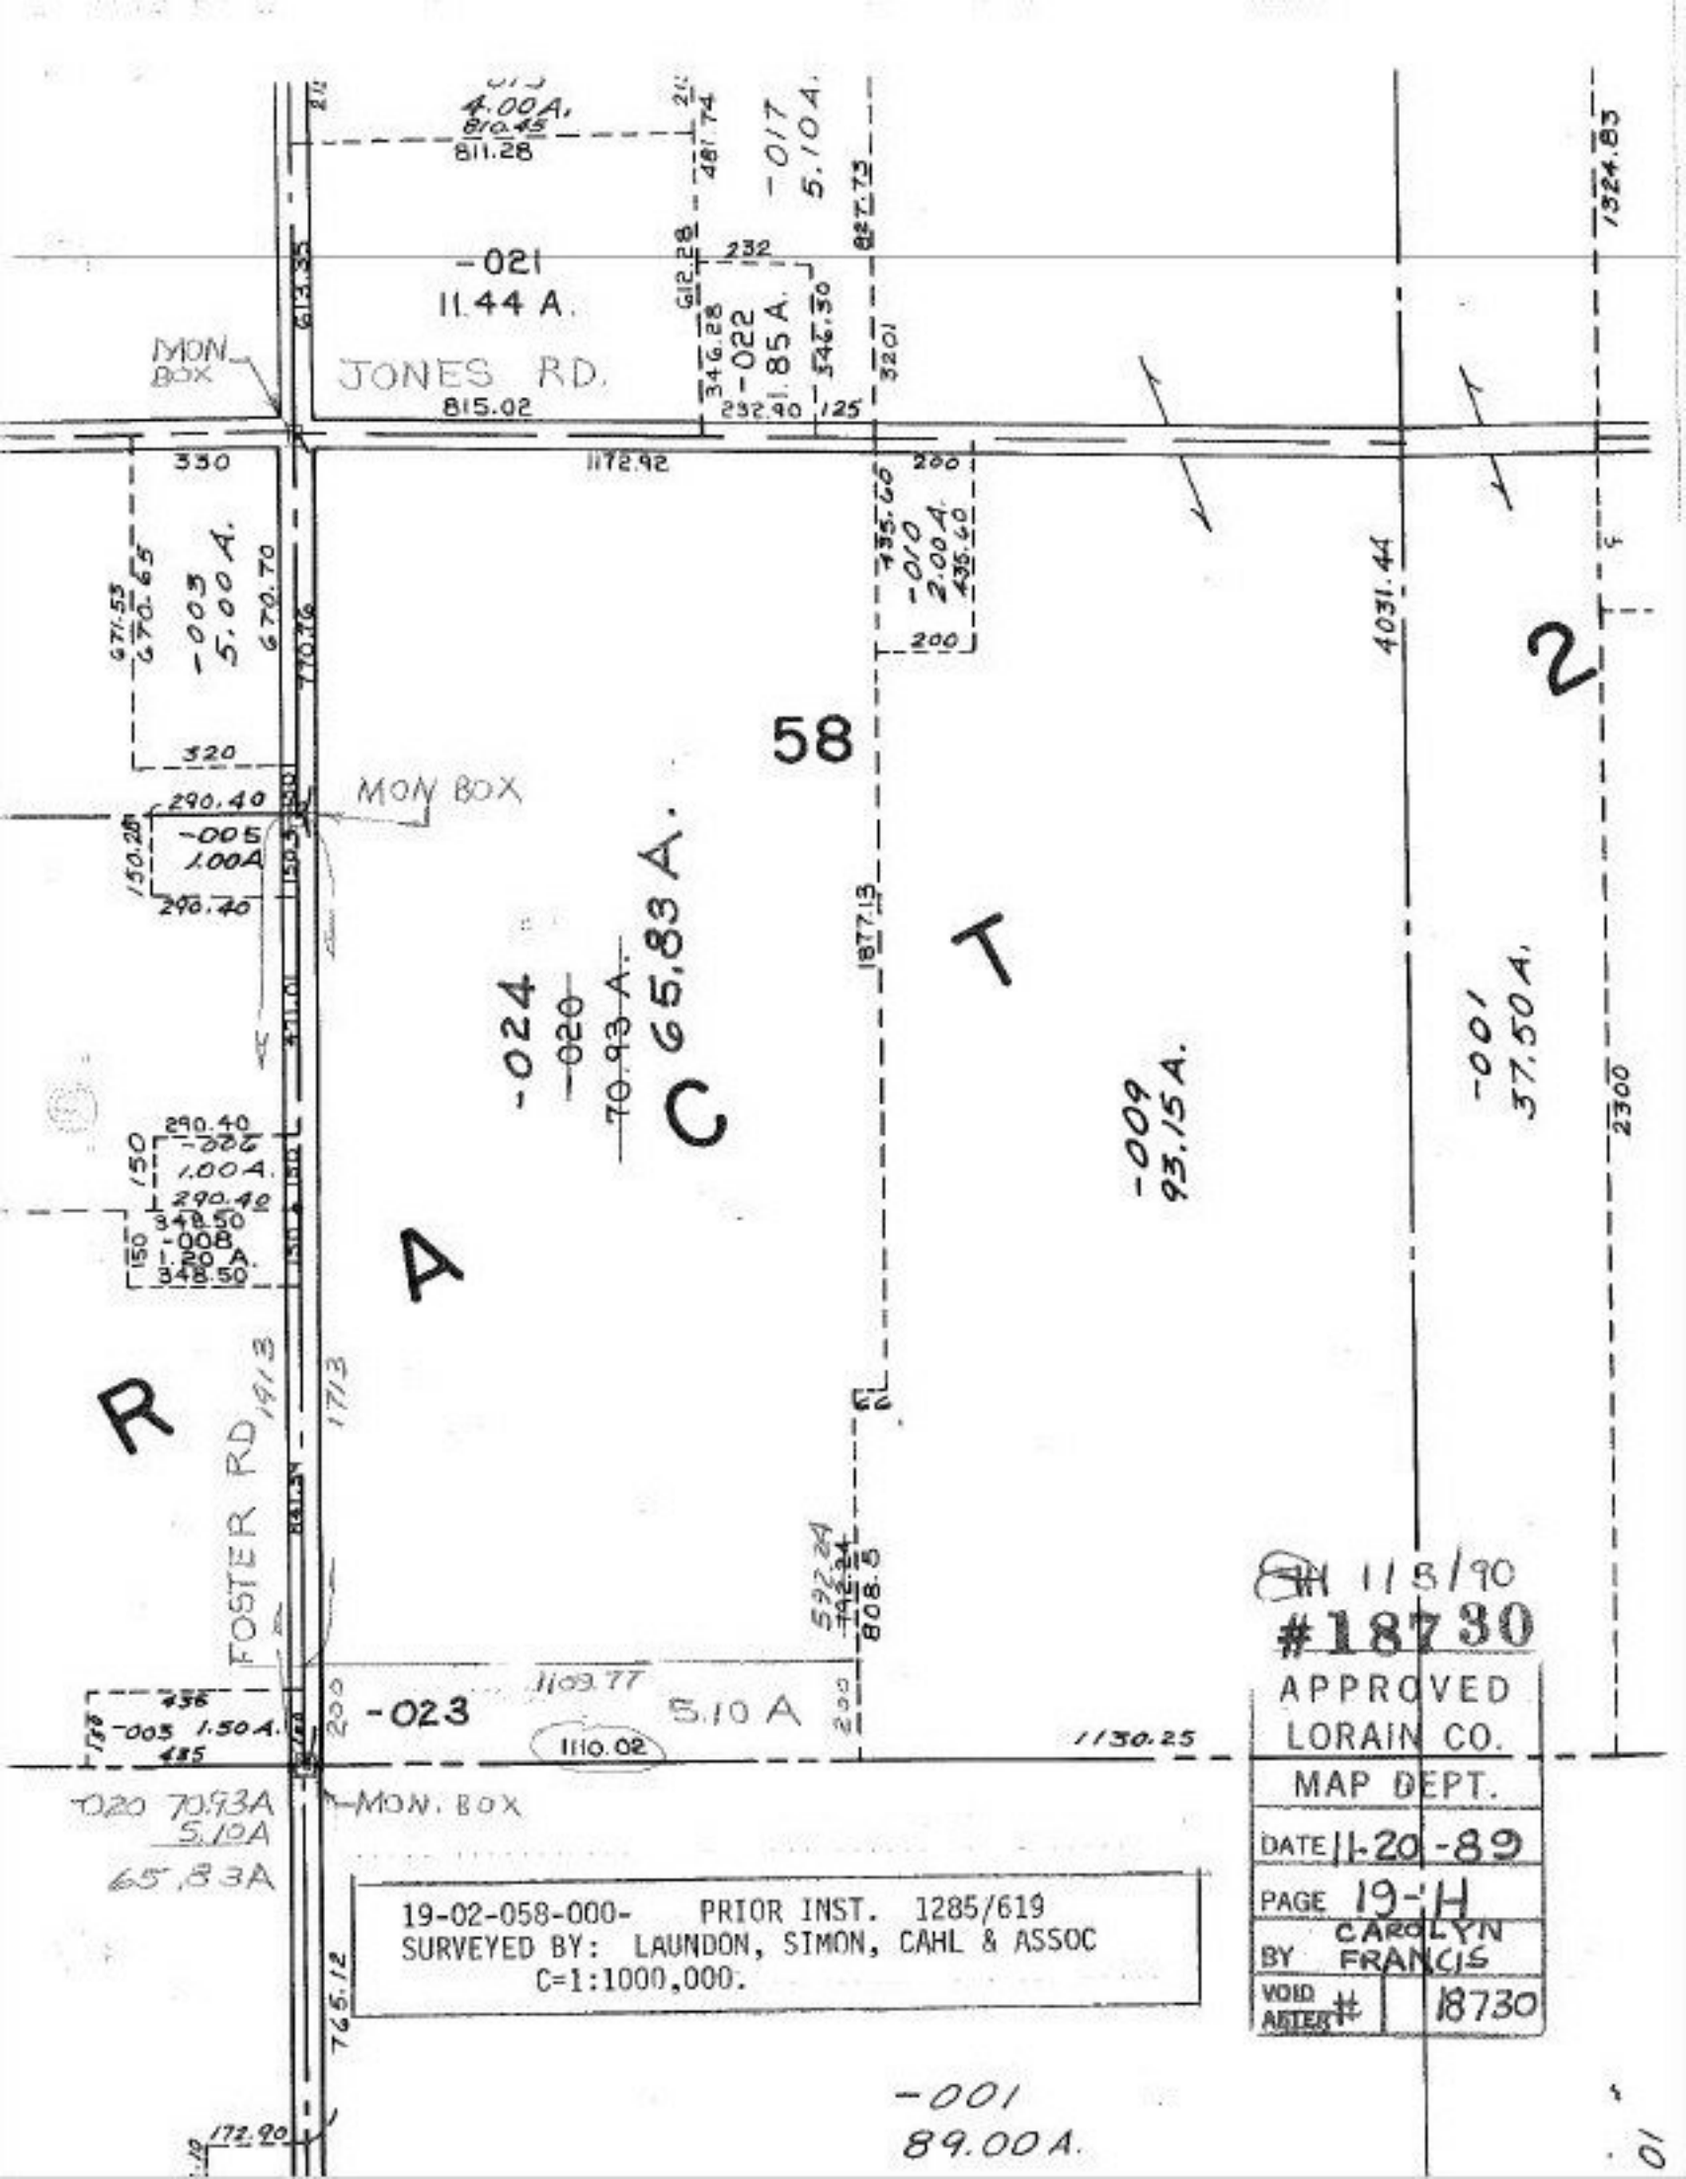

19-02-058-000- PRIOR INST. 1285/619
SURVEYED BY: LAUNDON, SIMON, CAHL & ASSOC
C=1:1000,000.

11/5/90
#18730
APPROVED
LORAIN CO.
MAP DEPT.
DATE 11-20-89
PAGE 19-1H
BY CAROLYN FRANCIS
VOID AFTER # 18730