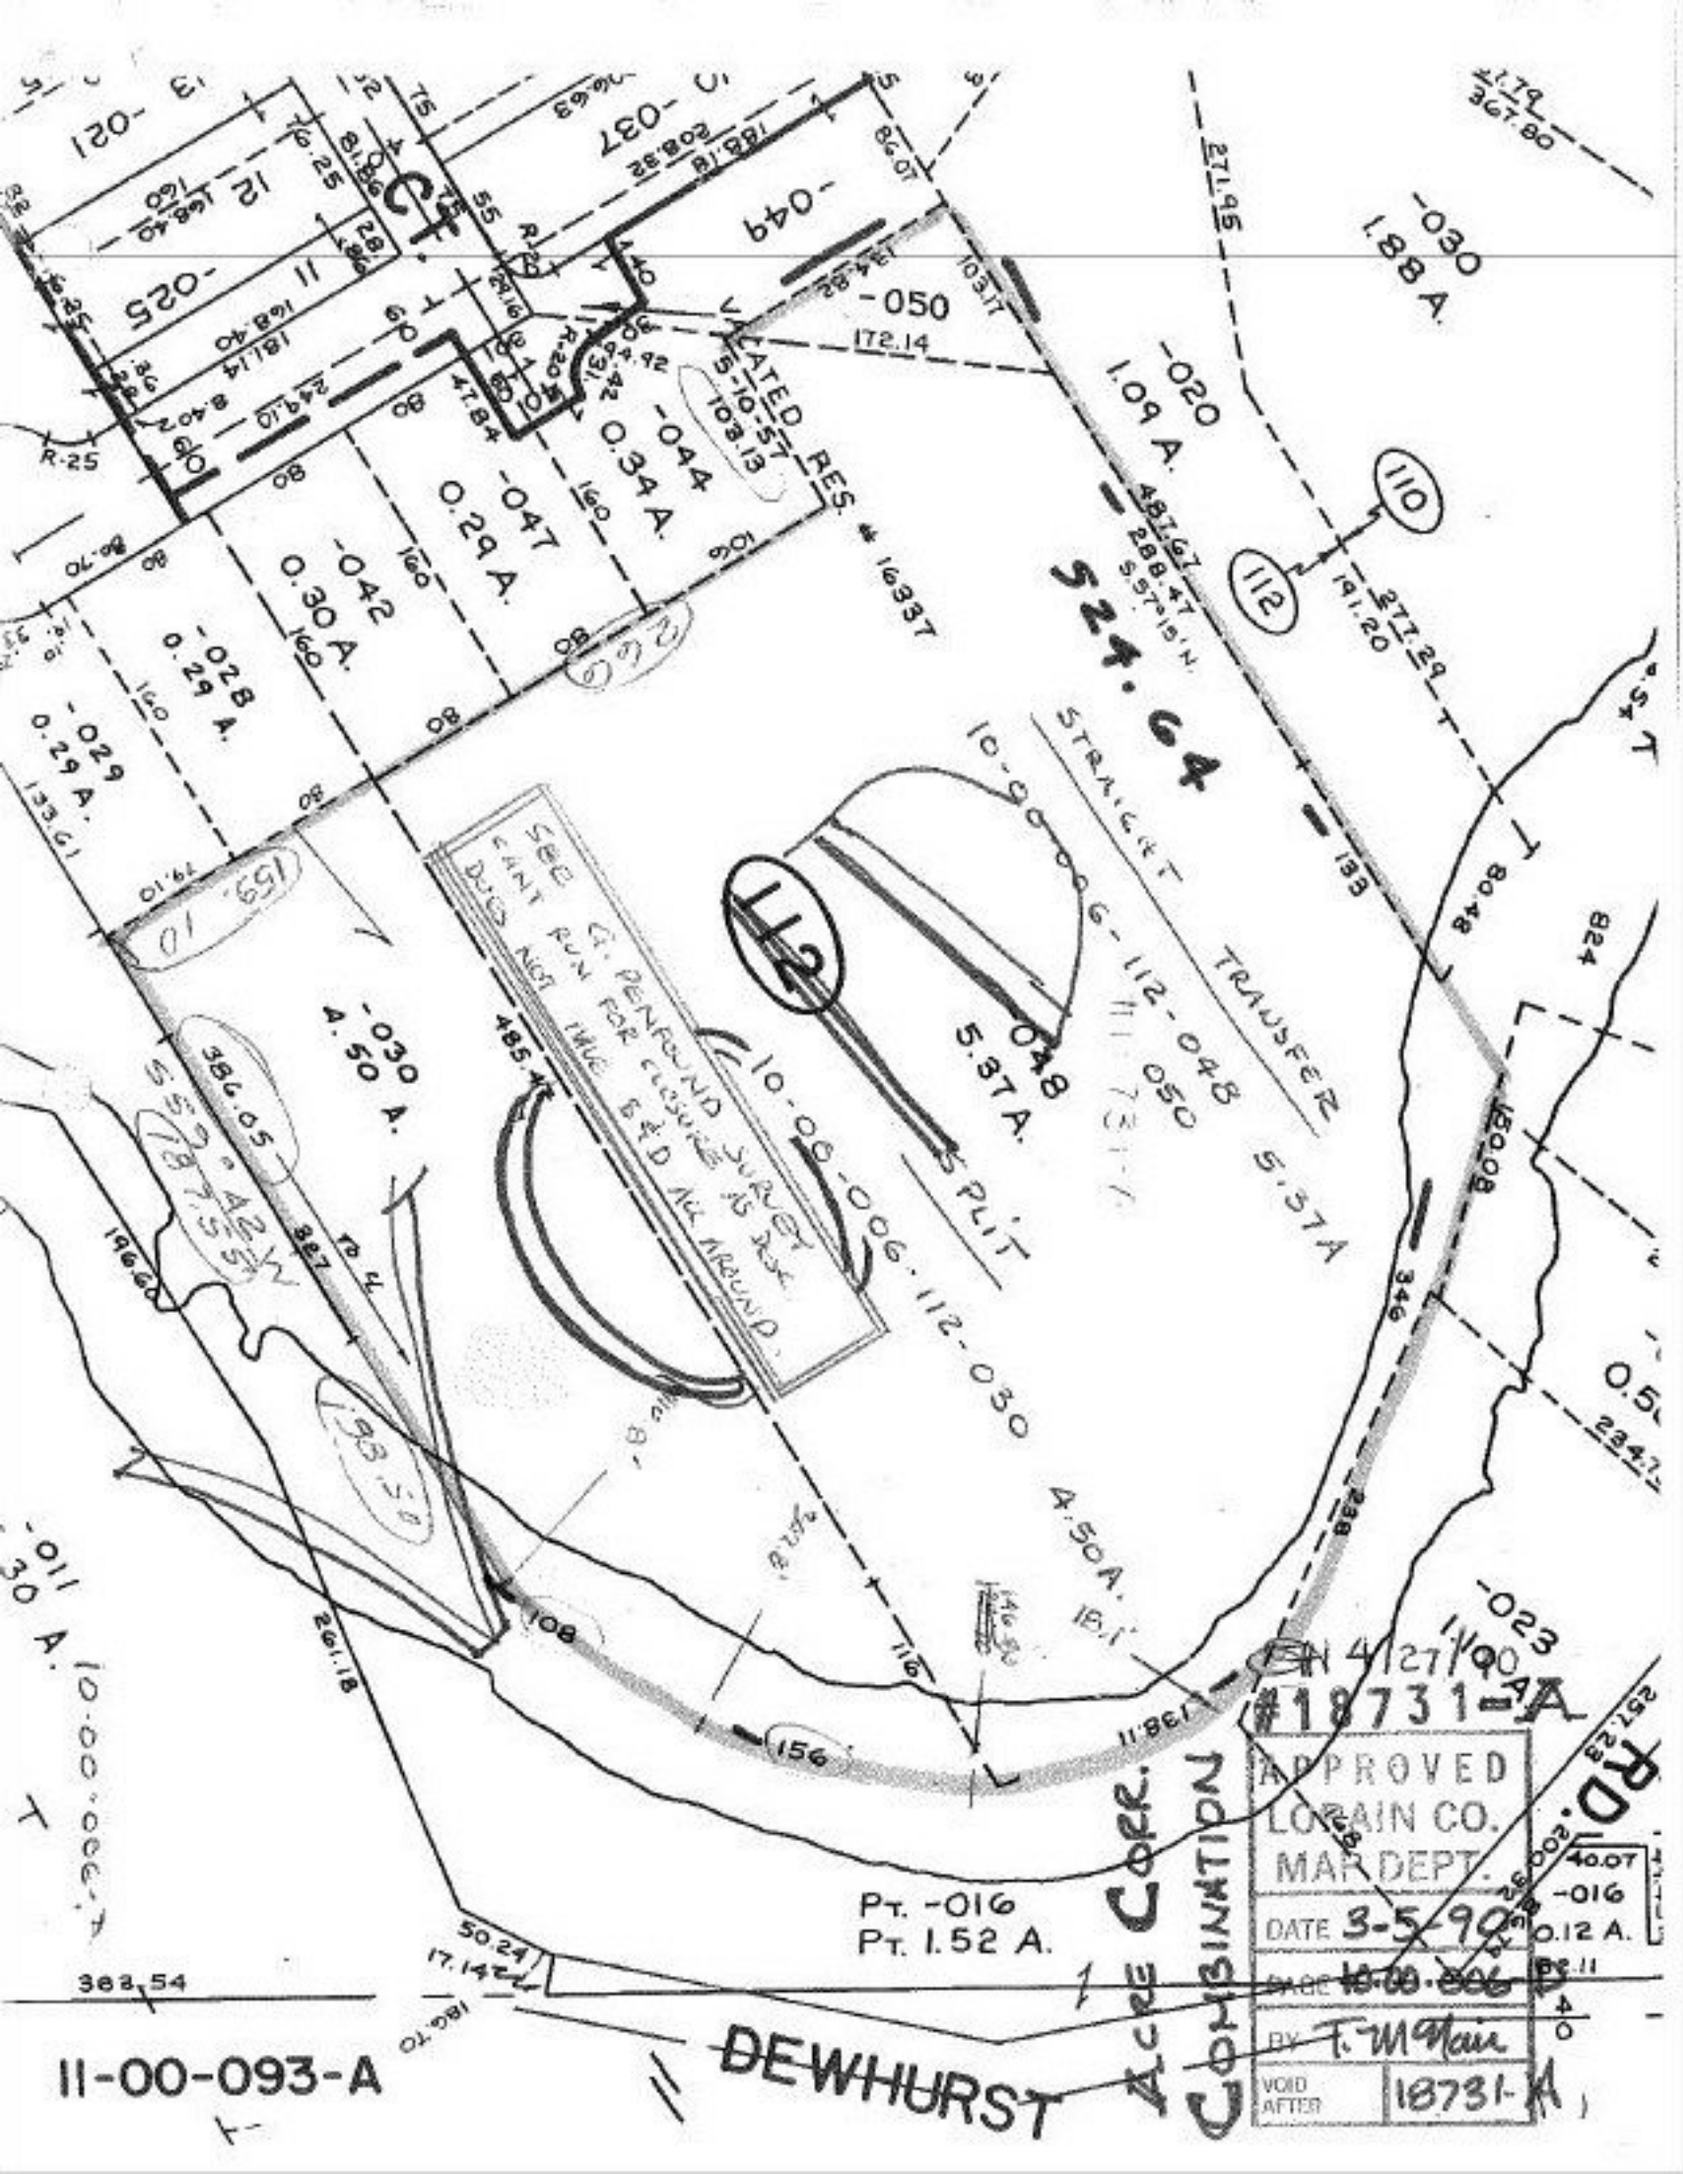
-021
-025
-037
-049
-050
-030
1.88 A.
-020
1.09 A.
-044
0.34 A.
-047
0.29 A.
-042
0.30 A.
-028
0.29 A.
-029
0.29 A.
-048
5.37 A.
-030
4.50 A.
-011
30 A.
-023
S24.64
SPLIT
10-00-006-112-030
4.50A.
10-00-006-112-048
5.37A
STRAIGHT TRANSFER
SEE 4" PENFOUND SURVEY
PLANT RUN FOR CLOSURE
DOG NOT IMUE E&D ALL AROUND
VACATED RES. # 16337
S-10-57
108.13
S-57°15'W
288.47
S-57°15'W
386.05
S-57°15'W
196.60
261.18
108
156
116
138.61
485.47
346
133
191.20
277.29
180.48
824
150.08
238
110
112
111
12
Pt. -016
Pt. 1.52 A.
50.24
17.14
382.54
180.70
DEWHURST
ACRE CORR.
RD.
257.23
200
40.07
-016
0.12 A.
Bk. 11
40
#18731-A
APPROVED
LORAIN CO.
MAR DEPT.
DATE 3-5-90
BY F. McMain
VOID AFTER 18731-A
11-00-093-A