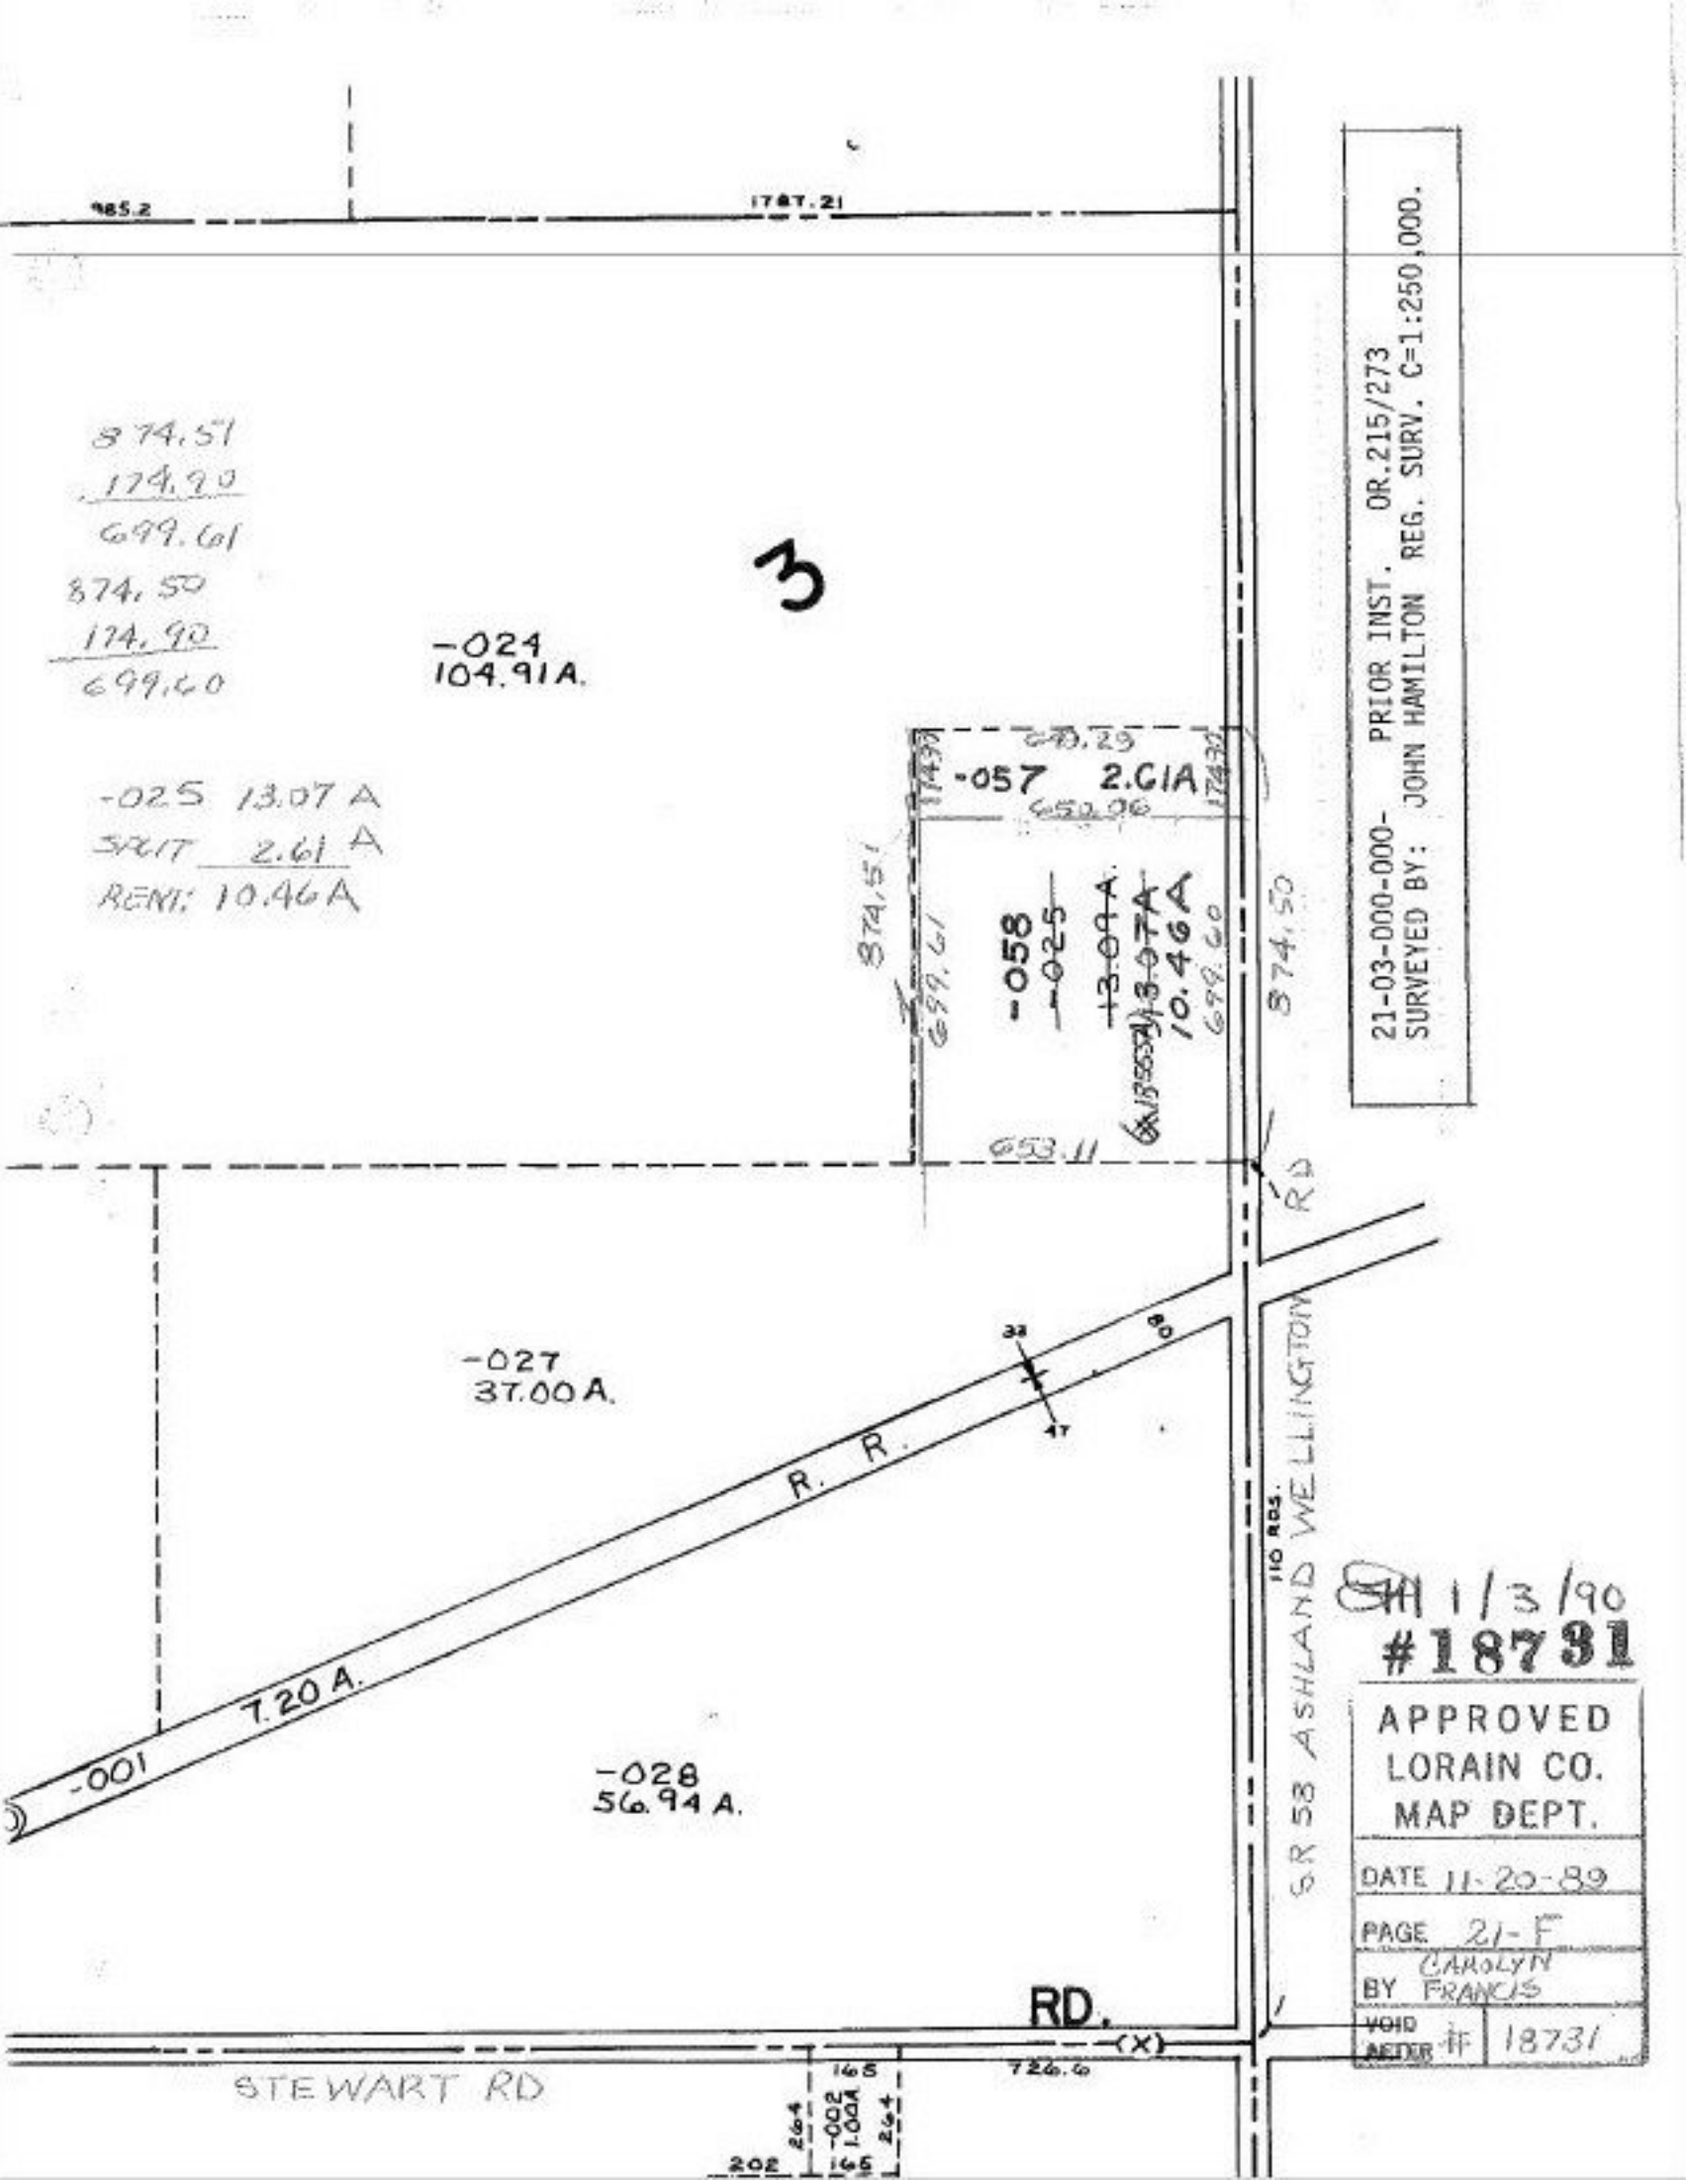

985.2
1787.21
874.51
174.90
699.61
874.50
174.90
699.60
3
-024
104.91A.
-025 13.07 A
SPLIT 2.61 A
RENT: 10.46A
640.29
-057 2.61A
650.06
874.51
699.61
-058
-025
13.07A
10.46A
699.60
874.50
653.11
RD
-027
37.00A.
R. R.
33
47
80
-001
7.20 A.
-028
56.94 A.
110 RDS.
SR 58 ASHLAND WELLINGTON
RD.
(X)
STEWART RD
165
726.6
264
-002
1.00A
264
202
165
21-03-000-000- PRIOR INST. OR.215/273
SURVEYED BY: JOHN HAMILTON REG. SURV. C=1:250,000.
1/3/90
#18731
APPROVED
LORAIN CO.
MAP DEPT.
DATE 11-20-89
PAGE 21-F
BY CAROLYN FRANCIS
VOID AFTER # 18731