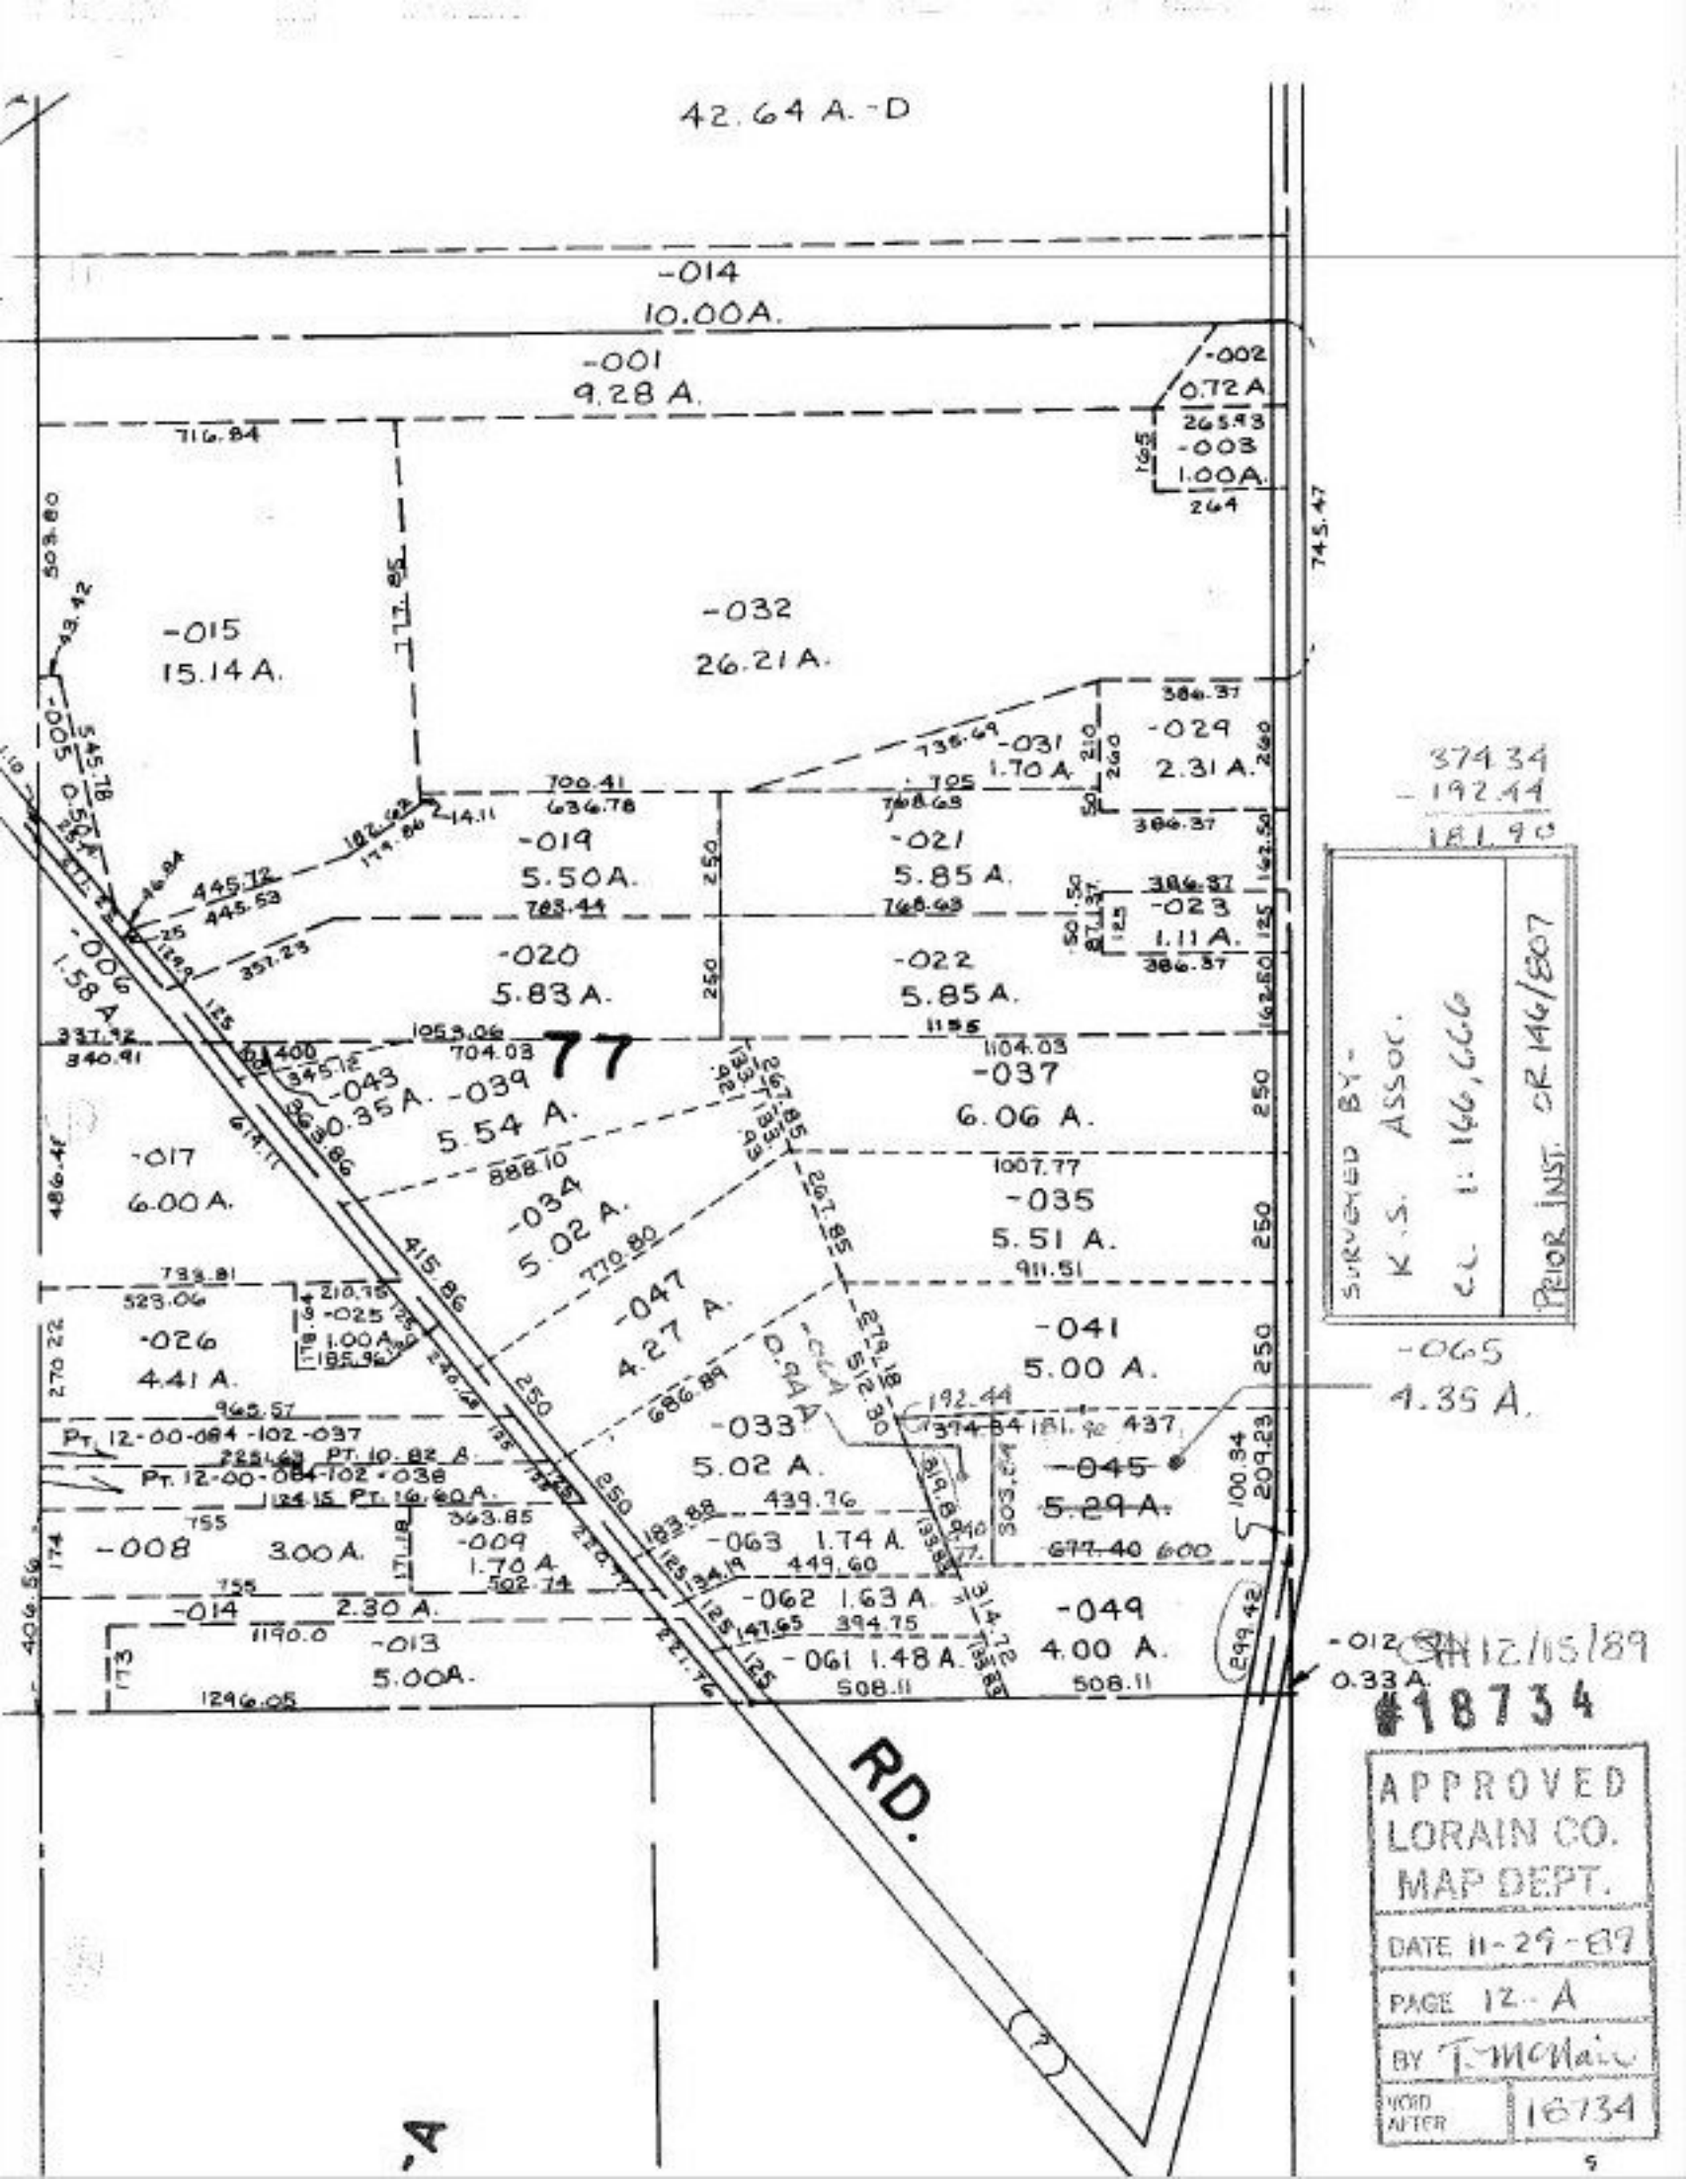
42.64 A. -D
-014
10.00A.
-001
9.28 A.
-002
0.72A
-003
1.00A.
-015
15.14 A.
-032
26.21A.
-031
1.70 A.
-029
2.31 A.
-019
5.50A.
-021
5.85 A.
-020
5.83 A.
-022
5.85 A.
-023
1.11 A.
-006
1.58 A
77
-043
-039
5.54 A.
-037
6.06 A.
-017
6.00 A.
-034
5.02 A.
-035
5.51 A.
-047
4.27 A.
-041
5.00 A.
-026
4.41 A.
-025
1.00A.
-033
5.02 A.
-045
5.29A.
-008
3.00A.
-009
1.70 A.
-063 1.74 A.
-062 1.63 A.
-049
4.00 A.
-014
2.30 A.
-013
5.00A.
-061 1.48 A.
-012
0.33A.
-065
4.35 A.
SURVEYED BY-
K.S. ASSOC.
CC 1: 146,666
PRIOR INST. OR 1461/807
RD.
APPROVED
LORAIN CO.
MAP DEPT.
DATE 11-29-89
PAGE 12-A
BY T. McNair
WORD AFTER 16734
#18734
12/15/89