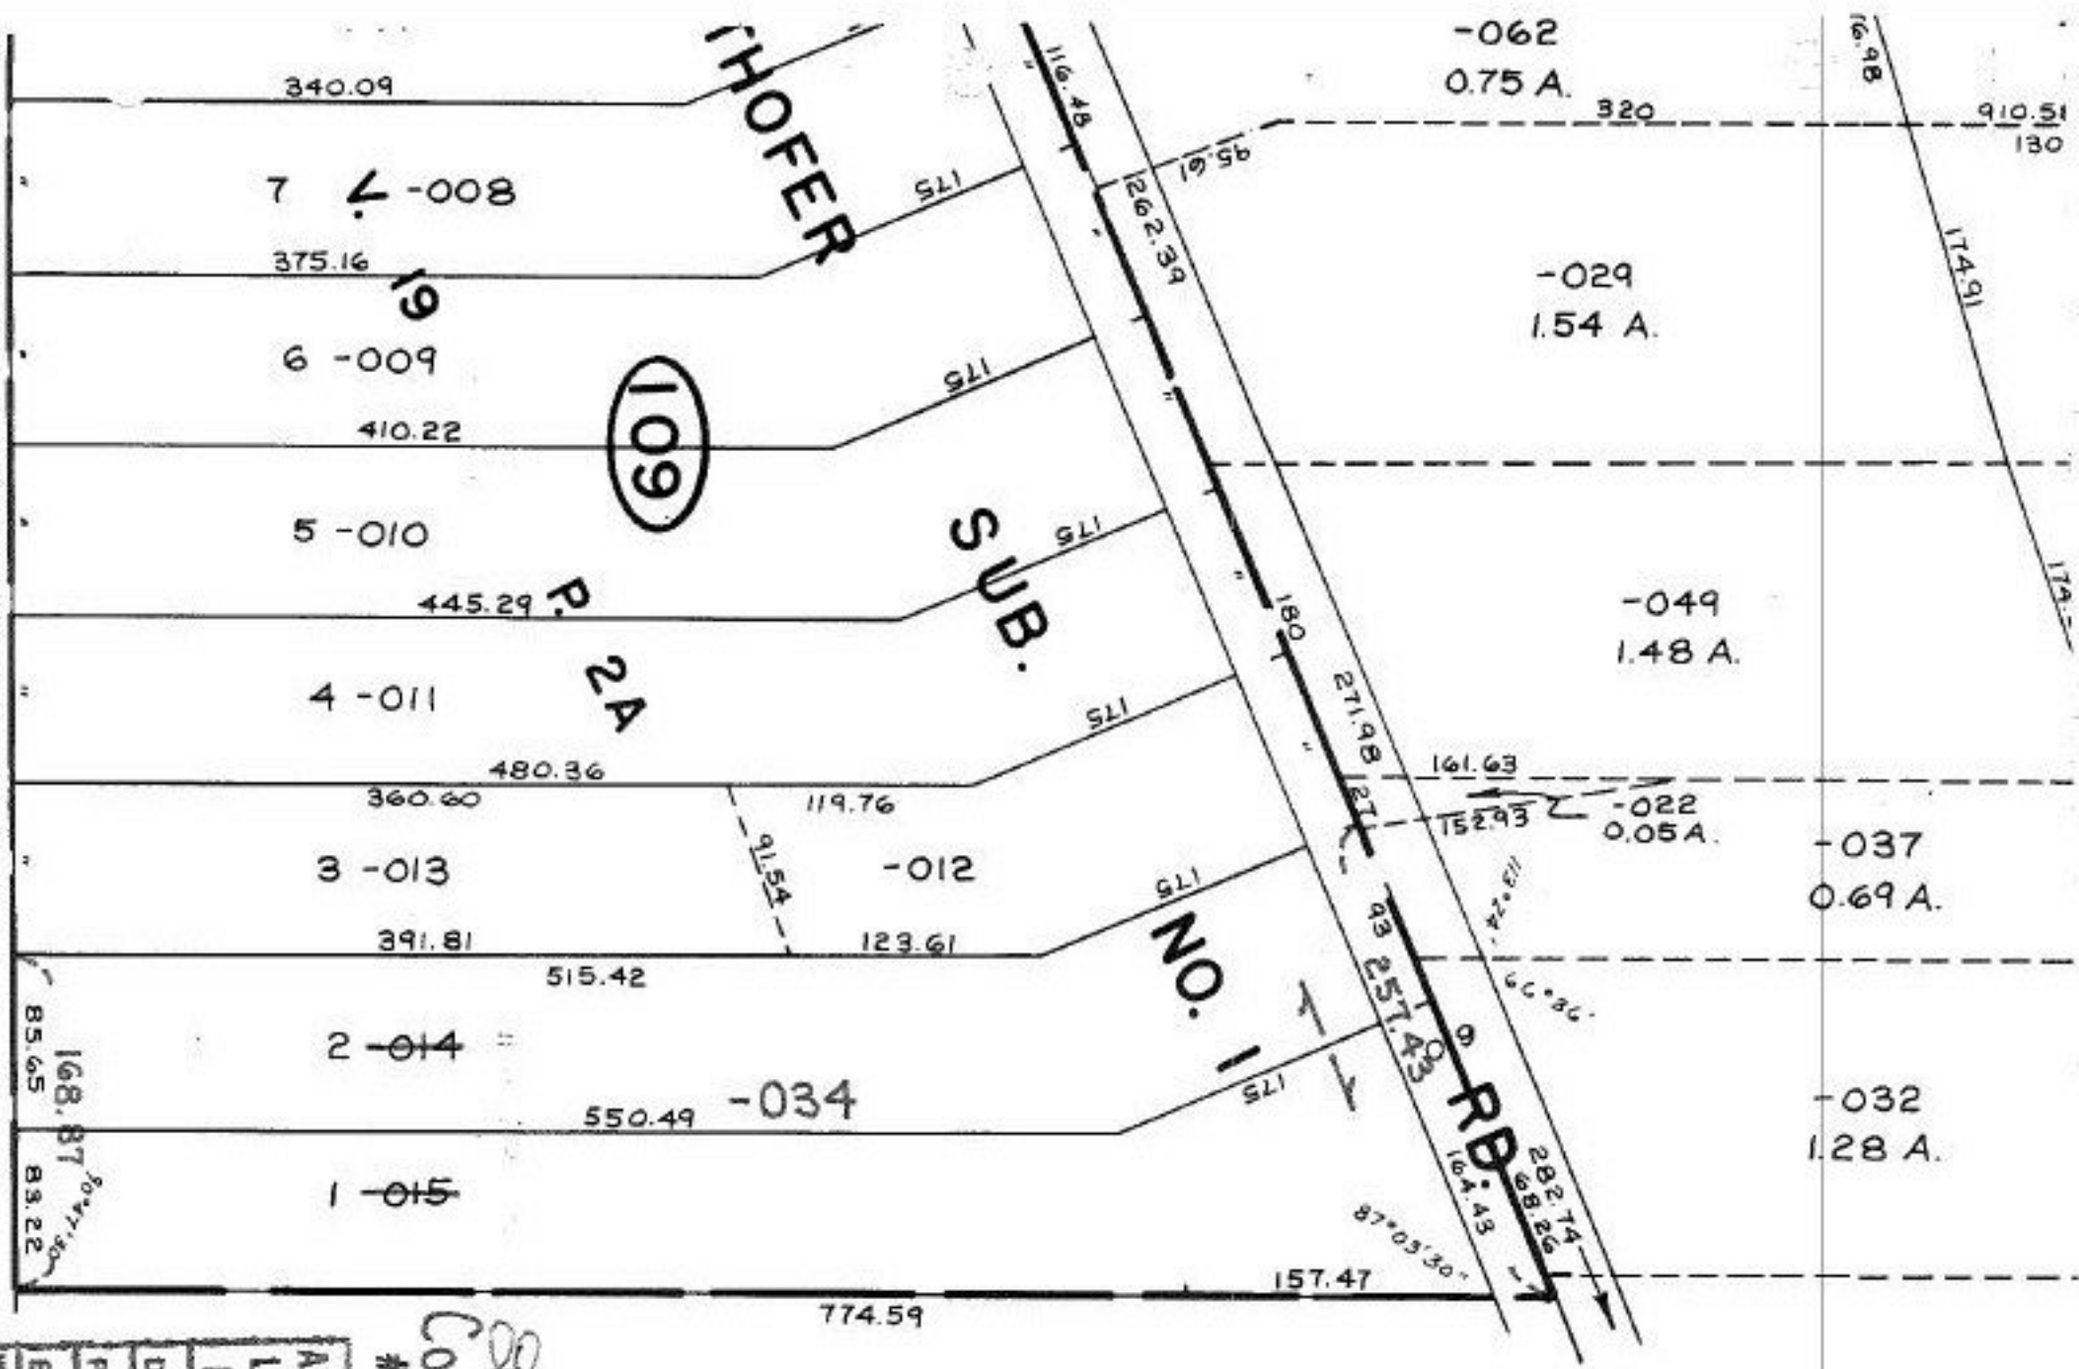

APPROVED
LORAIN CO.
MAP DEPT.
DATE 11/22/89
PAGE 10-00-007-G
BY T. HOLLIS
VOID AFTER 18735-A

COMBINATION
#18735-A

SM 12/15/89