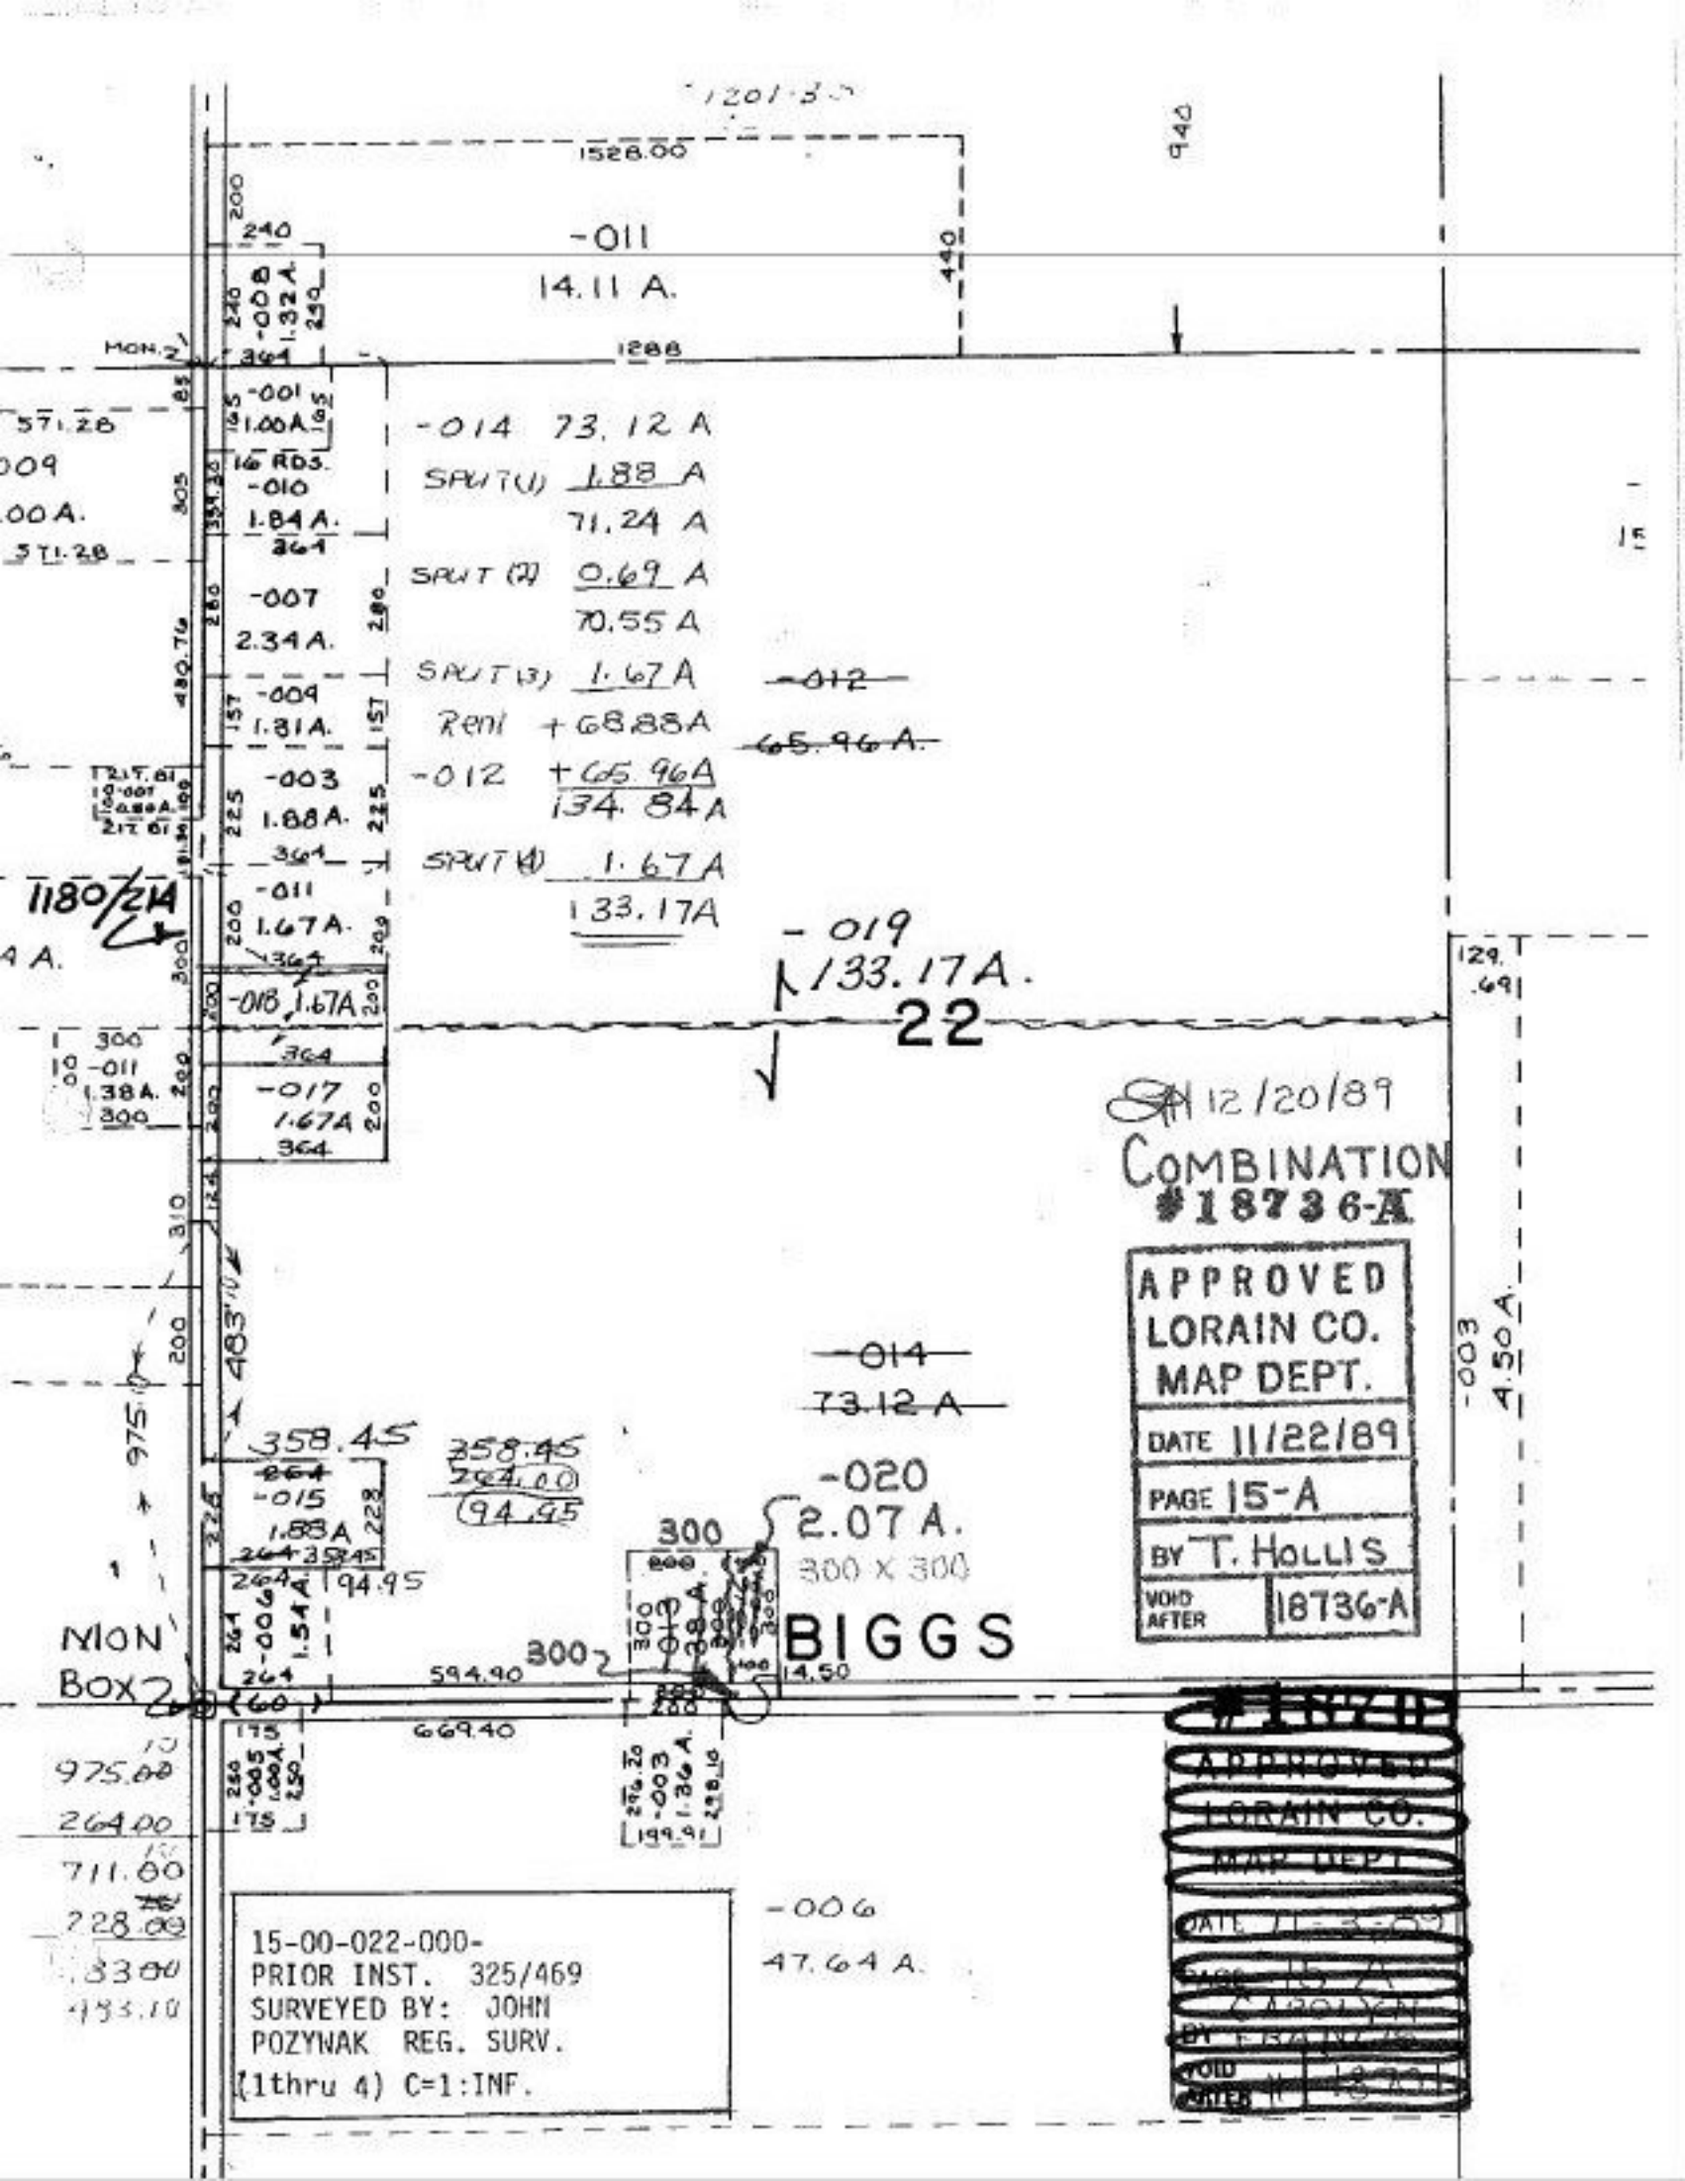

1201.30
1528.00
940
-011
14.11 A.
440
1288
-008
1.32 A.
MON.
-001
1.00 A.
16 RDS.
-010
1.84 A.
-007
2.34 A.
-009
1.81 A.
-003
1.88 A.
-011
1.67 A.
-018 1.67A
-017
1.67A
364
-014 73.12 A
SPLIT (1) 1.88 A
71.24 A
SPLIT (2) 0.69 A
70.55 A
SPLIT (3) 1.67 A
Rent +68.88A
-012 +65.96A
134.84 A
SPLIT (4) 1.67 A
133.17A
-012
65.96 A.
-019
133.17A.
22
1180/214
12/20/89
COMBINATION
#18736-A
APPROVED
LORAIN CO.
MAP DEPT.
DATE 11/22/89
PAGE 15-A
BY T. HOLLIS
VOID AFTER 18736-A
-014
73.12 A
-020
2.07 A.
300 X 300
BIGGS
358.45
264.00
94.95
-015
1.88A
-006
1.54 A
MON
BOX
594.90
669.40
14.50
-003
4.50 A.
975.00
264.00
711.00
228.00
483.10
-006
47.64 A.
15-00-022-000-
PRIOR INST. 325/469
SURVEYED BY: JOHN
POZYWAK REG. SURV.
(1thru 4) C=1:INF.