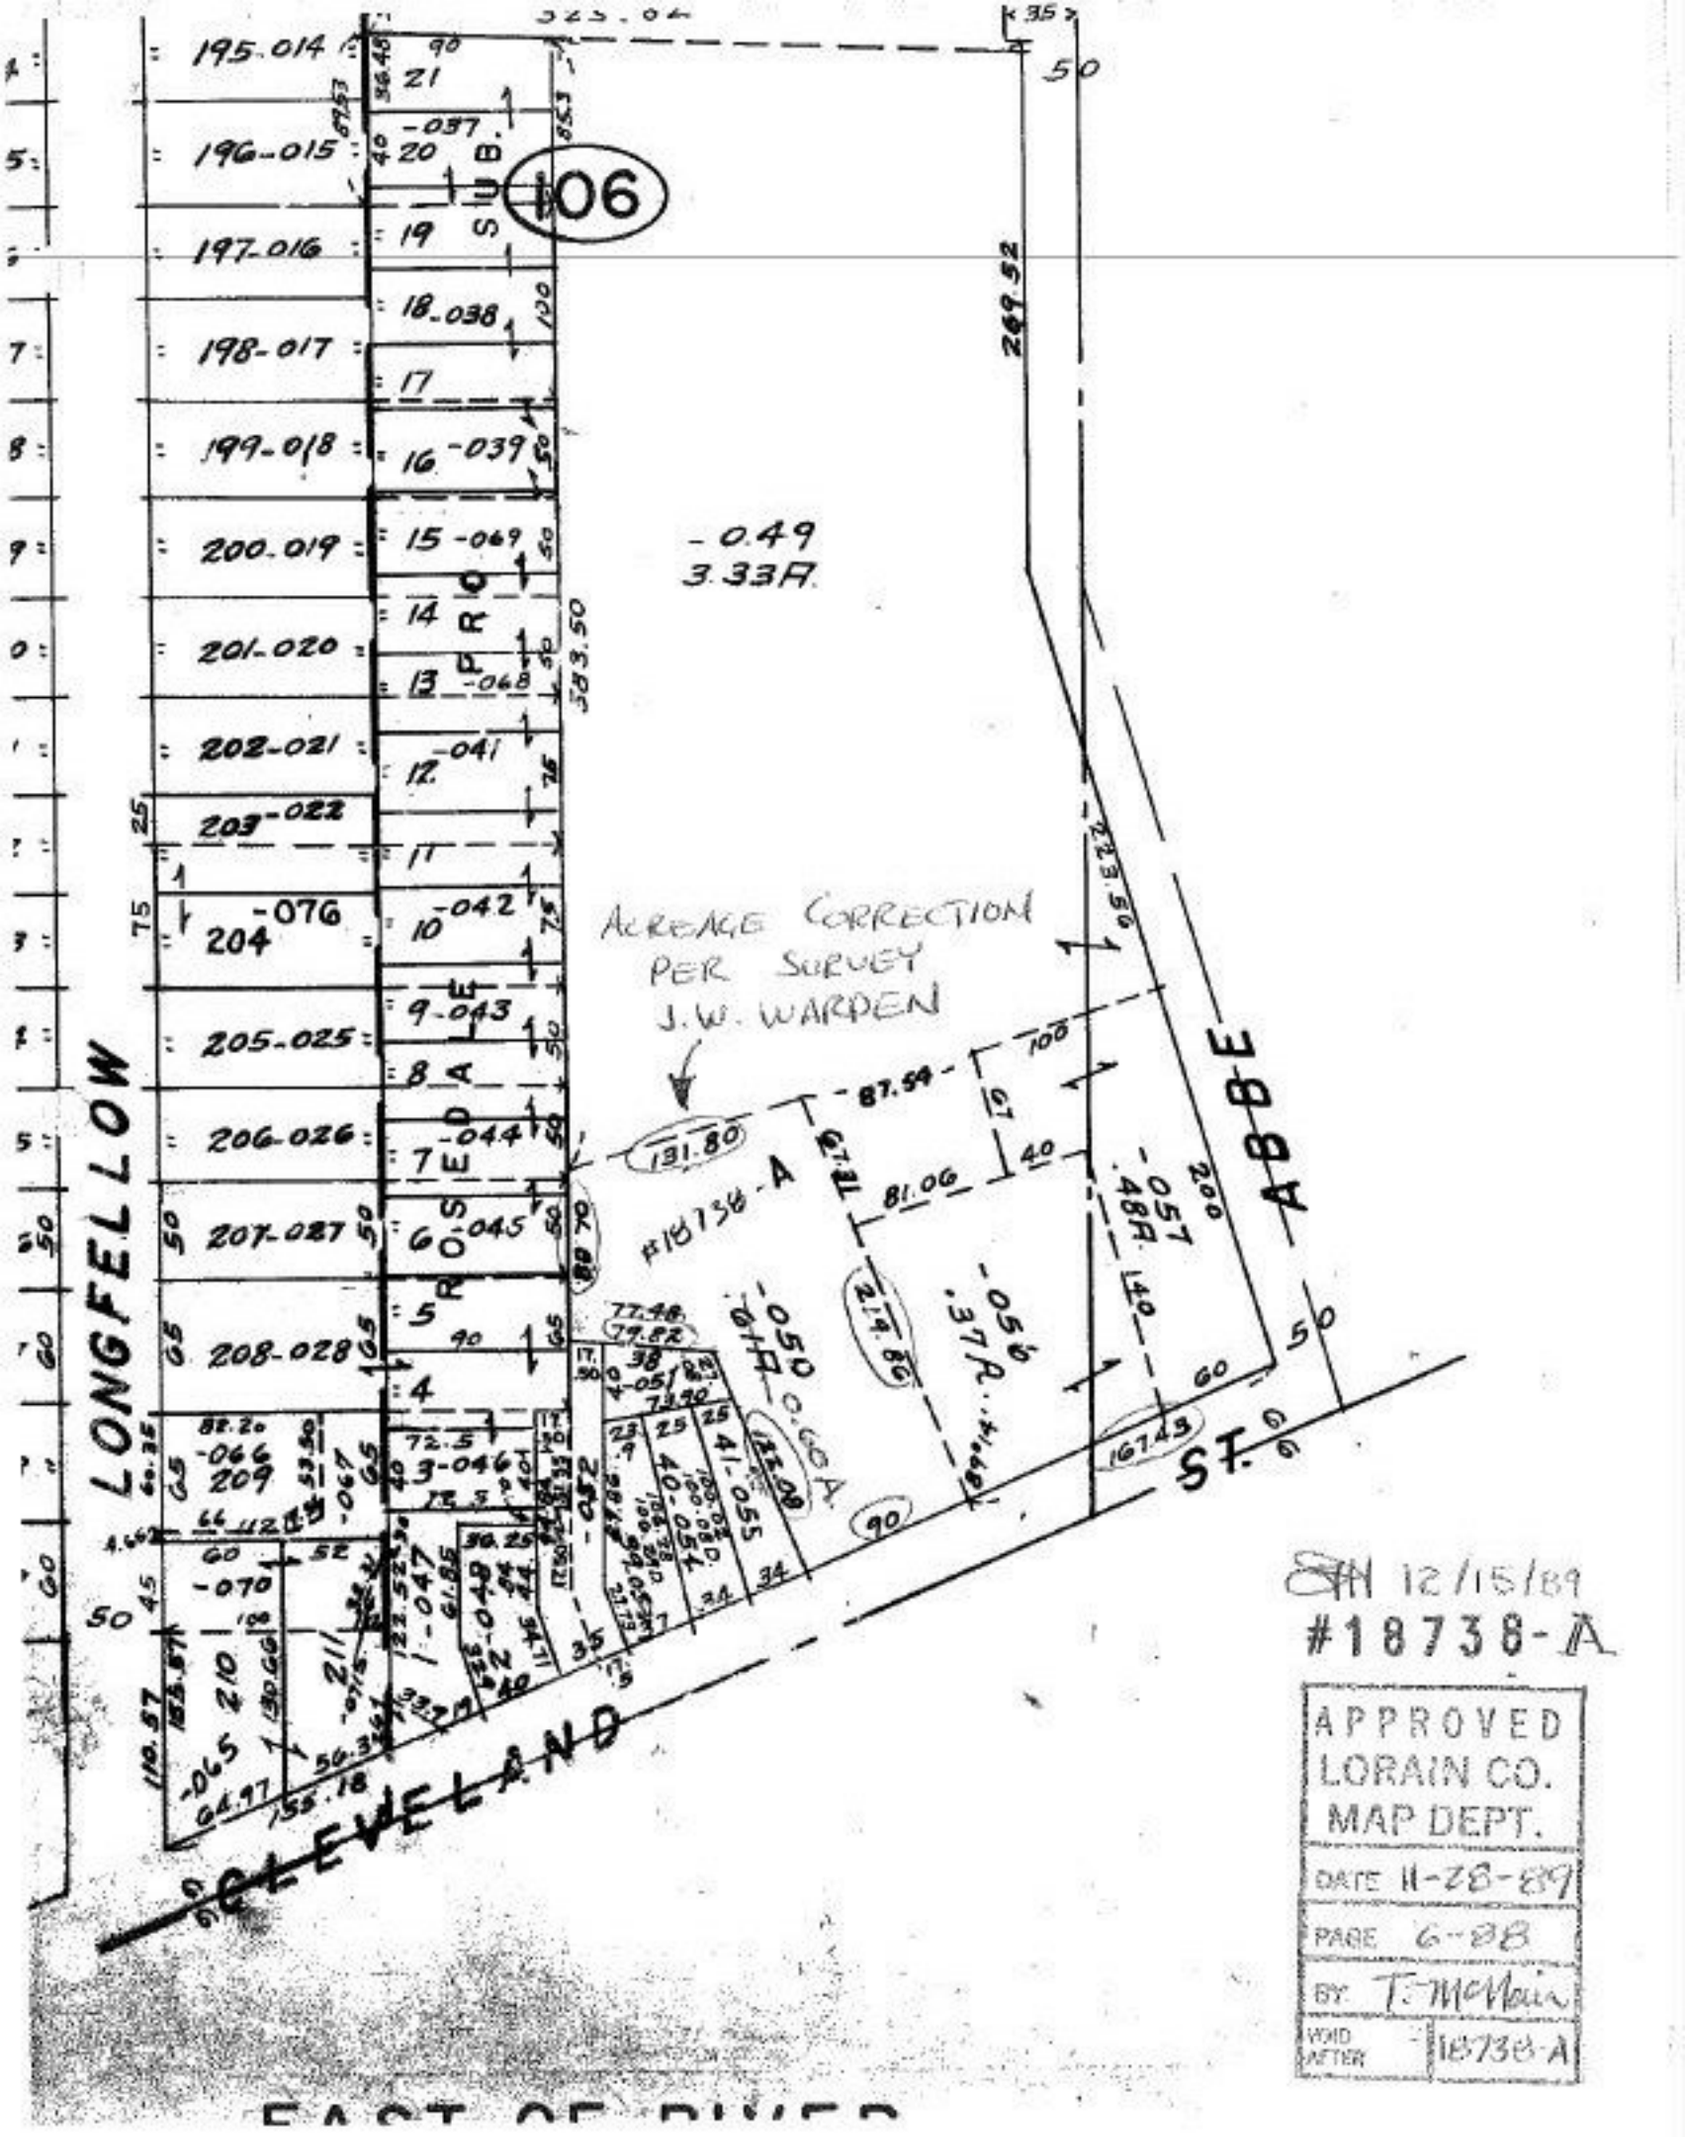
LONGFELLOW
ABBE
CLEVELAND
ST.
SUB. 06
ACREAGE CORRECTION
PER SURVEY
J.W. WARDEN
#18738-A
-0.49
3.33A.
-057
.48A.
-056
.37A.
-050
.01A.
-0.60A.
269.52
383.50
167.43
195.014
196-015
197-016
198-017
199-018
200.019
201-020
202-021
203-022
204-076
205-025
206-026
207-027
208-028
209-066
210-065
211-075
21
20
19
18-038
17
16-039
15-069
14
13-048
12-041
11
10-042
9-043
8
7-044
6-045
5
4
3-046
2-047
1-049
1-055
40-054
41-052
38
40-051
12/15/89
#18738-A
APPROVED
LORAIN CO.
MAP DEPT.
DATE 11-28-89
PAGE 6-88
BY T. McMain
VOID AFTER 18738-A