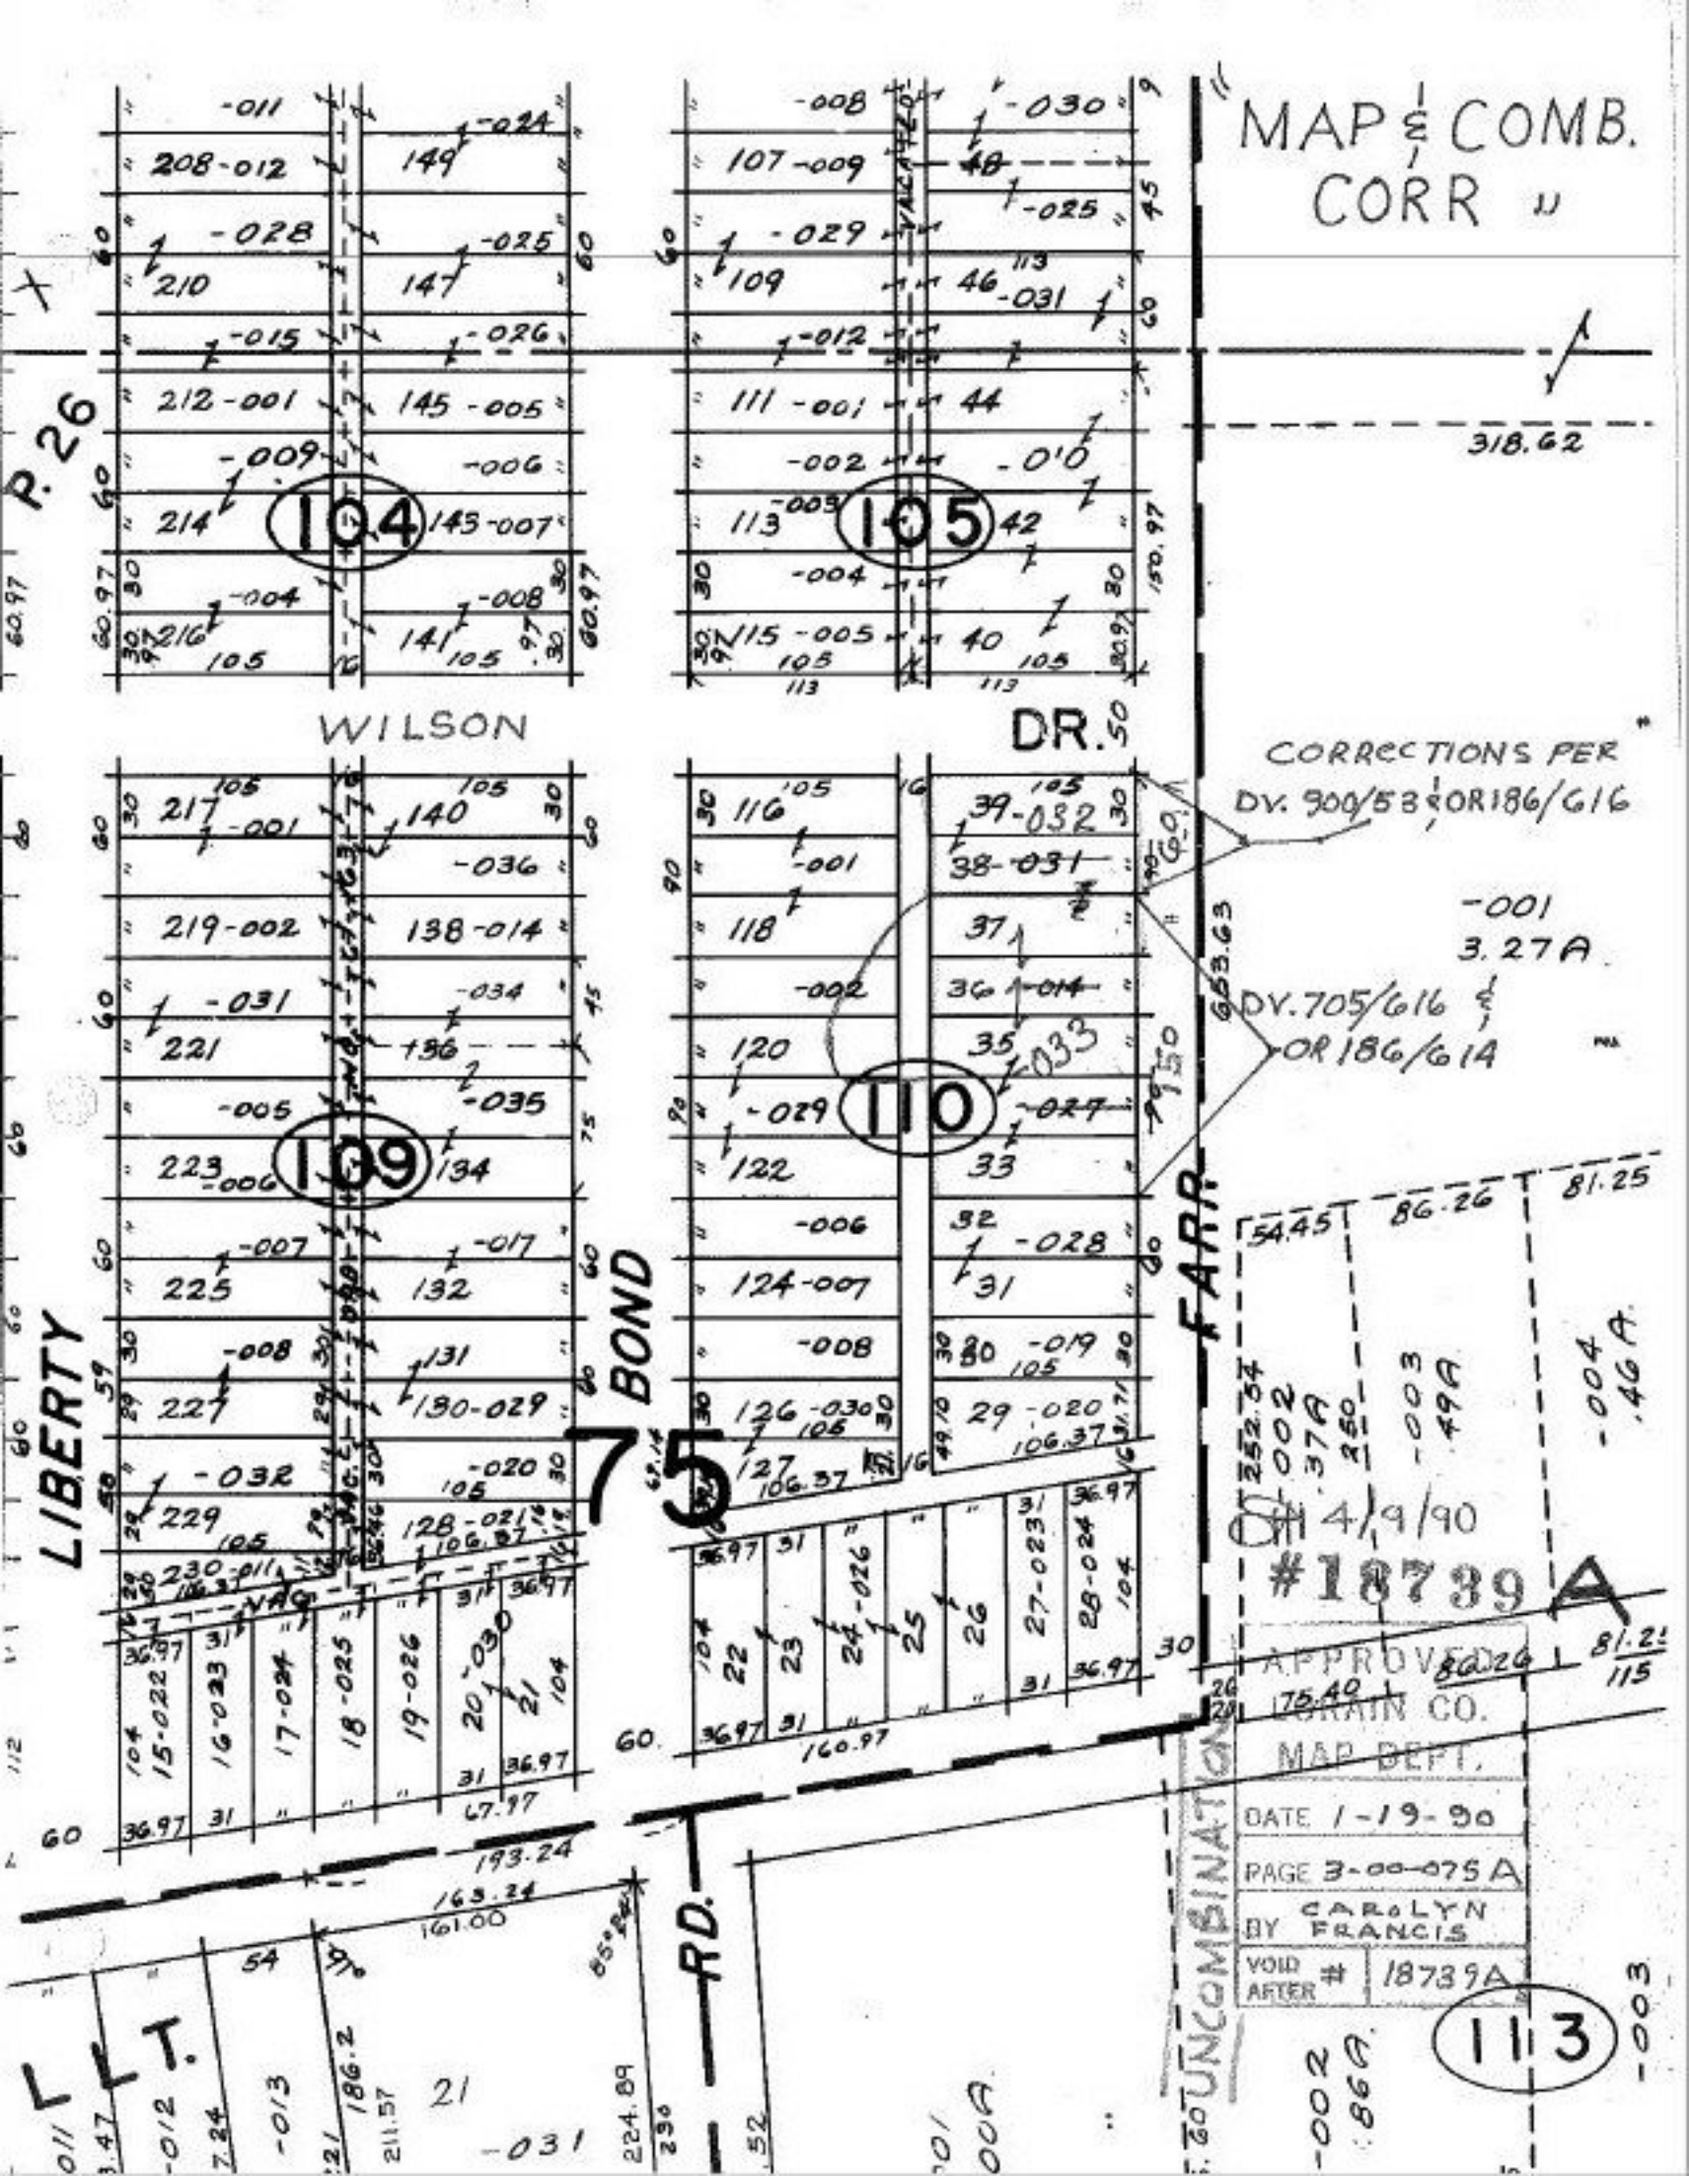
MAP & COMB. CORR
P. 26
WILSON
DR.
LIBERTY
BOND
FARR
RD.
104
105
109
110
113
CORRECTIONS PER DV. 900/58 & OR186/616
-001
3.27A
DV. 705/616 & OR 186/614
4/9/90
#18739A
APPROVED
LORAIN CO.
MAP DEPT.
DATE 1-19-90
PAGE 3-00-075A
BY CAROLYN FRANCIS
VOID AFTER # 18739A
UNCOMBINATION