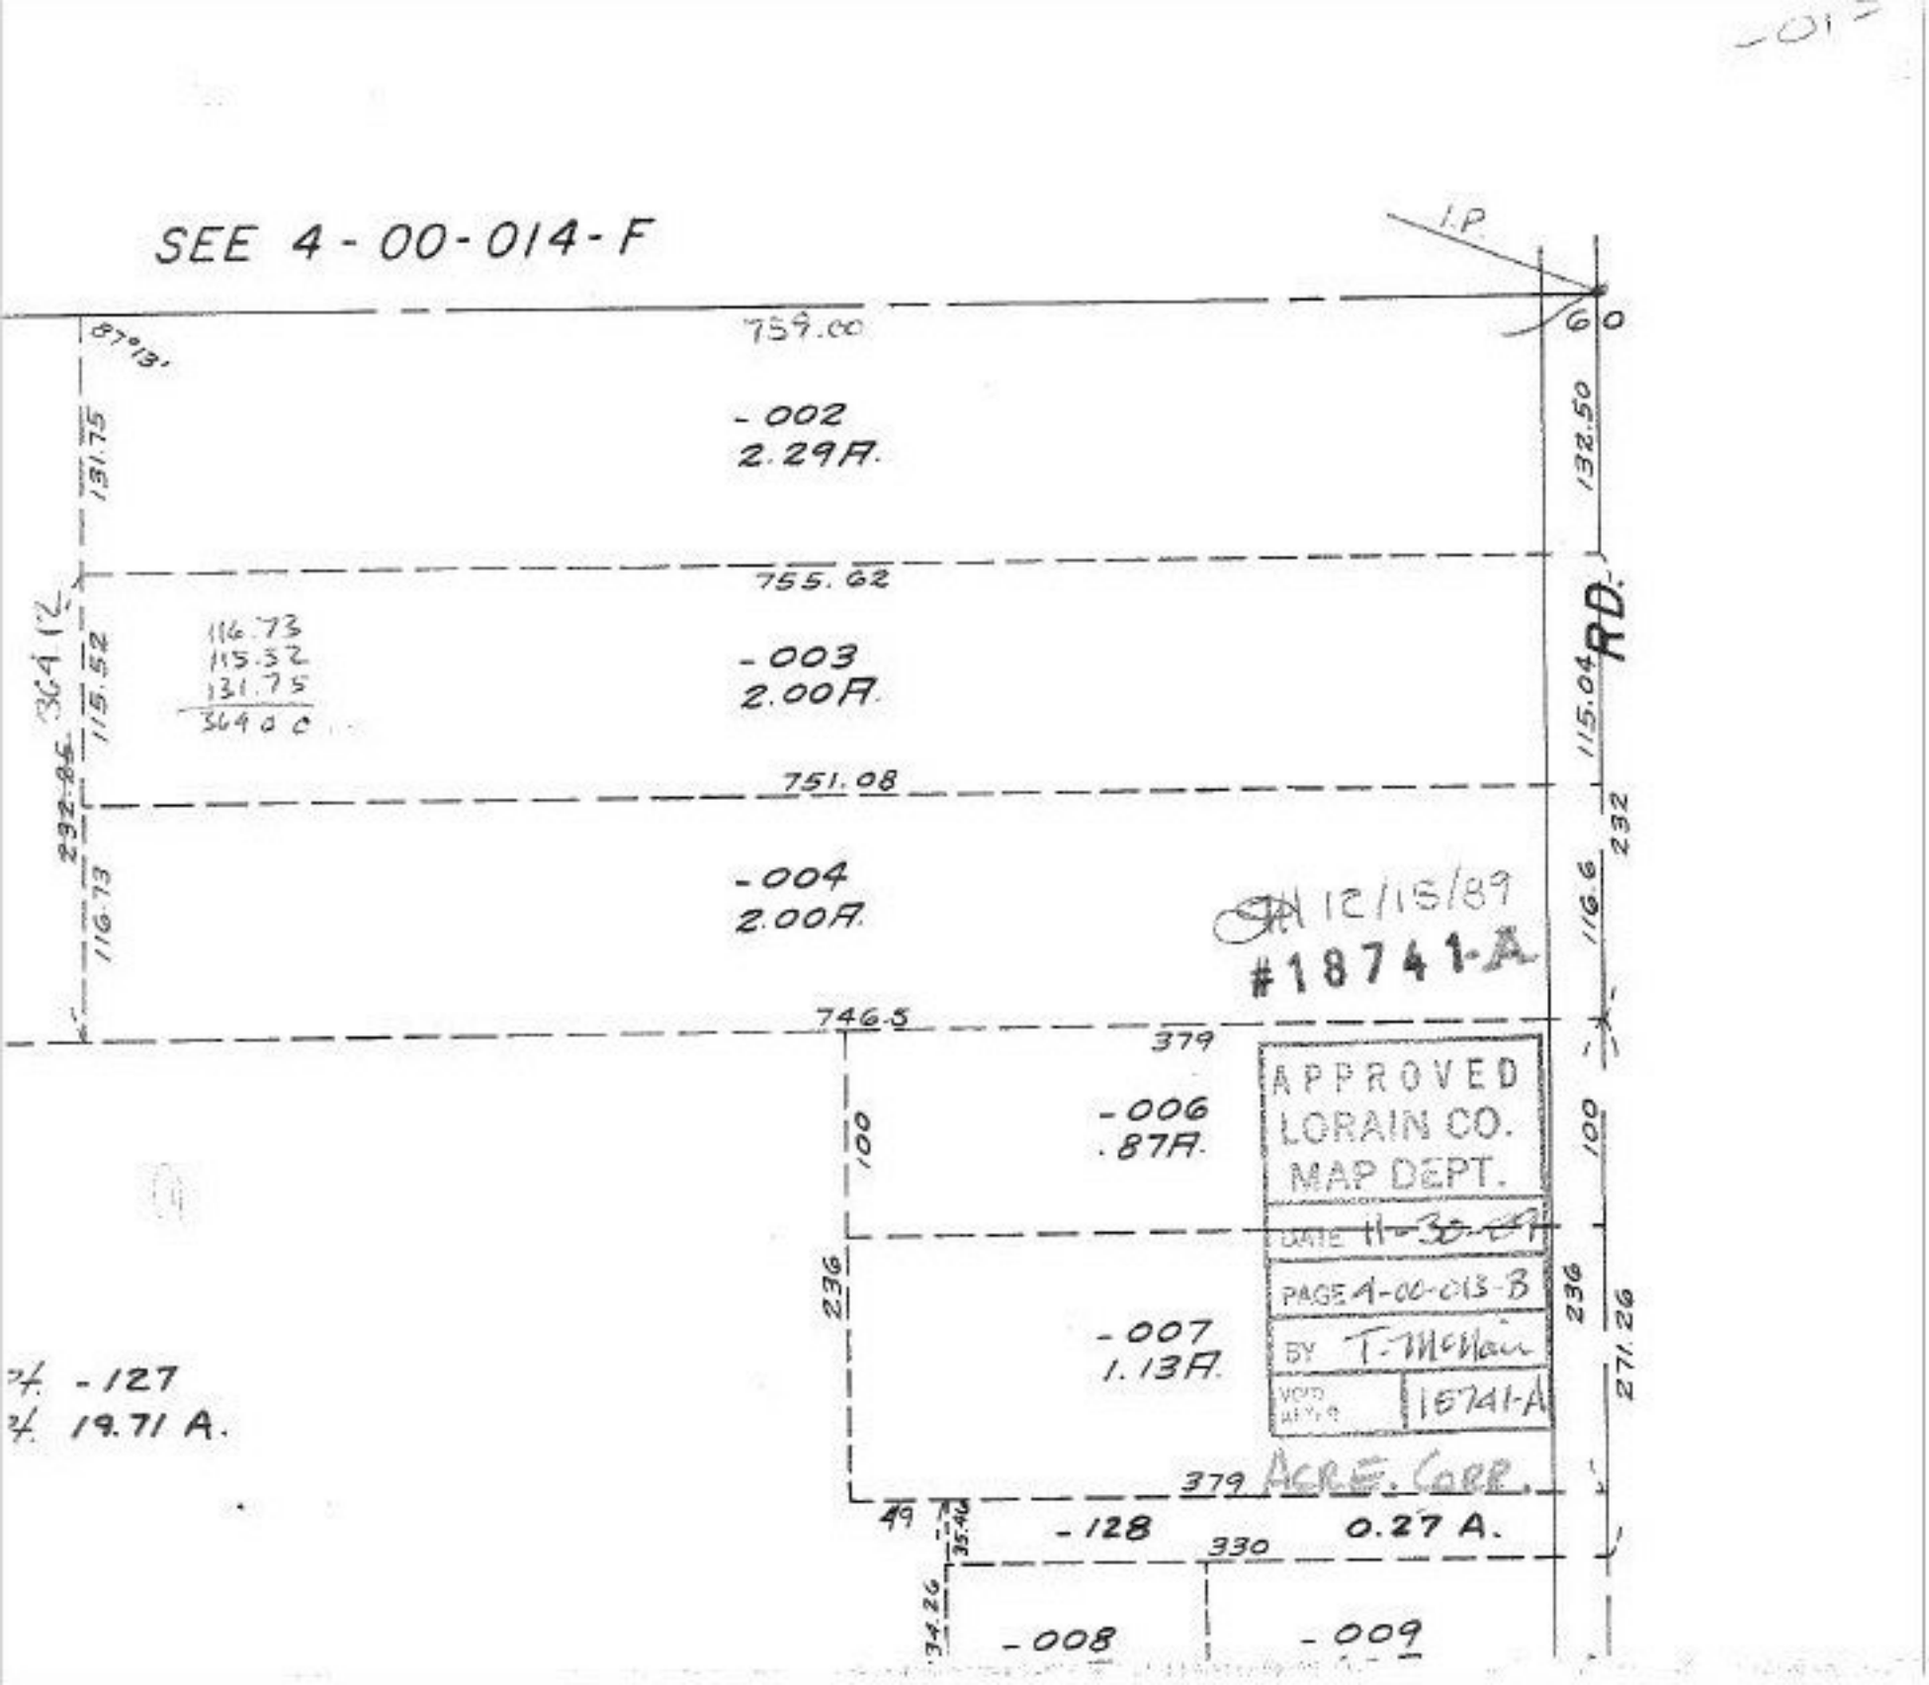
SEE 4-00-014-F
I.P
759.00
87°13'
131.75
-002
2.29A.
755.62
116.73
115.52
131.75
364.00
364.12
232.85
115.52
-003
2.00A.
751.08
116.73
-004
2.00A.
12/15/89
#18741-A
746.5
379
APPROVED
LORAIN CO.
MAP DEPT.
DATE 11-30-89
PAGE A-00-013-B
BY T. McMan
VOID 11/1/9
18741-A
-006
.87A.
100
236
-007
1.13A.
379
ACRE. CORR.
49
35.40
-128
330
0.27 A.
34.26
-008
-009
132.50
115.04
RD.
232
116.6
100
236
271.26
-127
19.71 A.