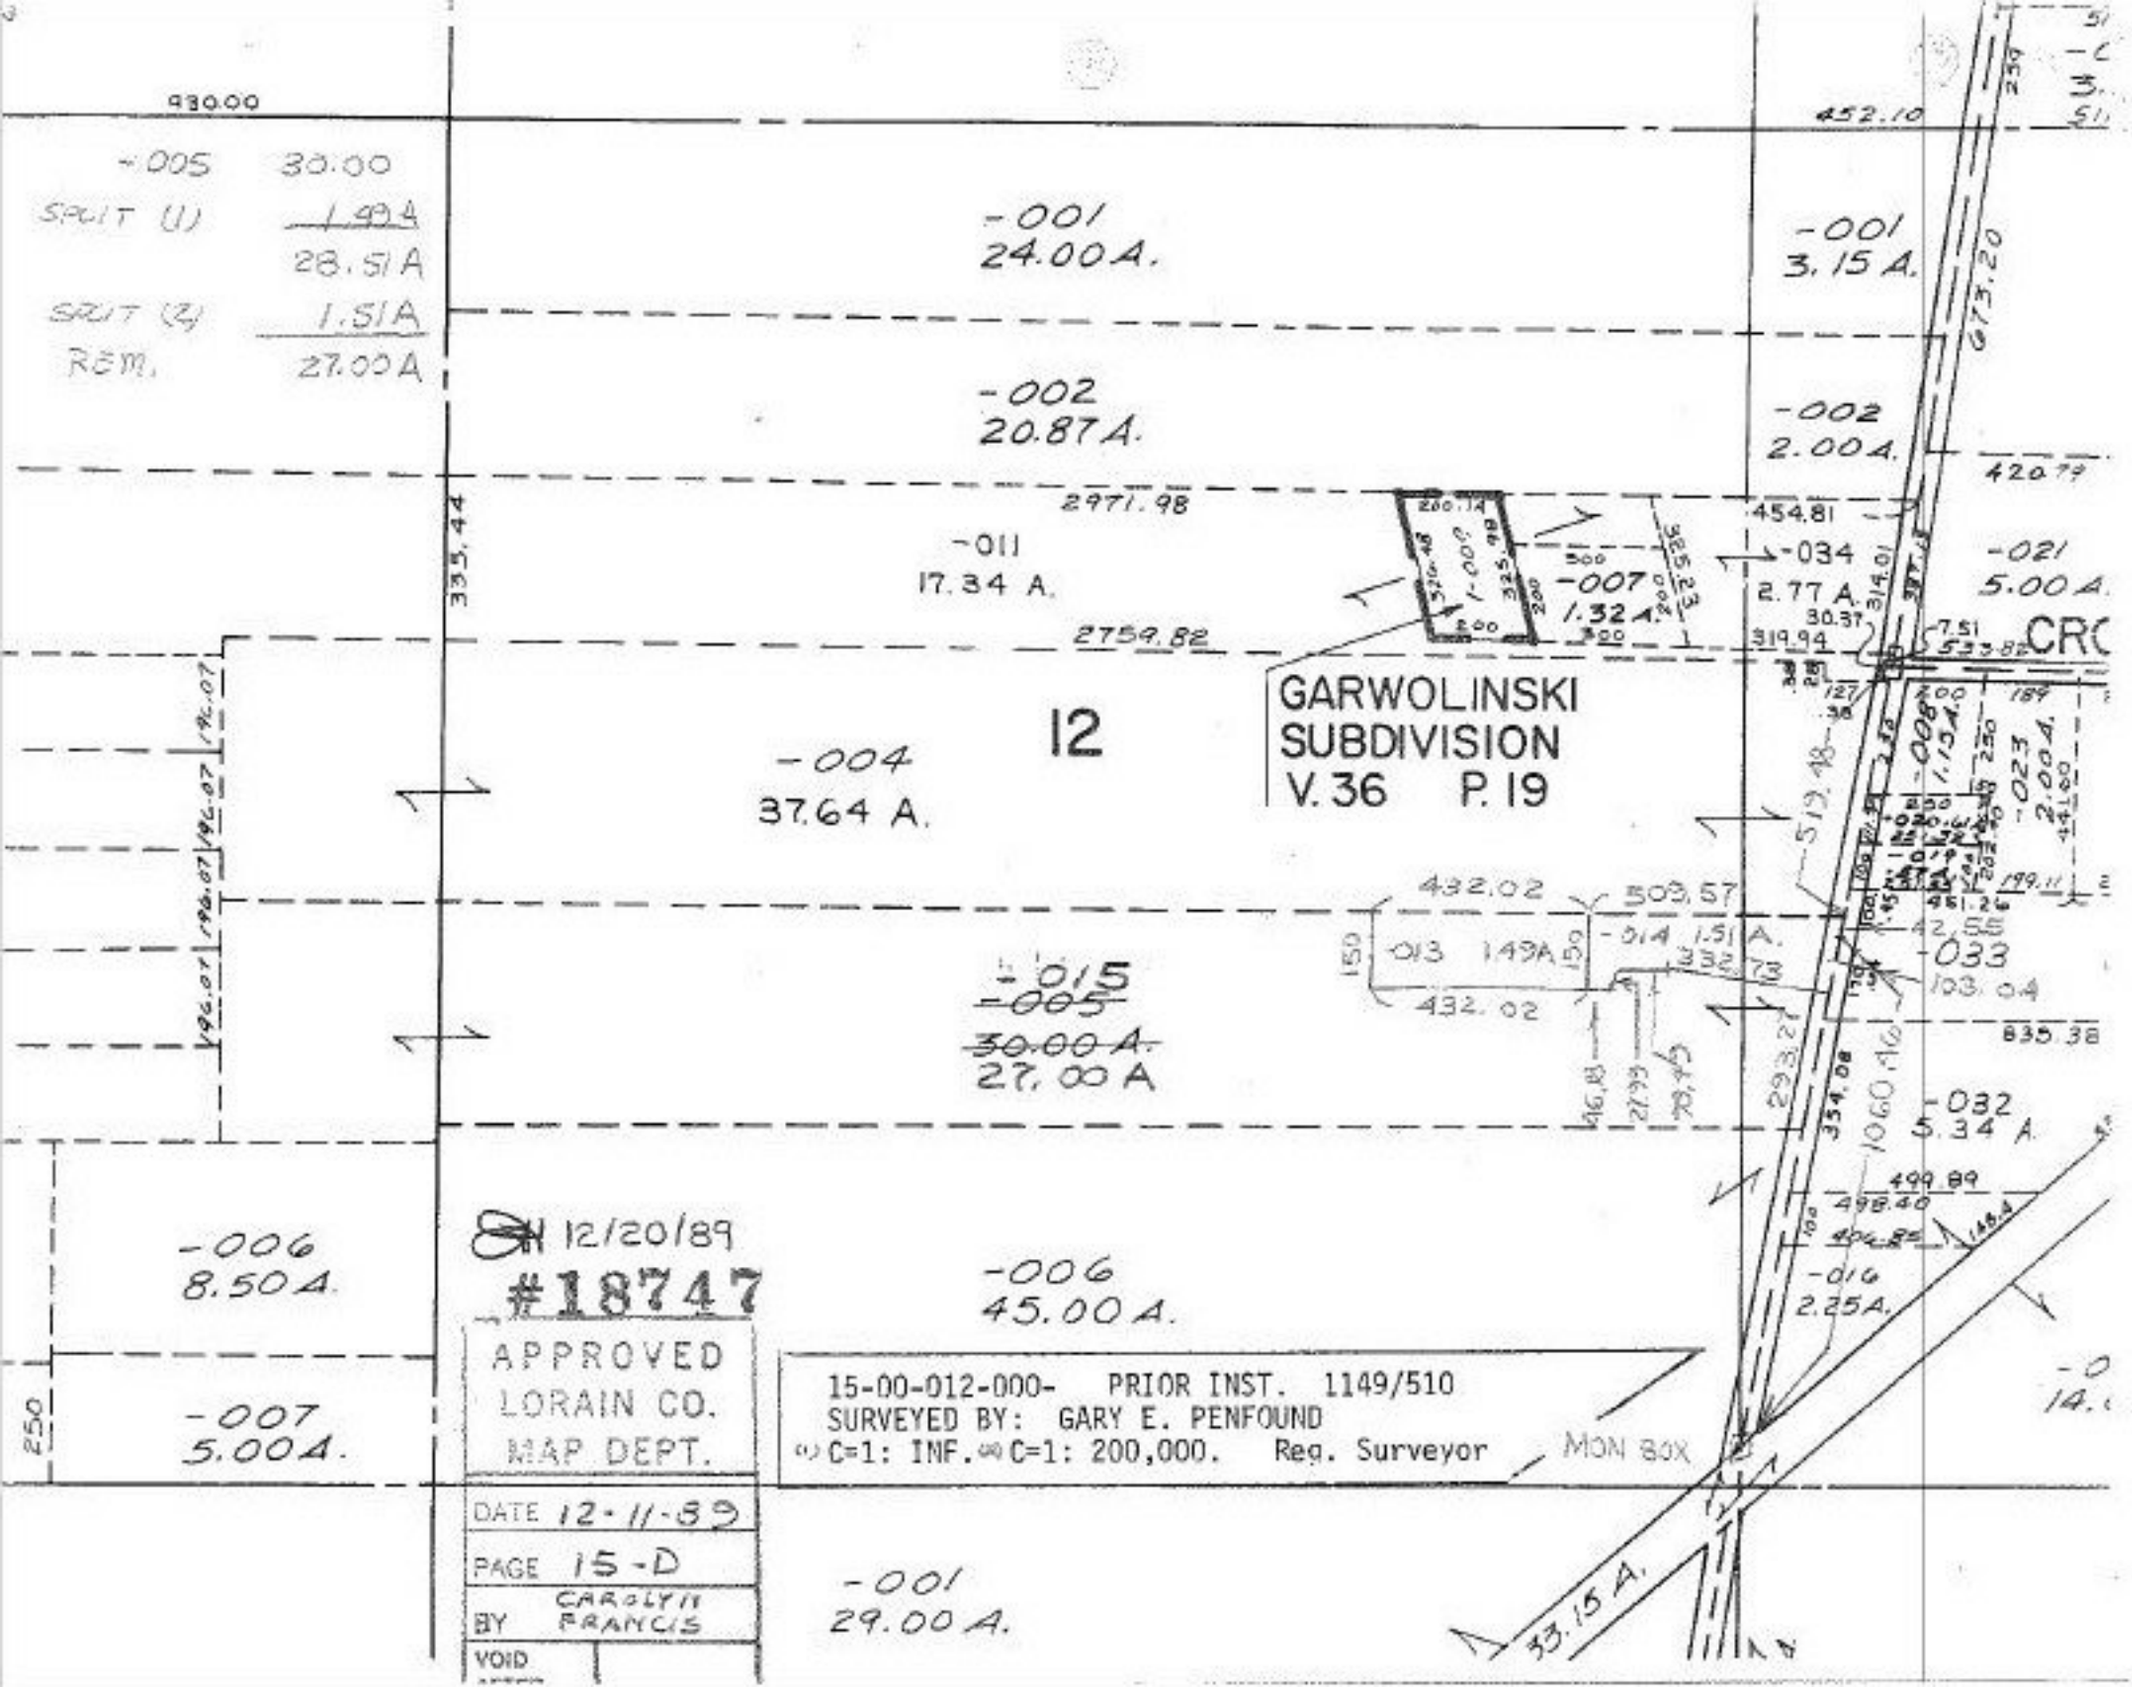

930.00
-005 30.00
SPLIT (1) 1.49A
28.51A
SPLIT (2) 1.51A
REM. 27.00A
-001
24.00A.
-001
3.15A.
-002
20.87A.
-002
2.00A.
2971.98
-011
17.34 A.
-007
1.32A.
-034
2.77 A.
-021
5.00A.
2759.82
GARWOLINSKI
SUBDIVISION
V.36 P.19
12
-004
37.64 A.
-015
-005
30.00A.
27.00A
-033
-032
5.34 A.
-006
8.50A.
-006
45.00A.
-016
2.25A.
-007
5.00A.
-001
29.00A.
33.15 A.
MON BOX
12/20/89
#18747
APPROVED
LORAIN CO.
MAP DEPT.
DATE 12-11-89
PAGE 15-D
BY CAROLYN FRANCIS
VOID
15-00-012-000- PRIOR INST. 1149/510
SURVEYED BY: GARY E. PENFOUND
C=1: INF. C=1: 200,000. Reg. Surveyor