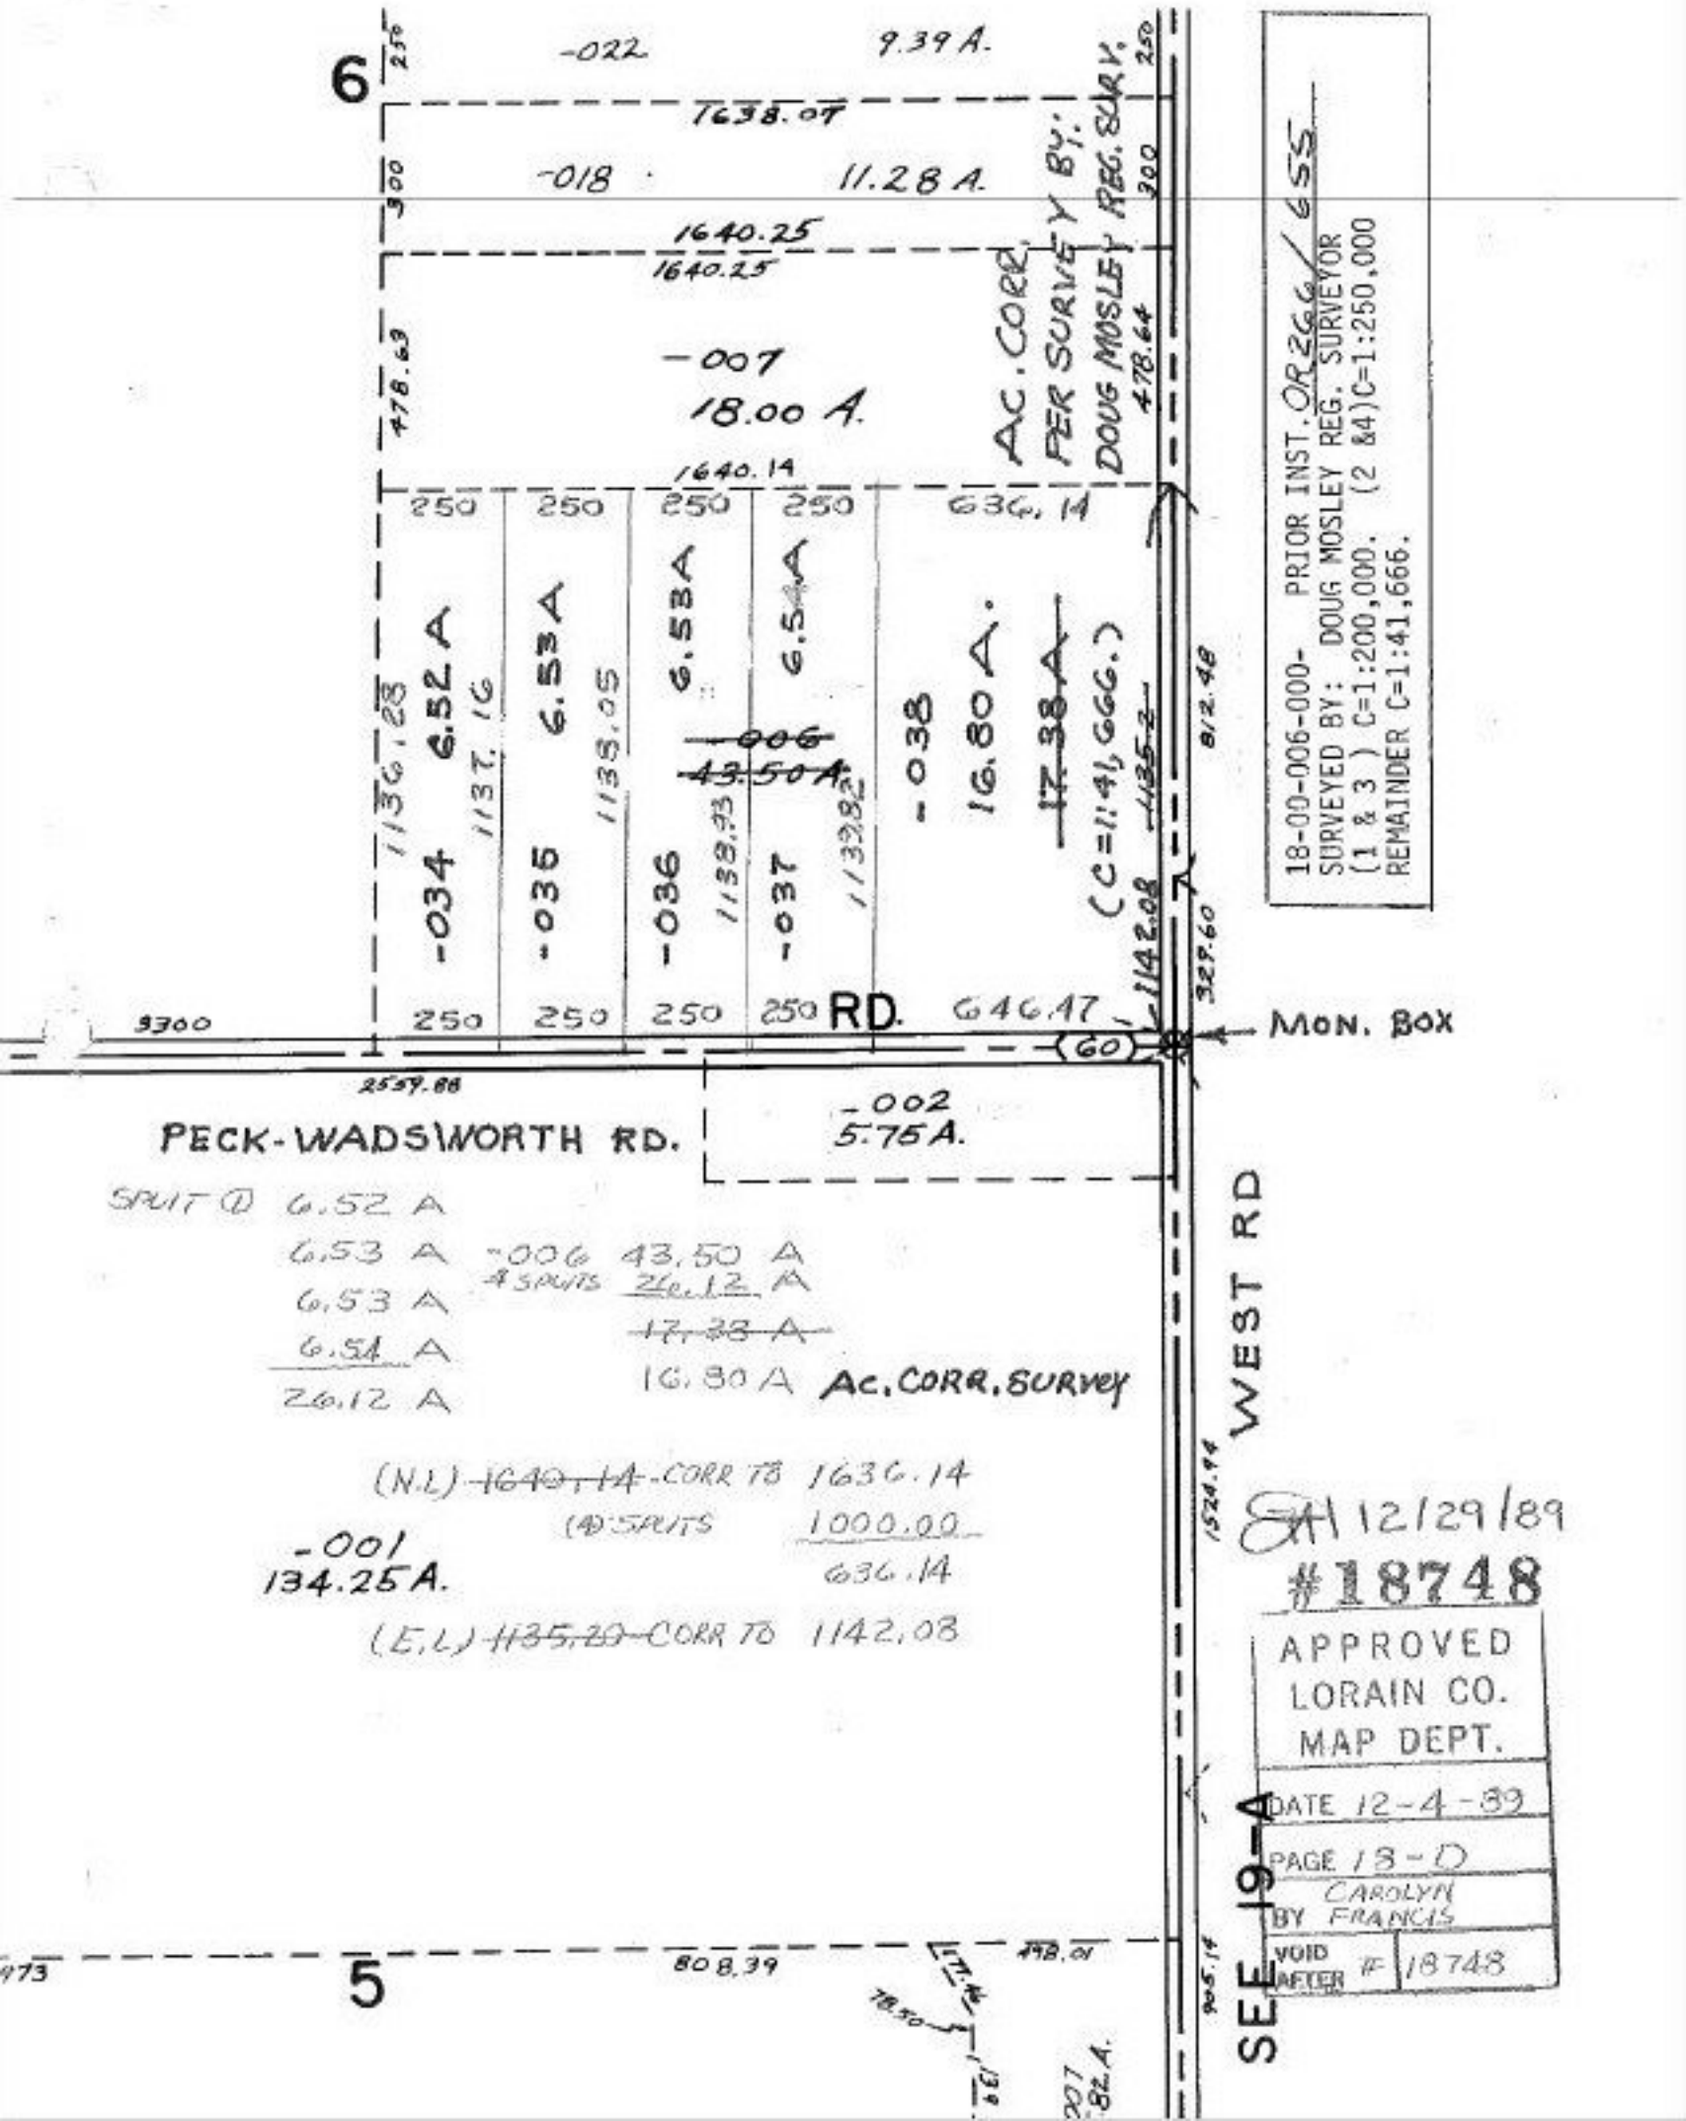
6
-022
9.39 A.
1638.07
-018
11.28 A.
1640.25
1640.25
-007
18.00 A.
1640.14
AC. CORR. PER SURVEY BY: DOUG MOSLEY REG. SURVEYOR
478.63
478.64
250
250
250
250
250
636.14
6.52 A
6.53 A
6.53 A
6.54 A
-034
-035
-036
-037
-006
43.50 A
-038
16.80 A.
17.38 A
(C=1141, GGG.)
1136.28
1137.16
1138.05
1138.93
1139.82
1135.2
812.48
1142.08
329.60
18-00-006-000- PRIOR INST. OR 2666 / 655
SURVEYED BY: DOUG MOSLEY REG. SURVEYOR
(1 & 3) C=1:200,000. (2 &4) C=1:250,000
REMAINDER C=1:41,666.
9300
250
250
250
250
RD.
646.47
60
MON. BOX
2539.88
PECK-WADSWORTH RD.
-002
5.75 A.
SPLIT ① 6.52 A
6.53 A
6.53 A
6.54 A
26.12 A
-006 43.50 A
4 SPLITS 26.12 A
17.38 A
16.80 A AC. CORR. SURVEY
(N.L) 1640.14 CORR TO 1636.14
(4) SPLITS 1000.00
636.14
-001
134.25 A.
(E.L) 1135.20 CORR TO 1142.08
1524.94
WEST RD
12/29/89
#18748
APPROVED
LORAIN CO.
MAP DEPT.
DATE 12-4-89
PAGE 18-D
CAROLYN
BY FRANCIS
VOID AFTER # 18748
SEE 19-A
973
5
808.39
498.21
78.50
905.14
207
82 A.