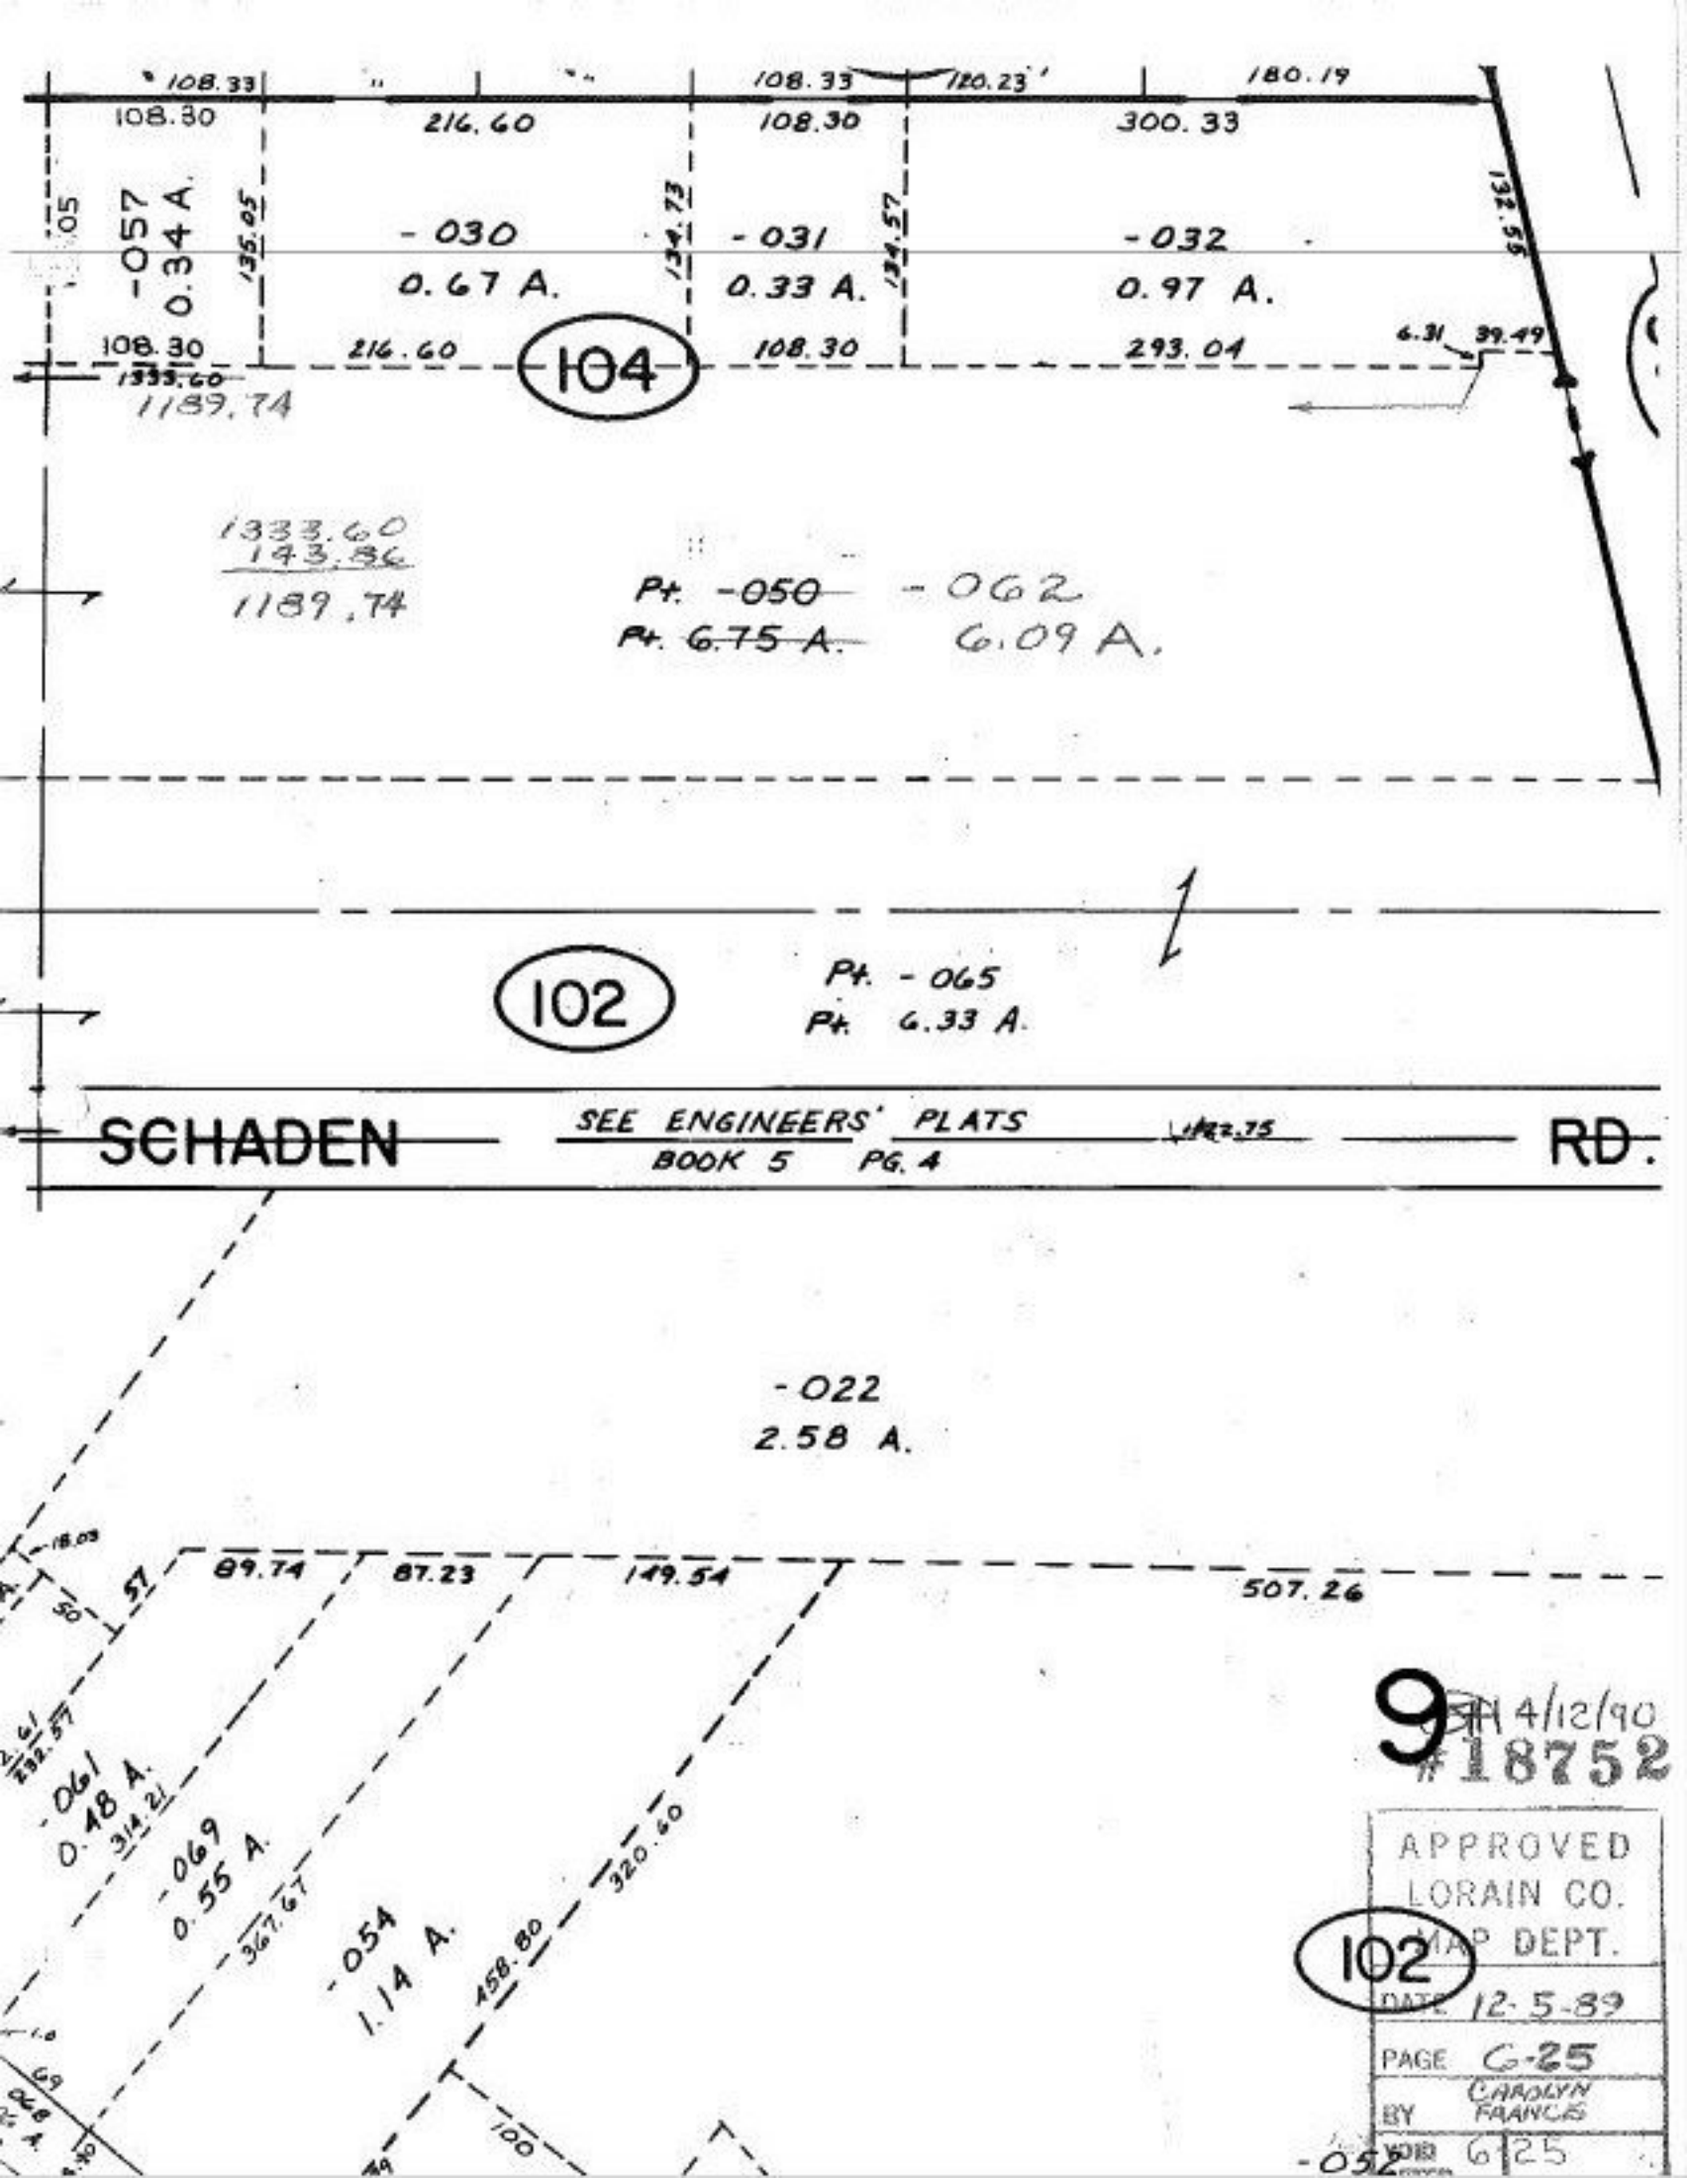

9 4/12/90
#18752

APPROVED
LORAIN CO.
MAP DEPT.
102
DATE 12-5-89
PAGE C-25
BY CAROLYN FRANCES
VOID 6125