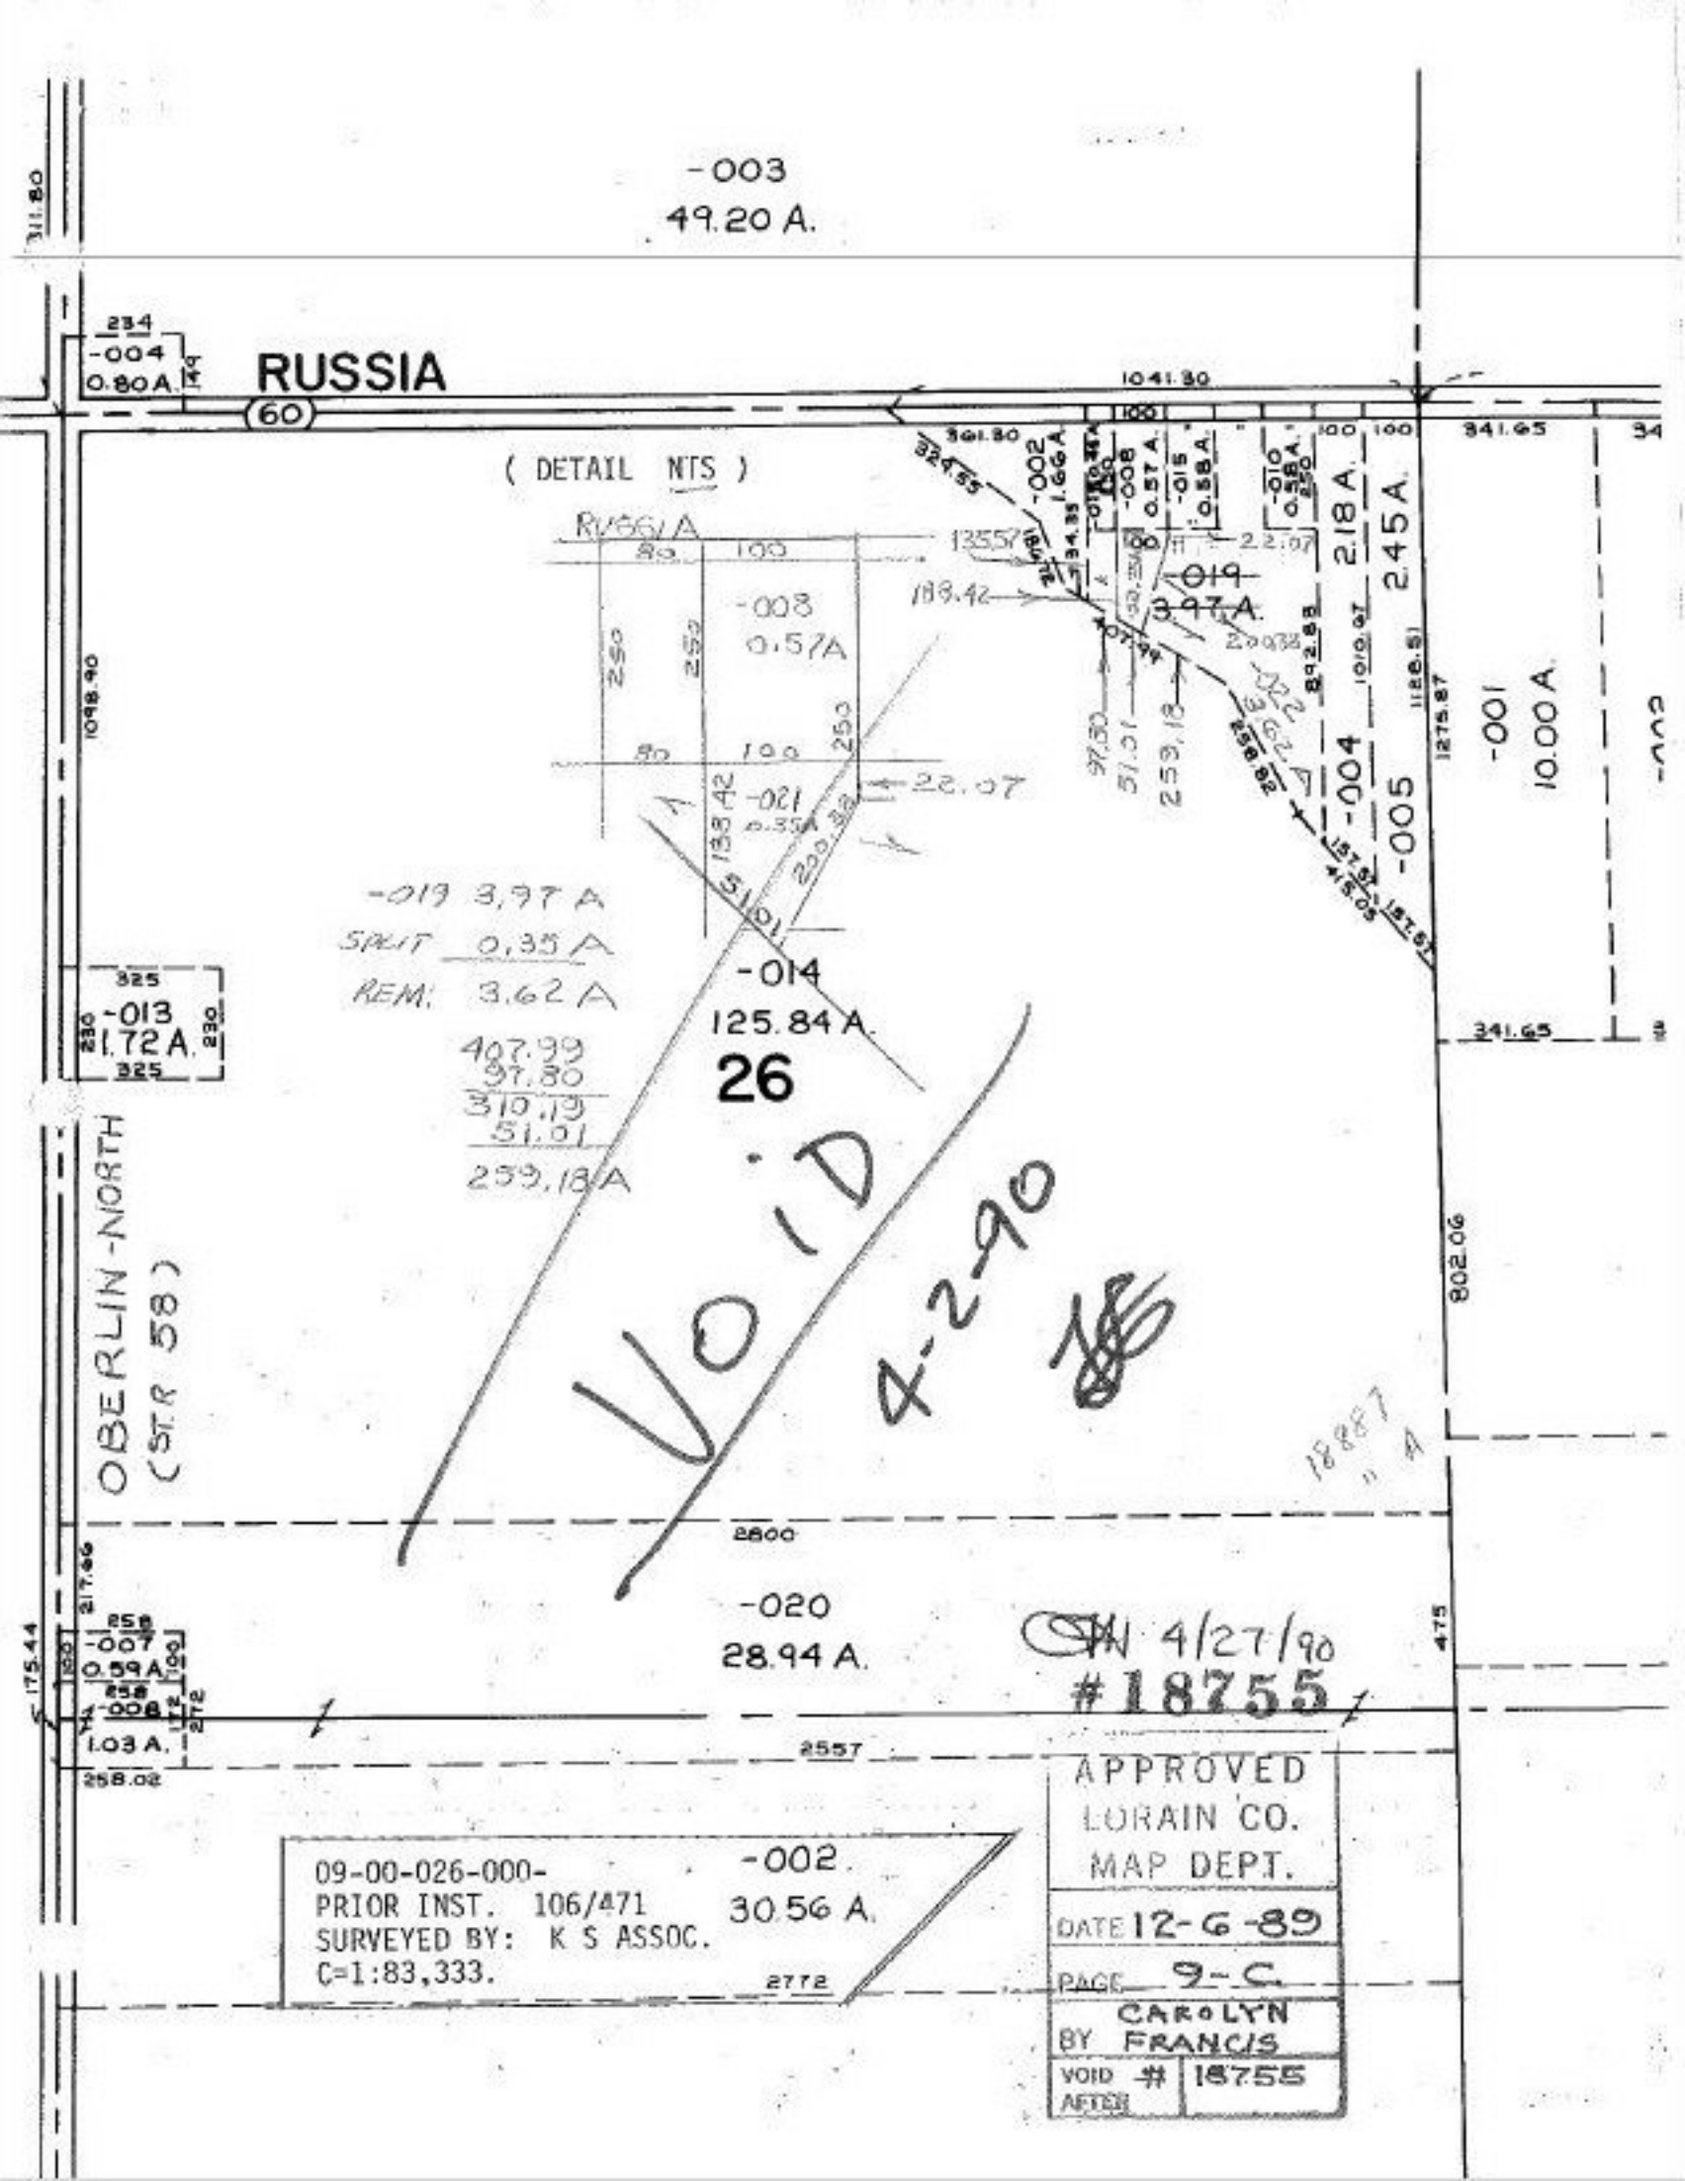
-003
49.20 A.
RUSSIA
60
-004
0.80 A.
1041.80
(DETAIL NTS)
-002
1.66 A.
-008
0.57 A.
-015
0.58 A.
-010
0.58 A.
2.18 A.
2.45 A.
-019
3.97 A.
-008
0.57 A.
-021
0.35 A.
22.07
-019 3.97 A
SPLIT 0.35 A
REM. 3.62 A
-013
1.72 A.
-014
125.84 A.
26
-004
-005
-001
10.00 A.
341.65
1098.90
1275.87
802.06
OBERLIN-NORTH
(ST.R 58)
-020
28.94 A.
-007
0.59 A.
-006
1.03 A.
258.02
2557
2772
2800
475
VOID
4-2-90
4/27/90
#18755
09-00-026-000-
PRIOR INST. 106/471
SURVEYED BY: K S ASSOC.
C=1:83,333.
-002
30.56 A.
APPROVED
LORAIN CO.
MAP DEPT.
DATE 12-6-89
PAGE 9-C
BY CAROLYN FRANCIS
VOID # AFTER 18755