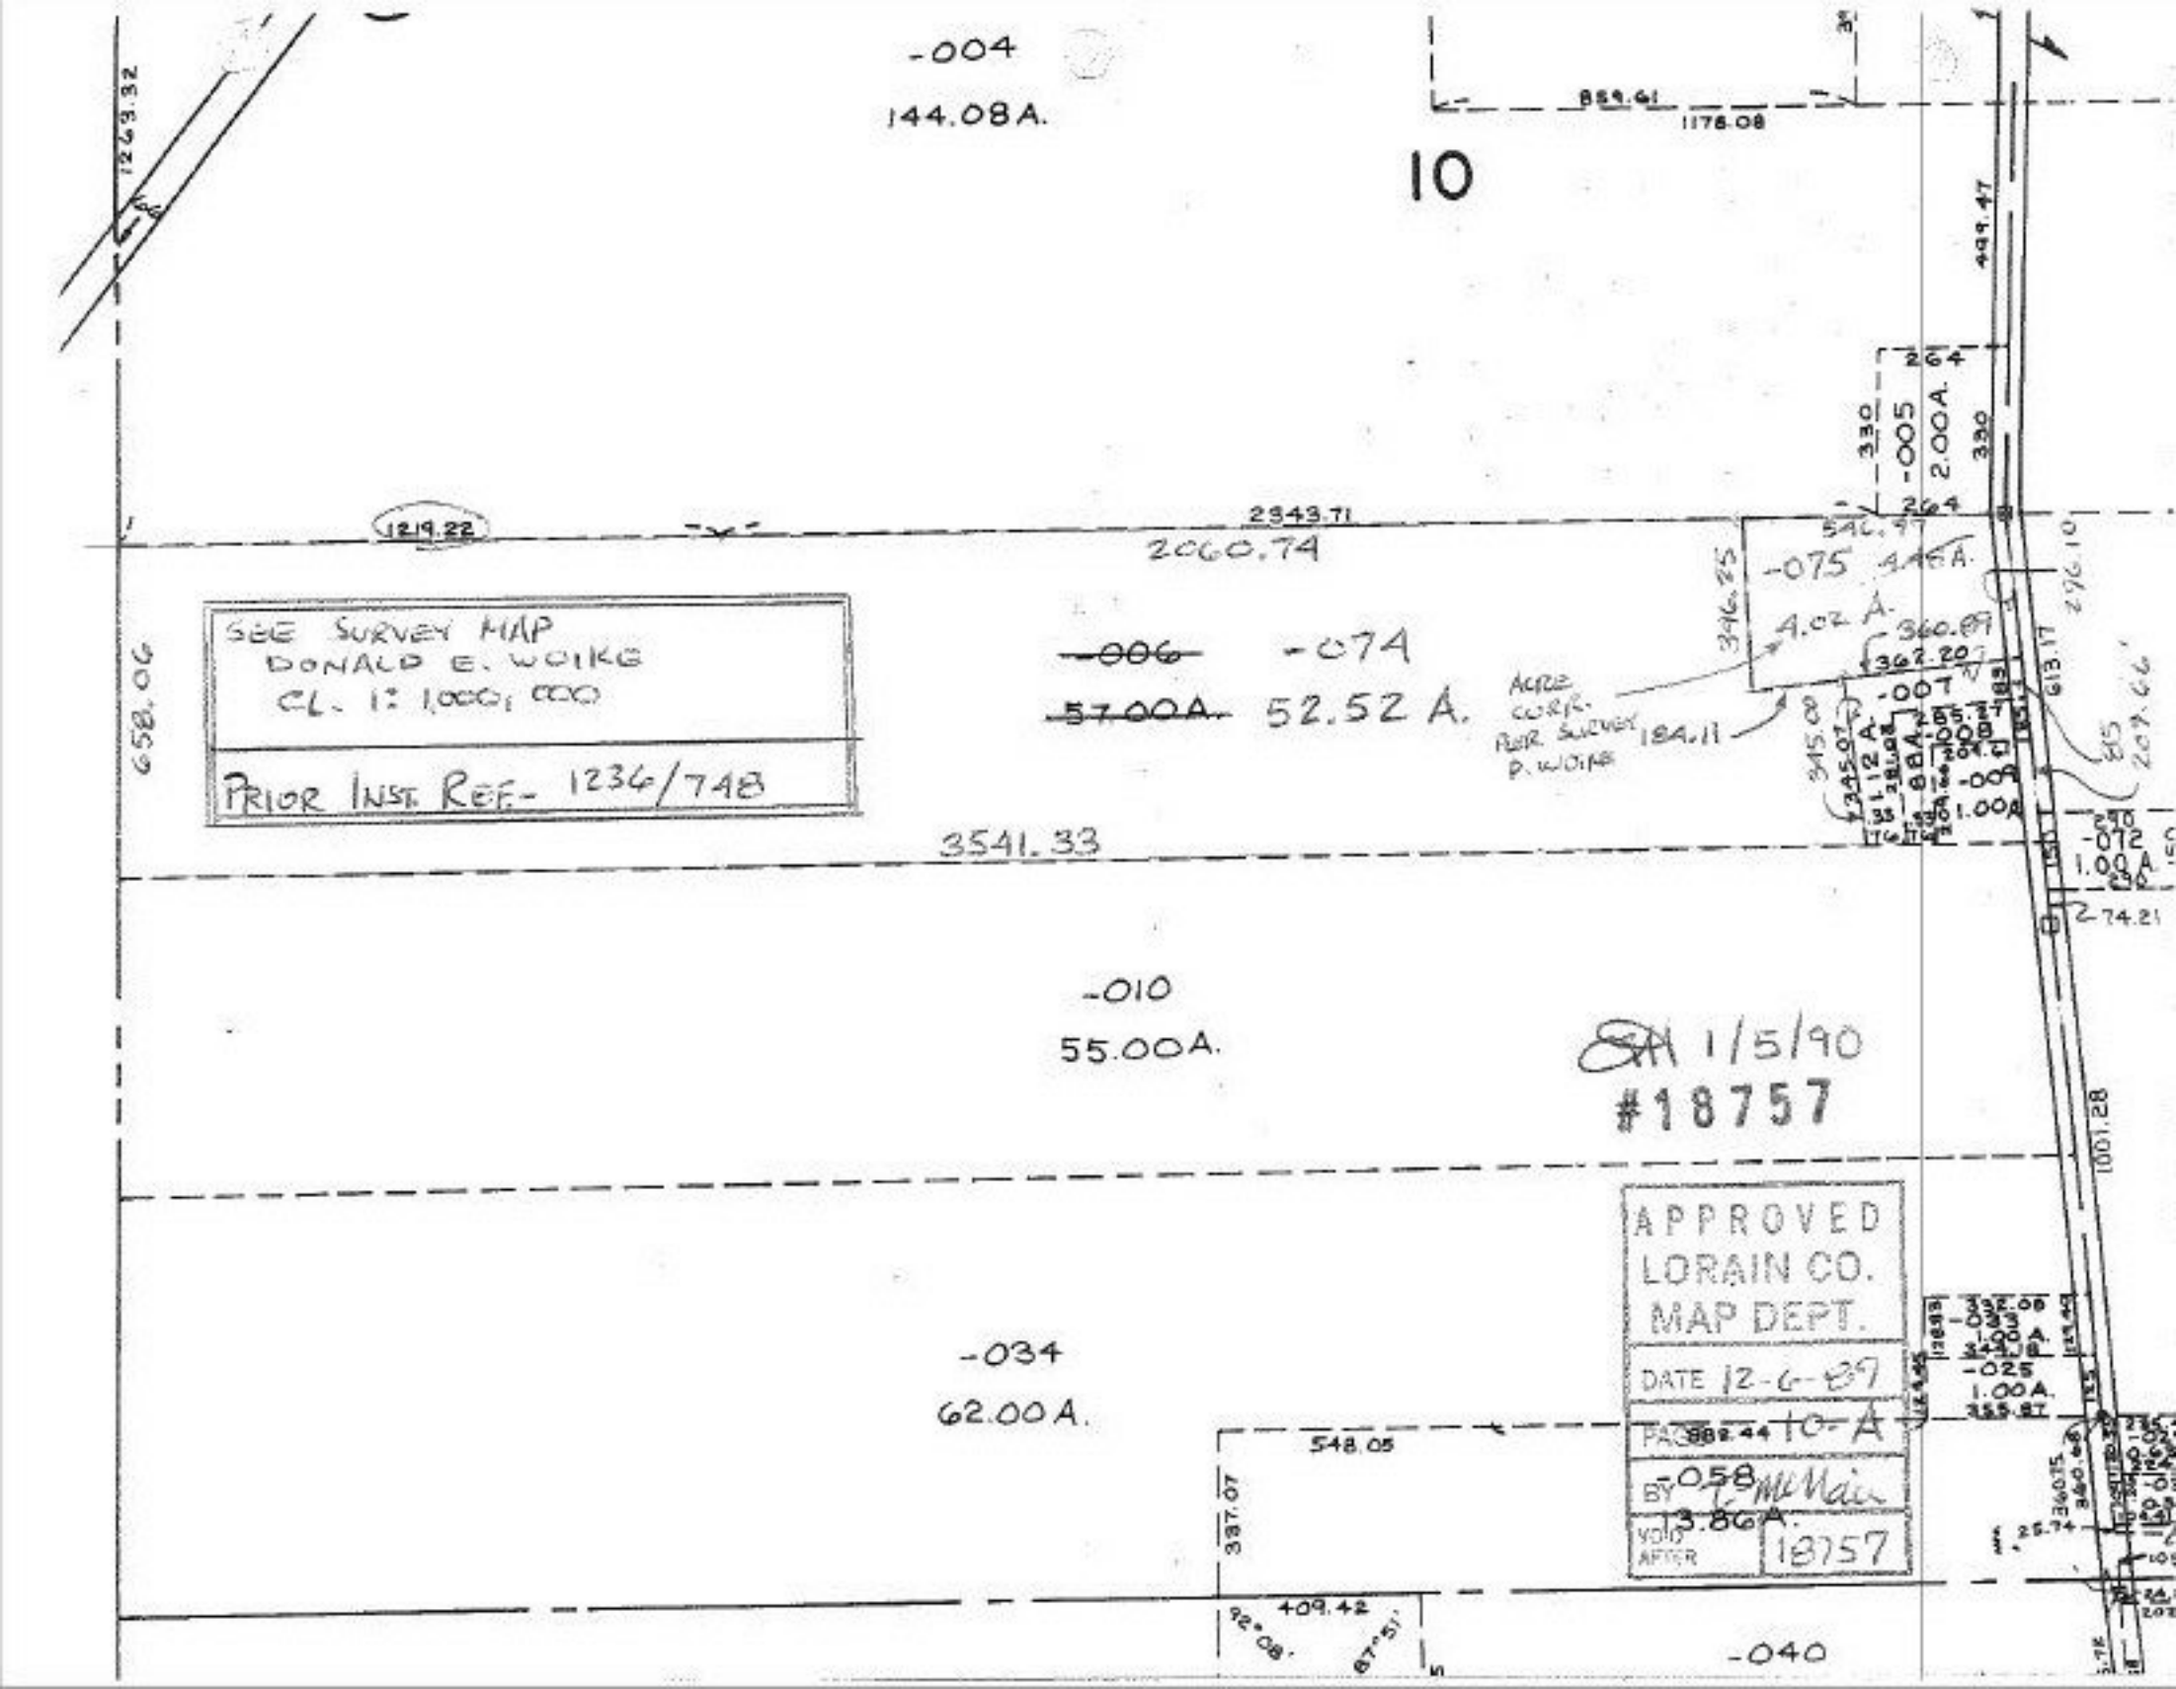

SEE SURVEY MAP
DONALD E. WOIKE
CL. 1: 1,000; 000

PRIOR INST. REF.- 1236/748