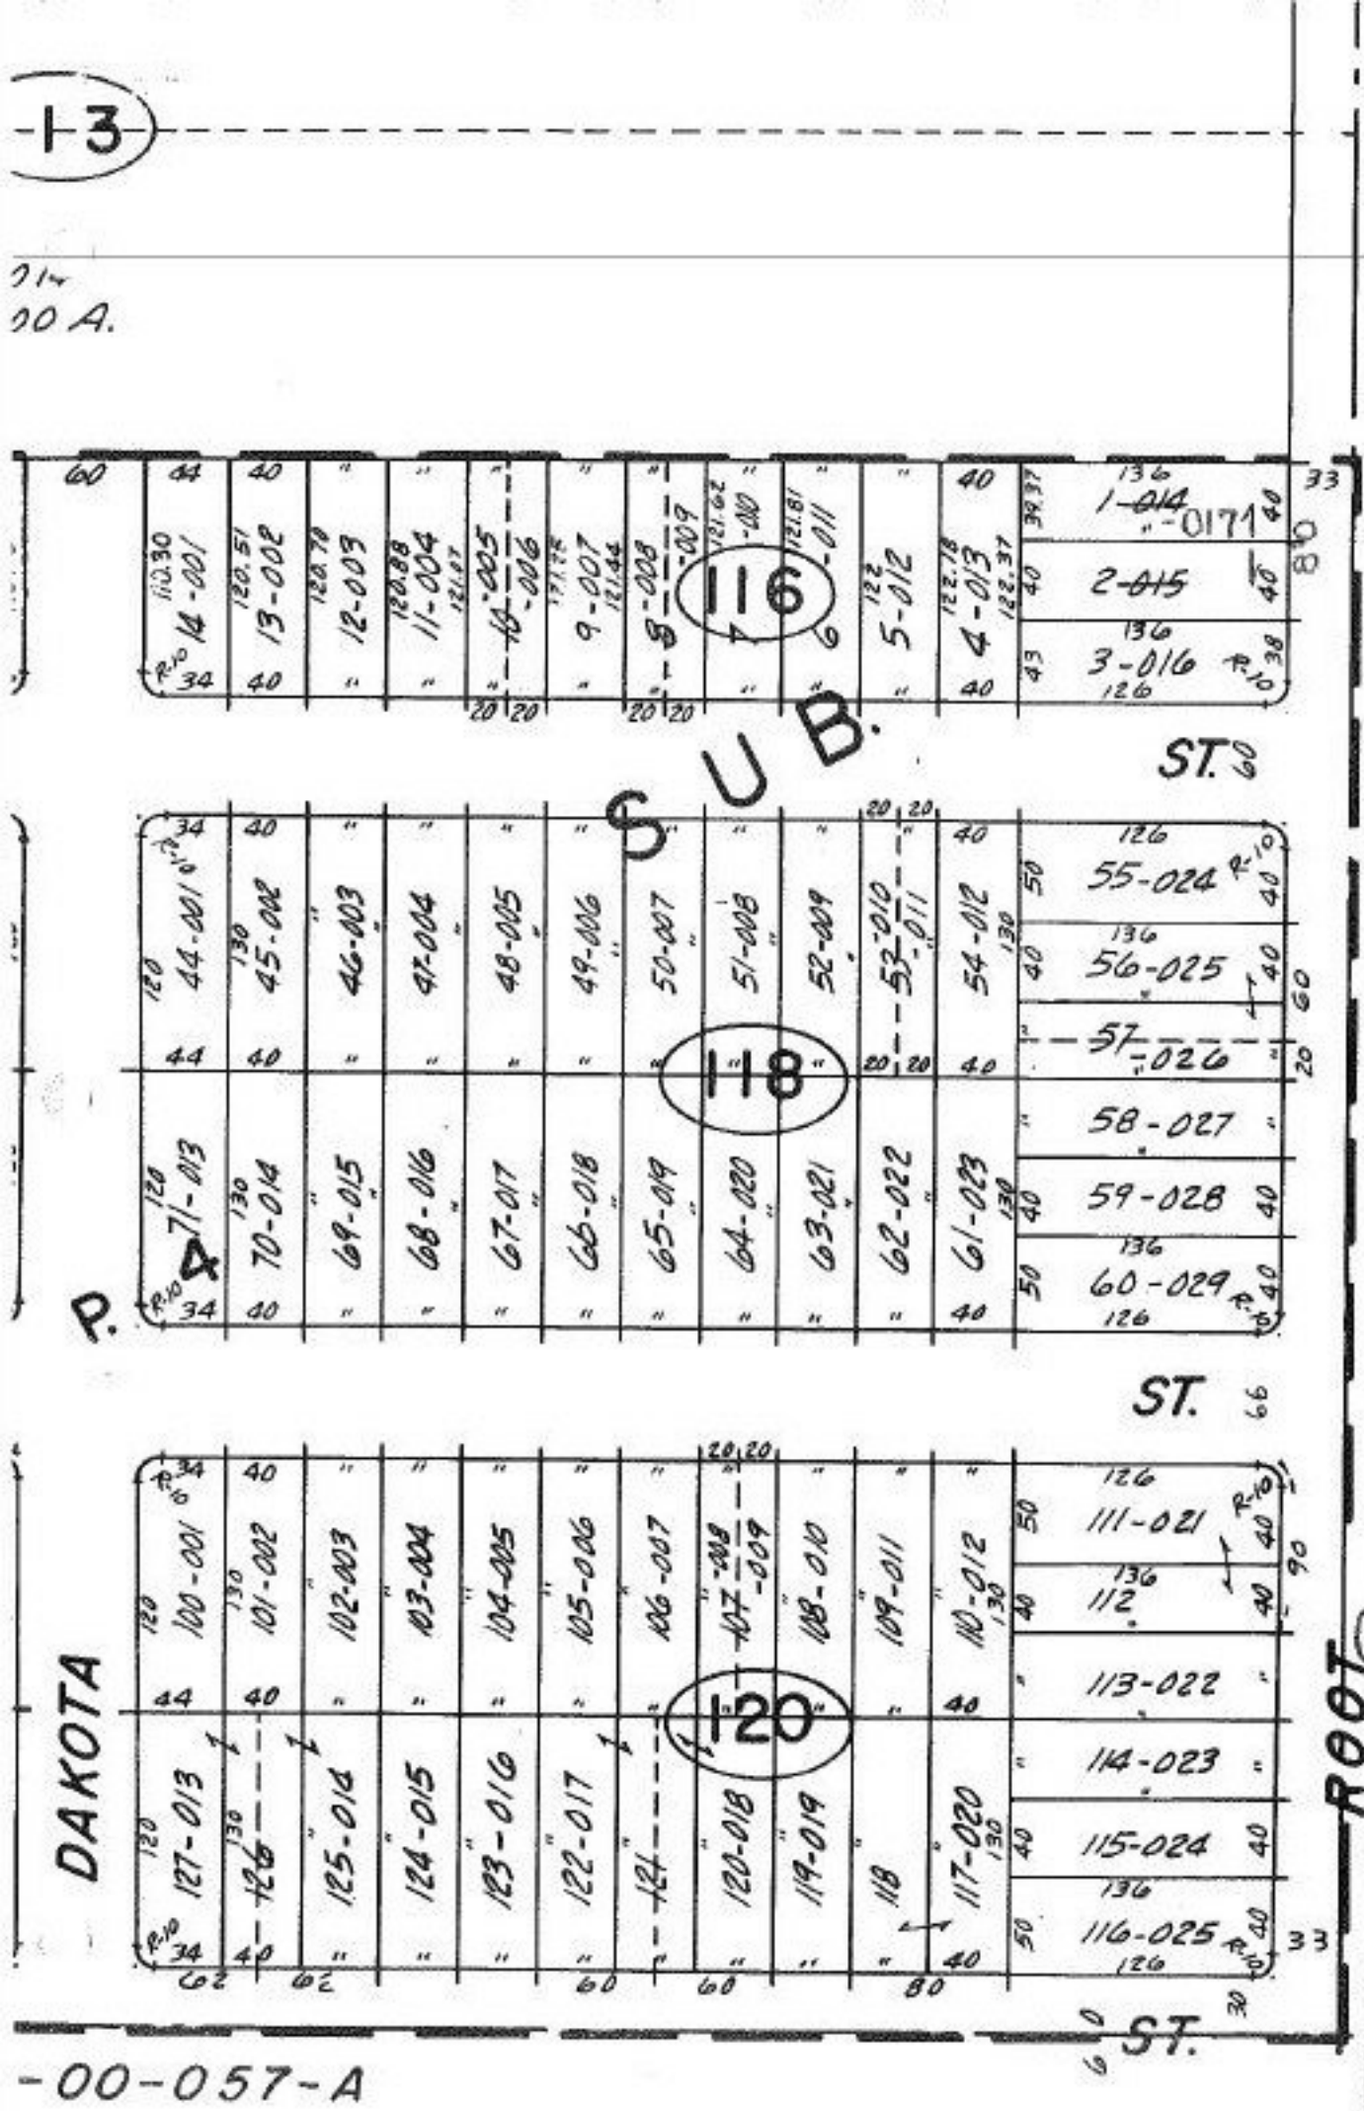

SH 12/15/89
COMBINATION
#18758-A

APPROVED
LORAIN CO.
MAP DEPT.

DATE 12/7/89

PAGE 3-00-046-B

BY T. HOLLIS

VOID AFTER 18758-A