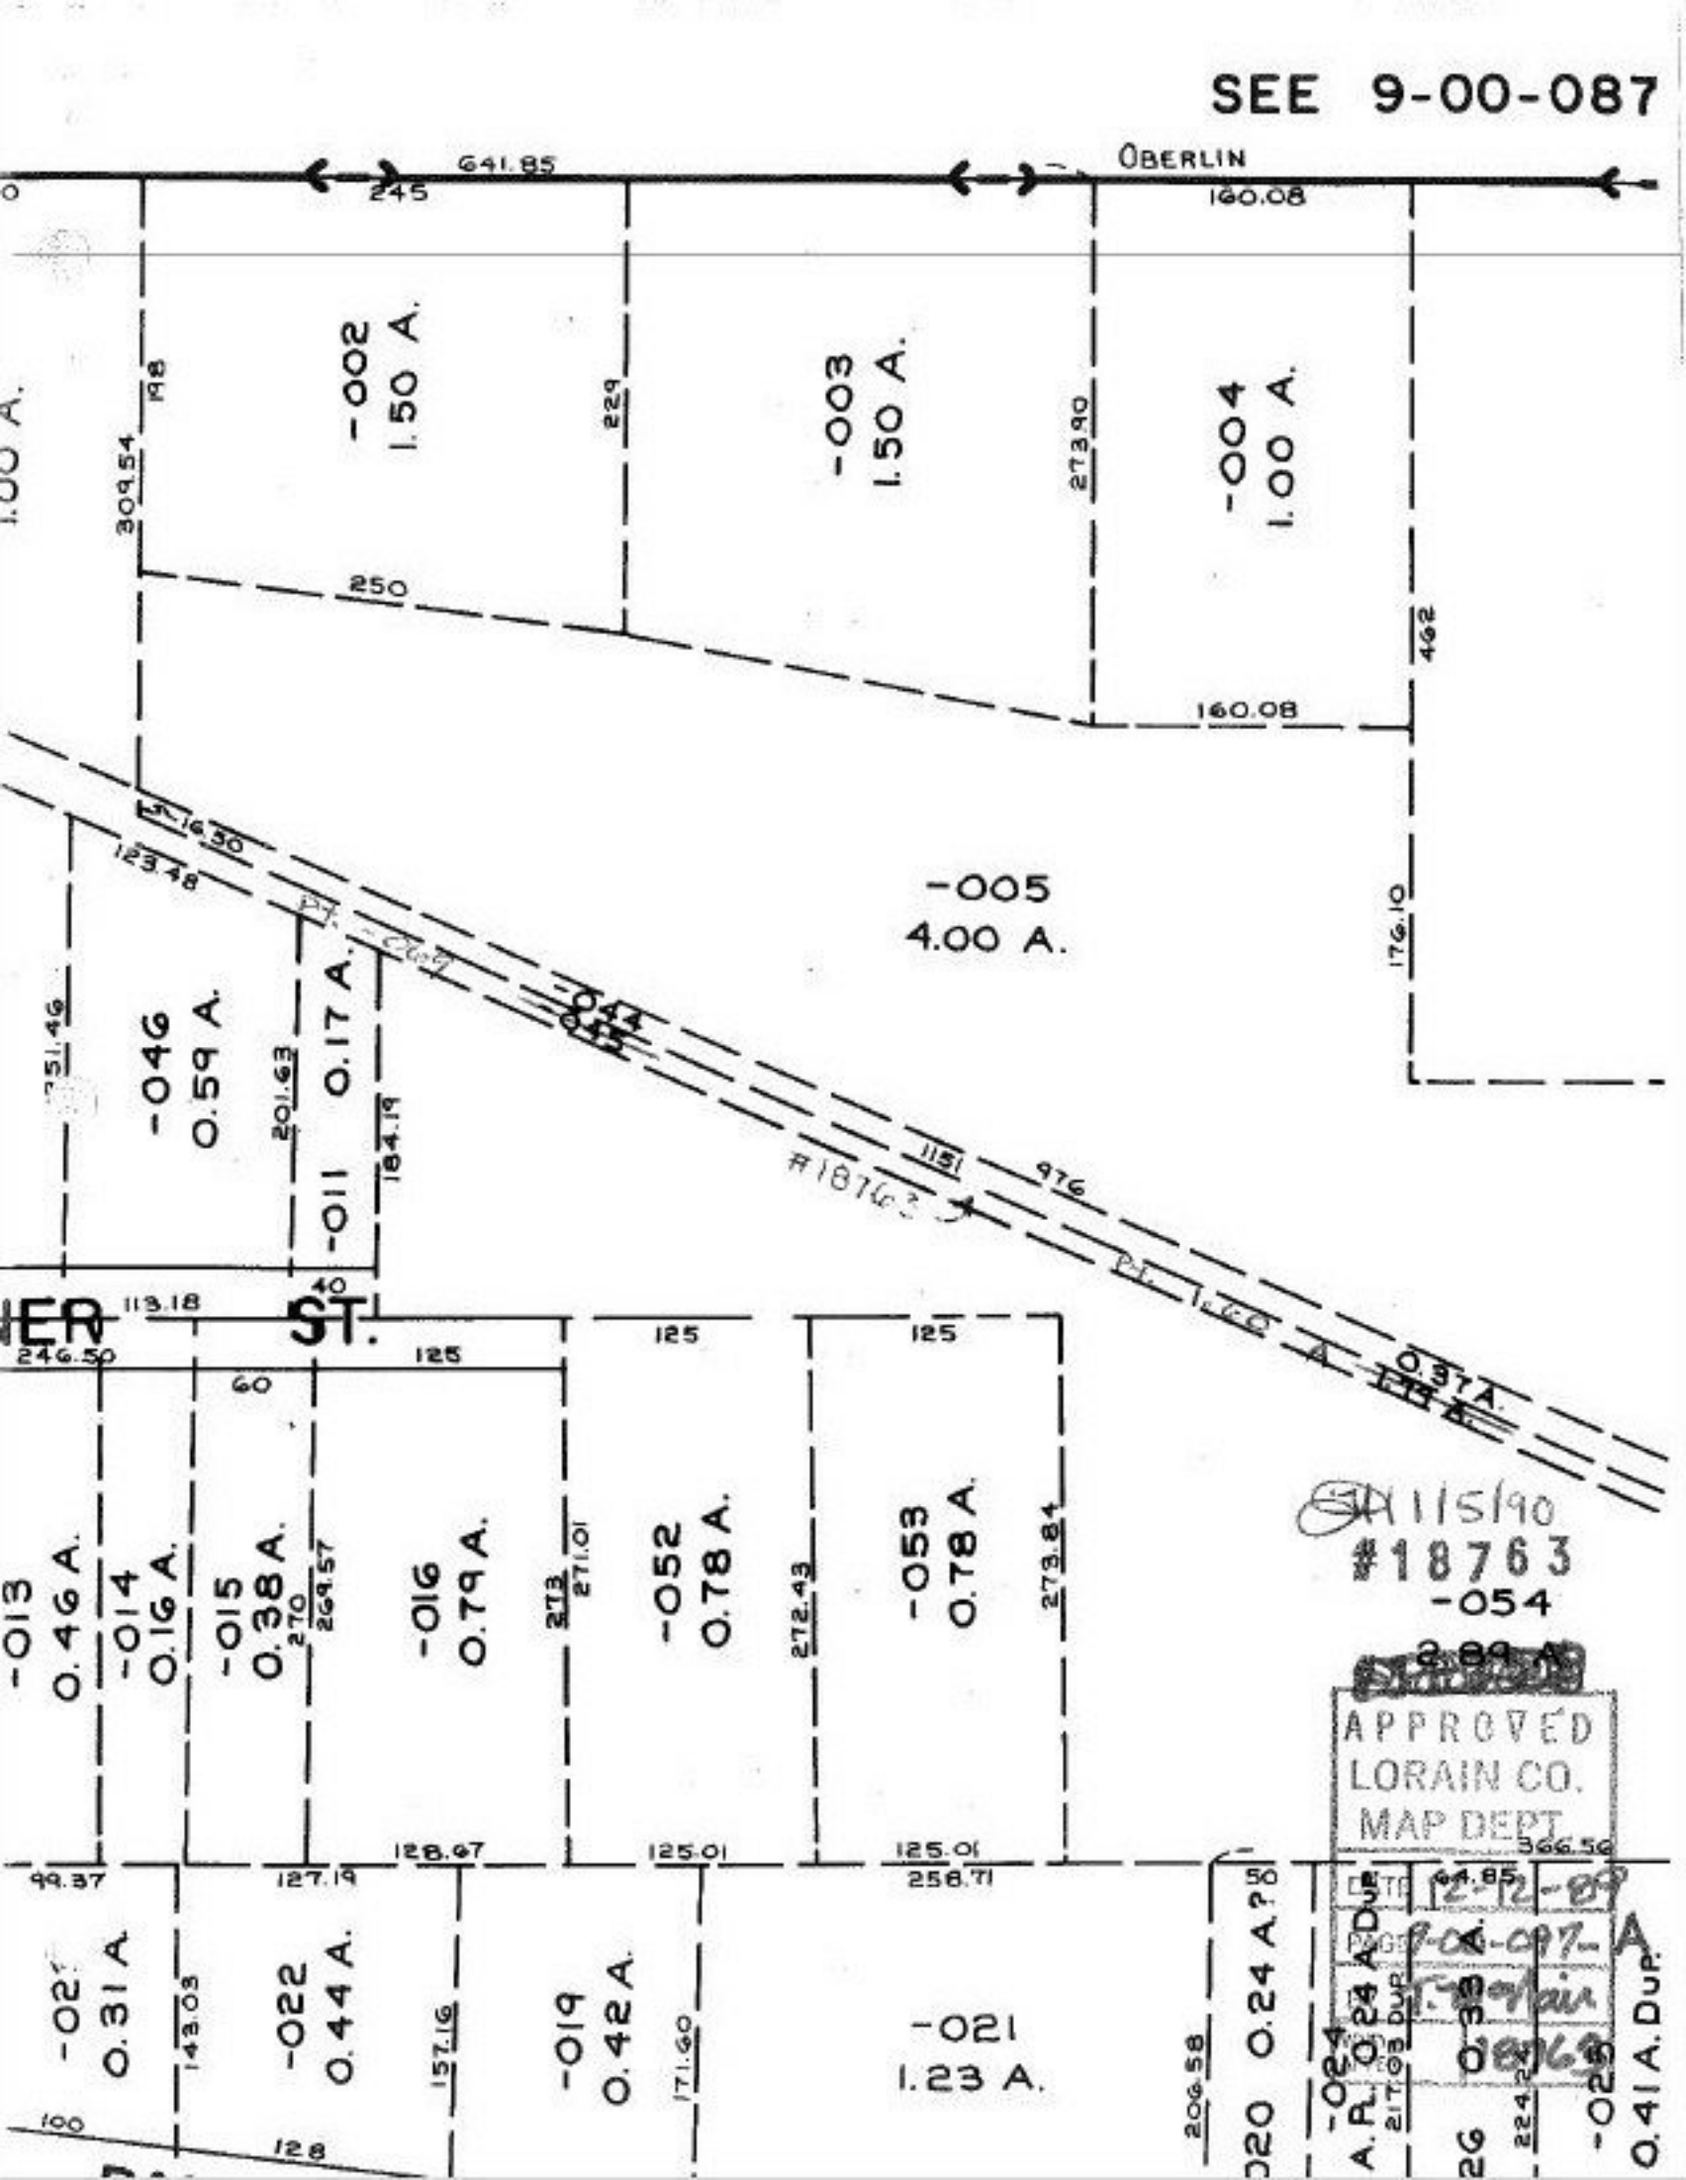
SEE 9-00-087
OBERLIN
641.85
245
160.08
-002
1.50 A.
-003
1.50 A.
-004
1.00 A.
-005
4.00 A.
-046
0.59 A.
-011
0.17 A.
-013
0.46 A.
-014
0.16 A.
-015
0.38 A.
-016
0.79 A.
-052
0.78 A.
-053
0.78 A.
-054
2.89 A.
-021
1.23 A.
-022
0.44 A.
-024
0.24 A.
-025
0.41 A. DUP.
APPROVED
LORAIN CO.
MAP DEPT.
DATE 12-12-89
PAGE 9-00-087-A
#18763