DEED DESCRIPTION COVERS
05-00-079-000-041 ALSO
INCLUDING 05-00-079-000-040,
DEED NEEDS EXCEPTION FOR
05-00-079-000-040

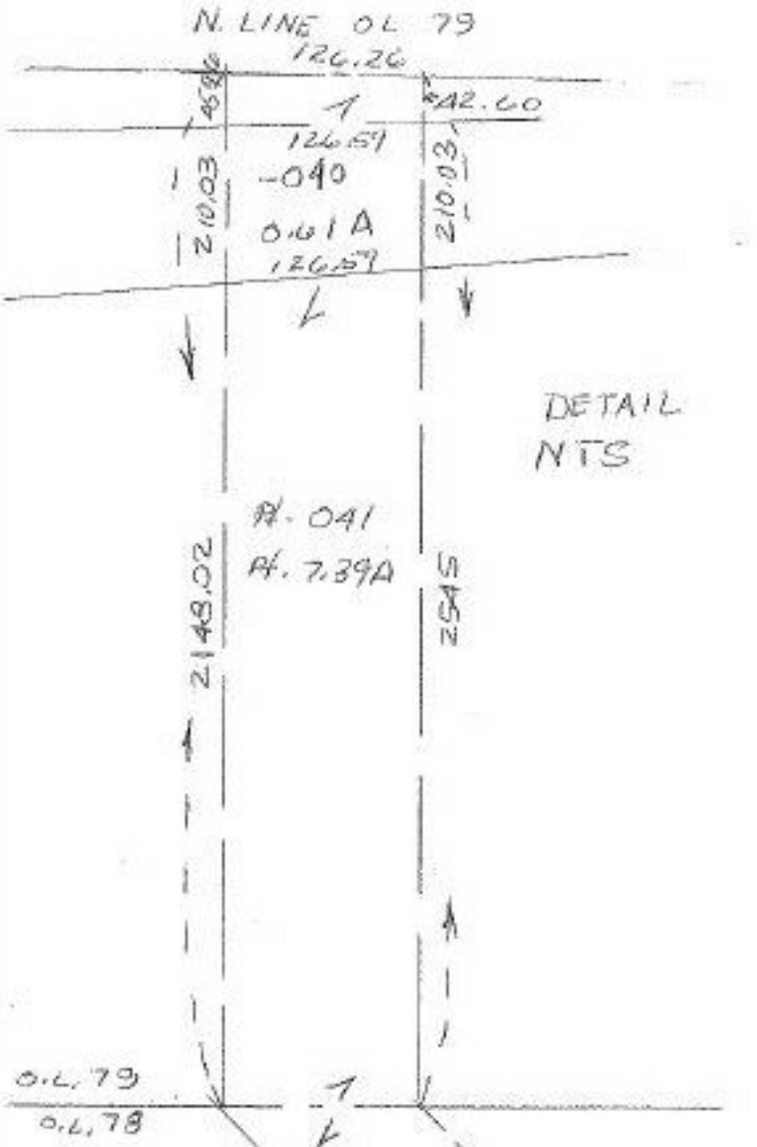

-041
7.39A

DEED CHECK

#18765A

APPROVED
LORAIN CO.
MAP DEPT.

DATE 12-21-89

PAGE 5-00-079A

BY CAROLYN Francis
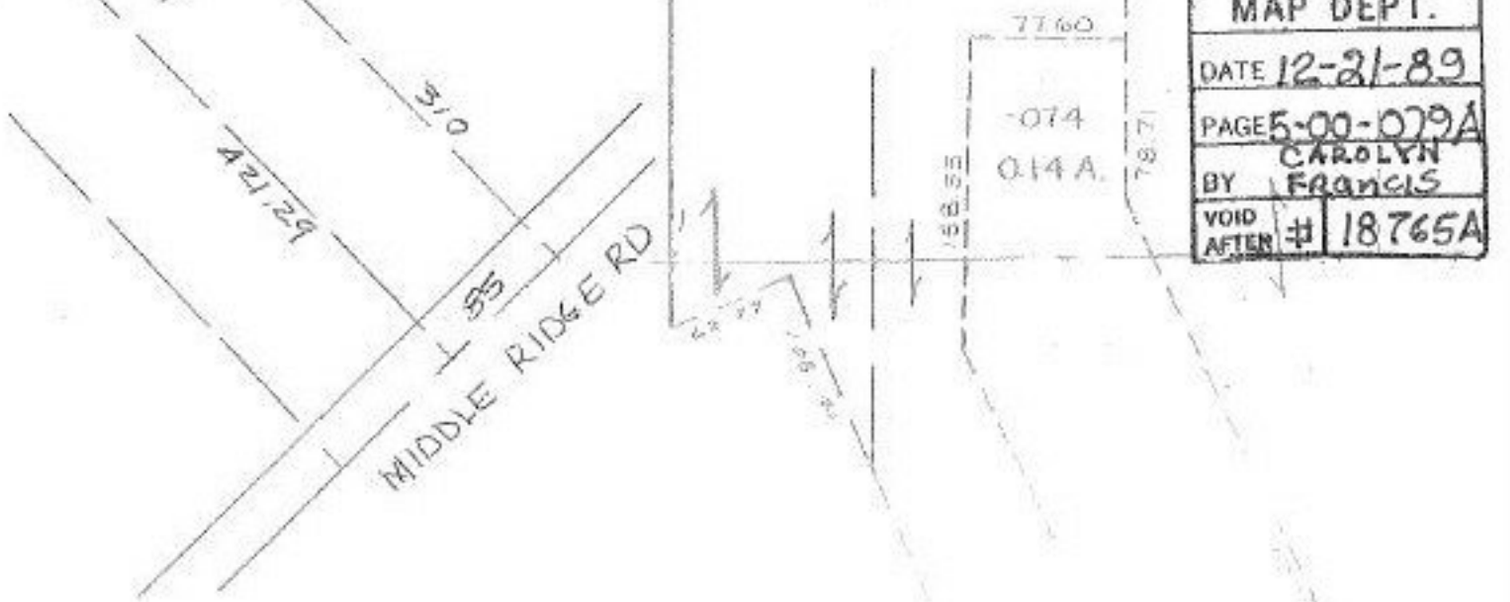
VOID AFTER # 18765A