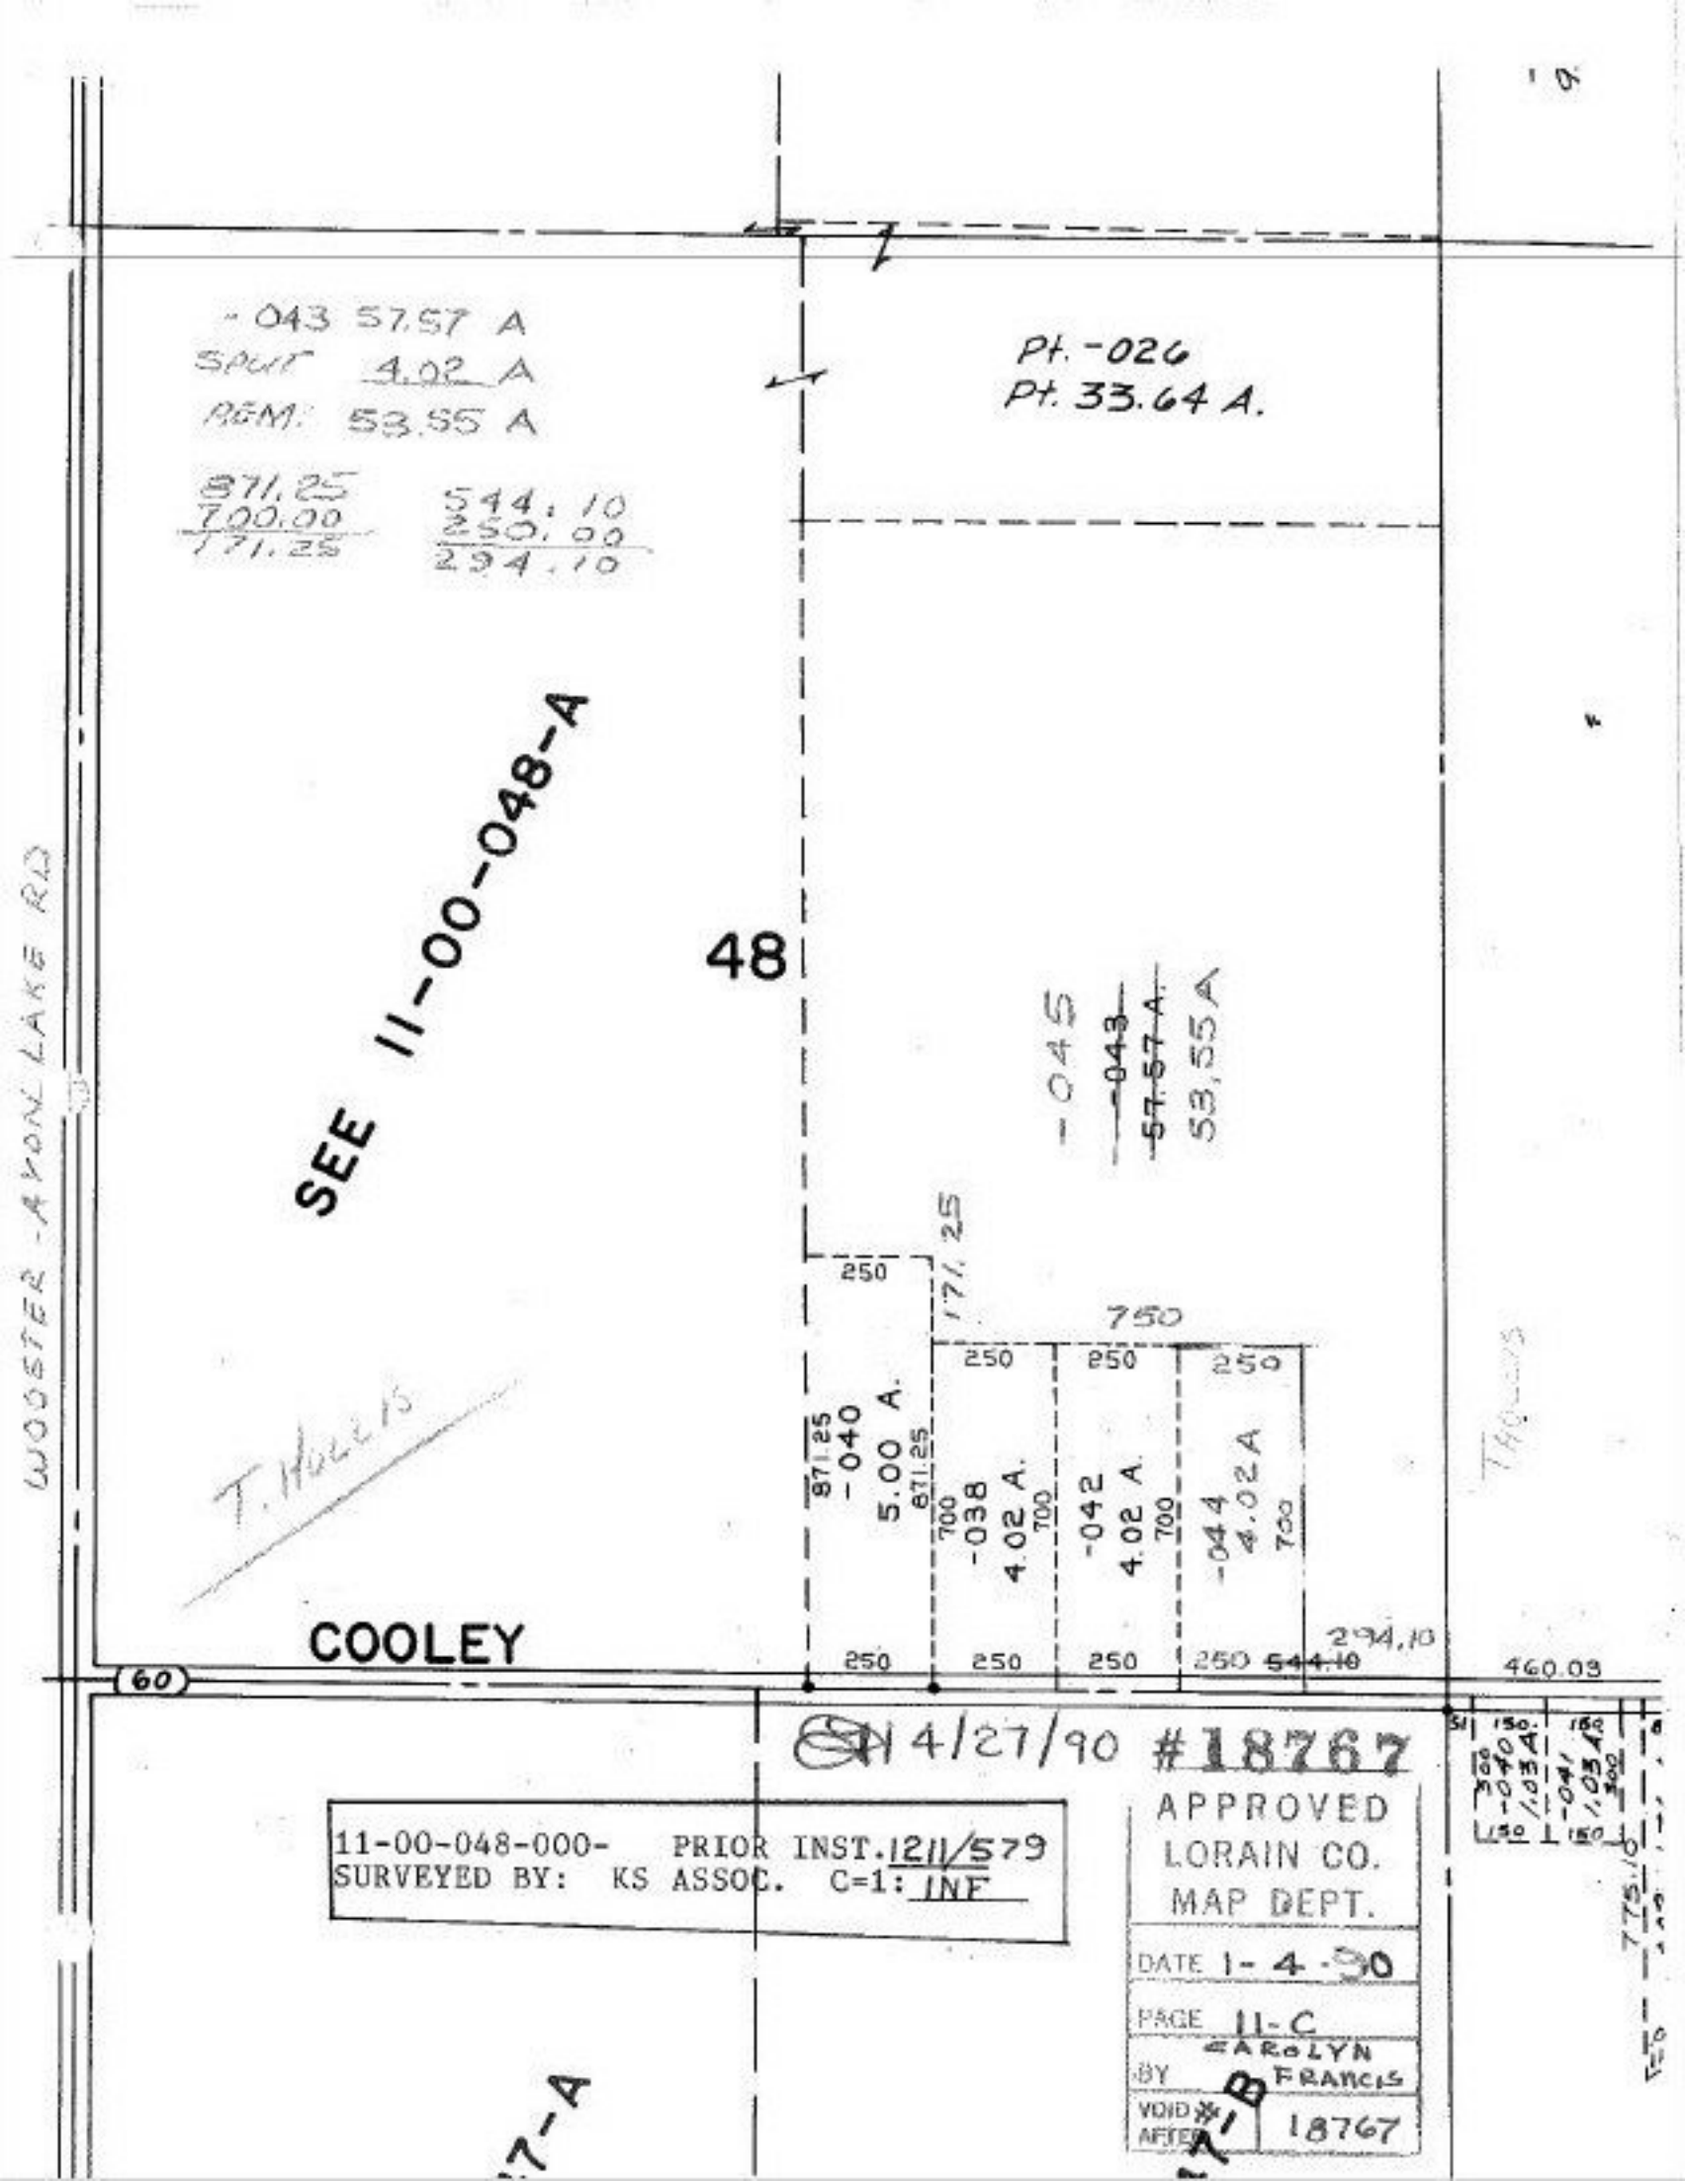
-043 57.57 A
SPLIT 4.02 A
REM. 53.55 A
871.25
700.00
171.25
544.10
250.00
294.10
Pt. -026
Pt. 33.64 A.
SEE 11-00-048-A
48
-045
-043
57.57 A.
53.55A
WOOSTER - AVON LAKE RD
T. Hulls
Thomas
250
171.25
750
250
250
250
871.25
-040
5.00 A.
871.25
700
-038
4.02 A.
700
-042
4.02 A.
700
-044
4.02A
700
COOLEY
60
250
250
250
250
544.10
294.10
460.03
4/27/90 #18767
11-00-048-000- PRIOR INST. 1211/579
SURVEYED BY: KS ASSOC. C=1: INF
APPROVED
LORAIN CO.
MAP DEPT.
DATE 1-4-90
PAGE 11-C
BY CAROLYN FRANCIS
VOID AFTER #1
18767