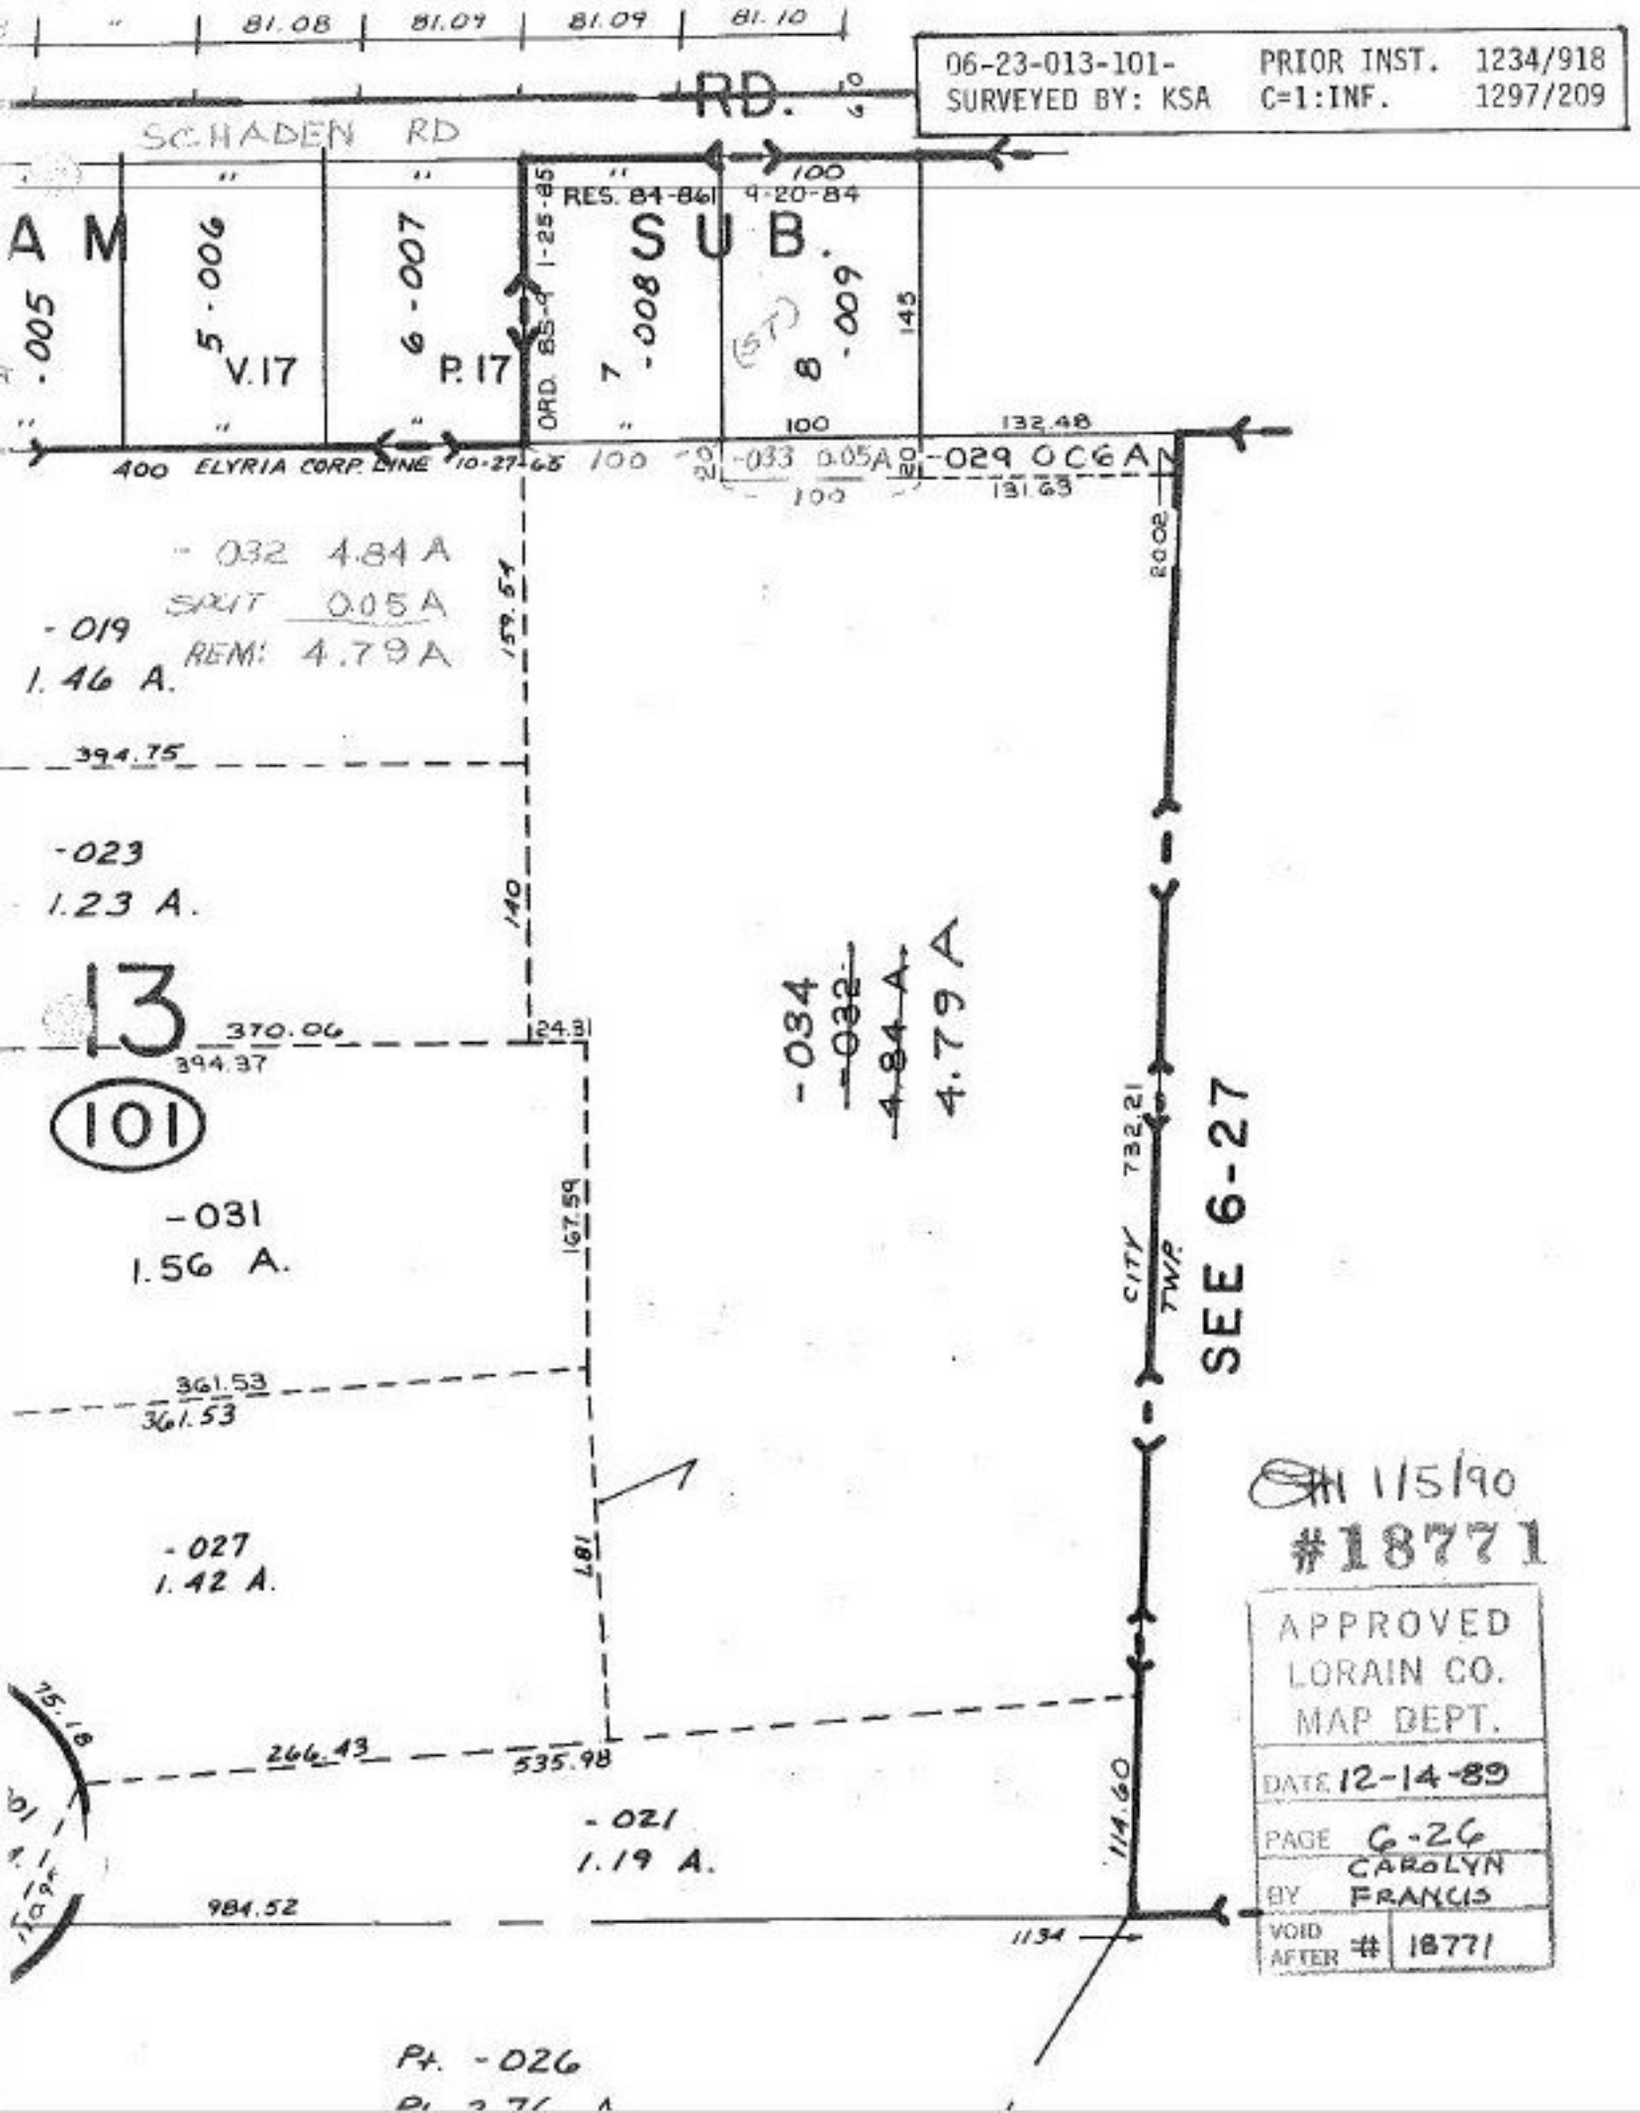

1/15/90
#18771

APPROVED
LORAIN CO.
MAP DEPT.
DATE 12-14-89
PAGE 6-26
BY CAROLYN FRANCIS
VOID AFTER # 18771