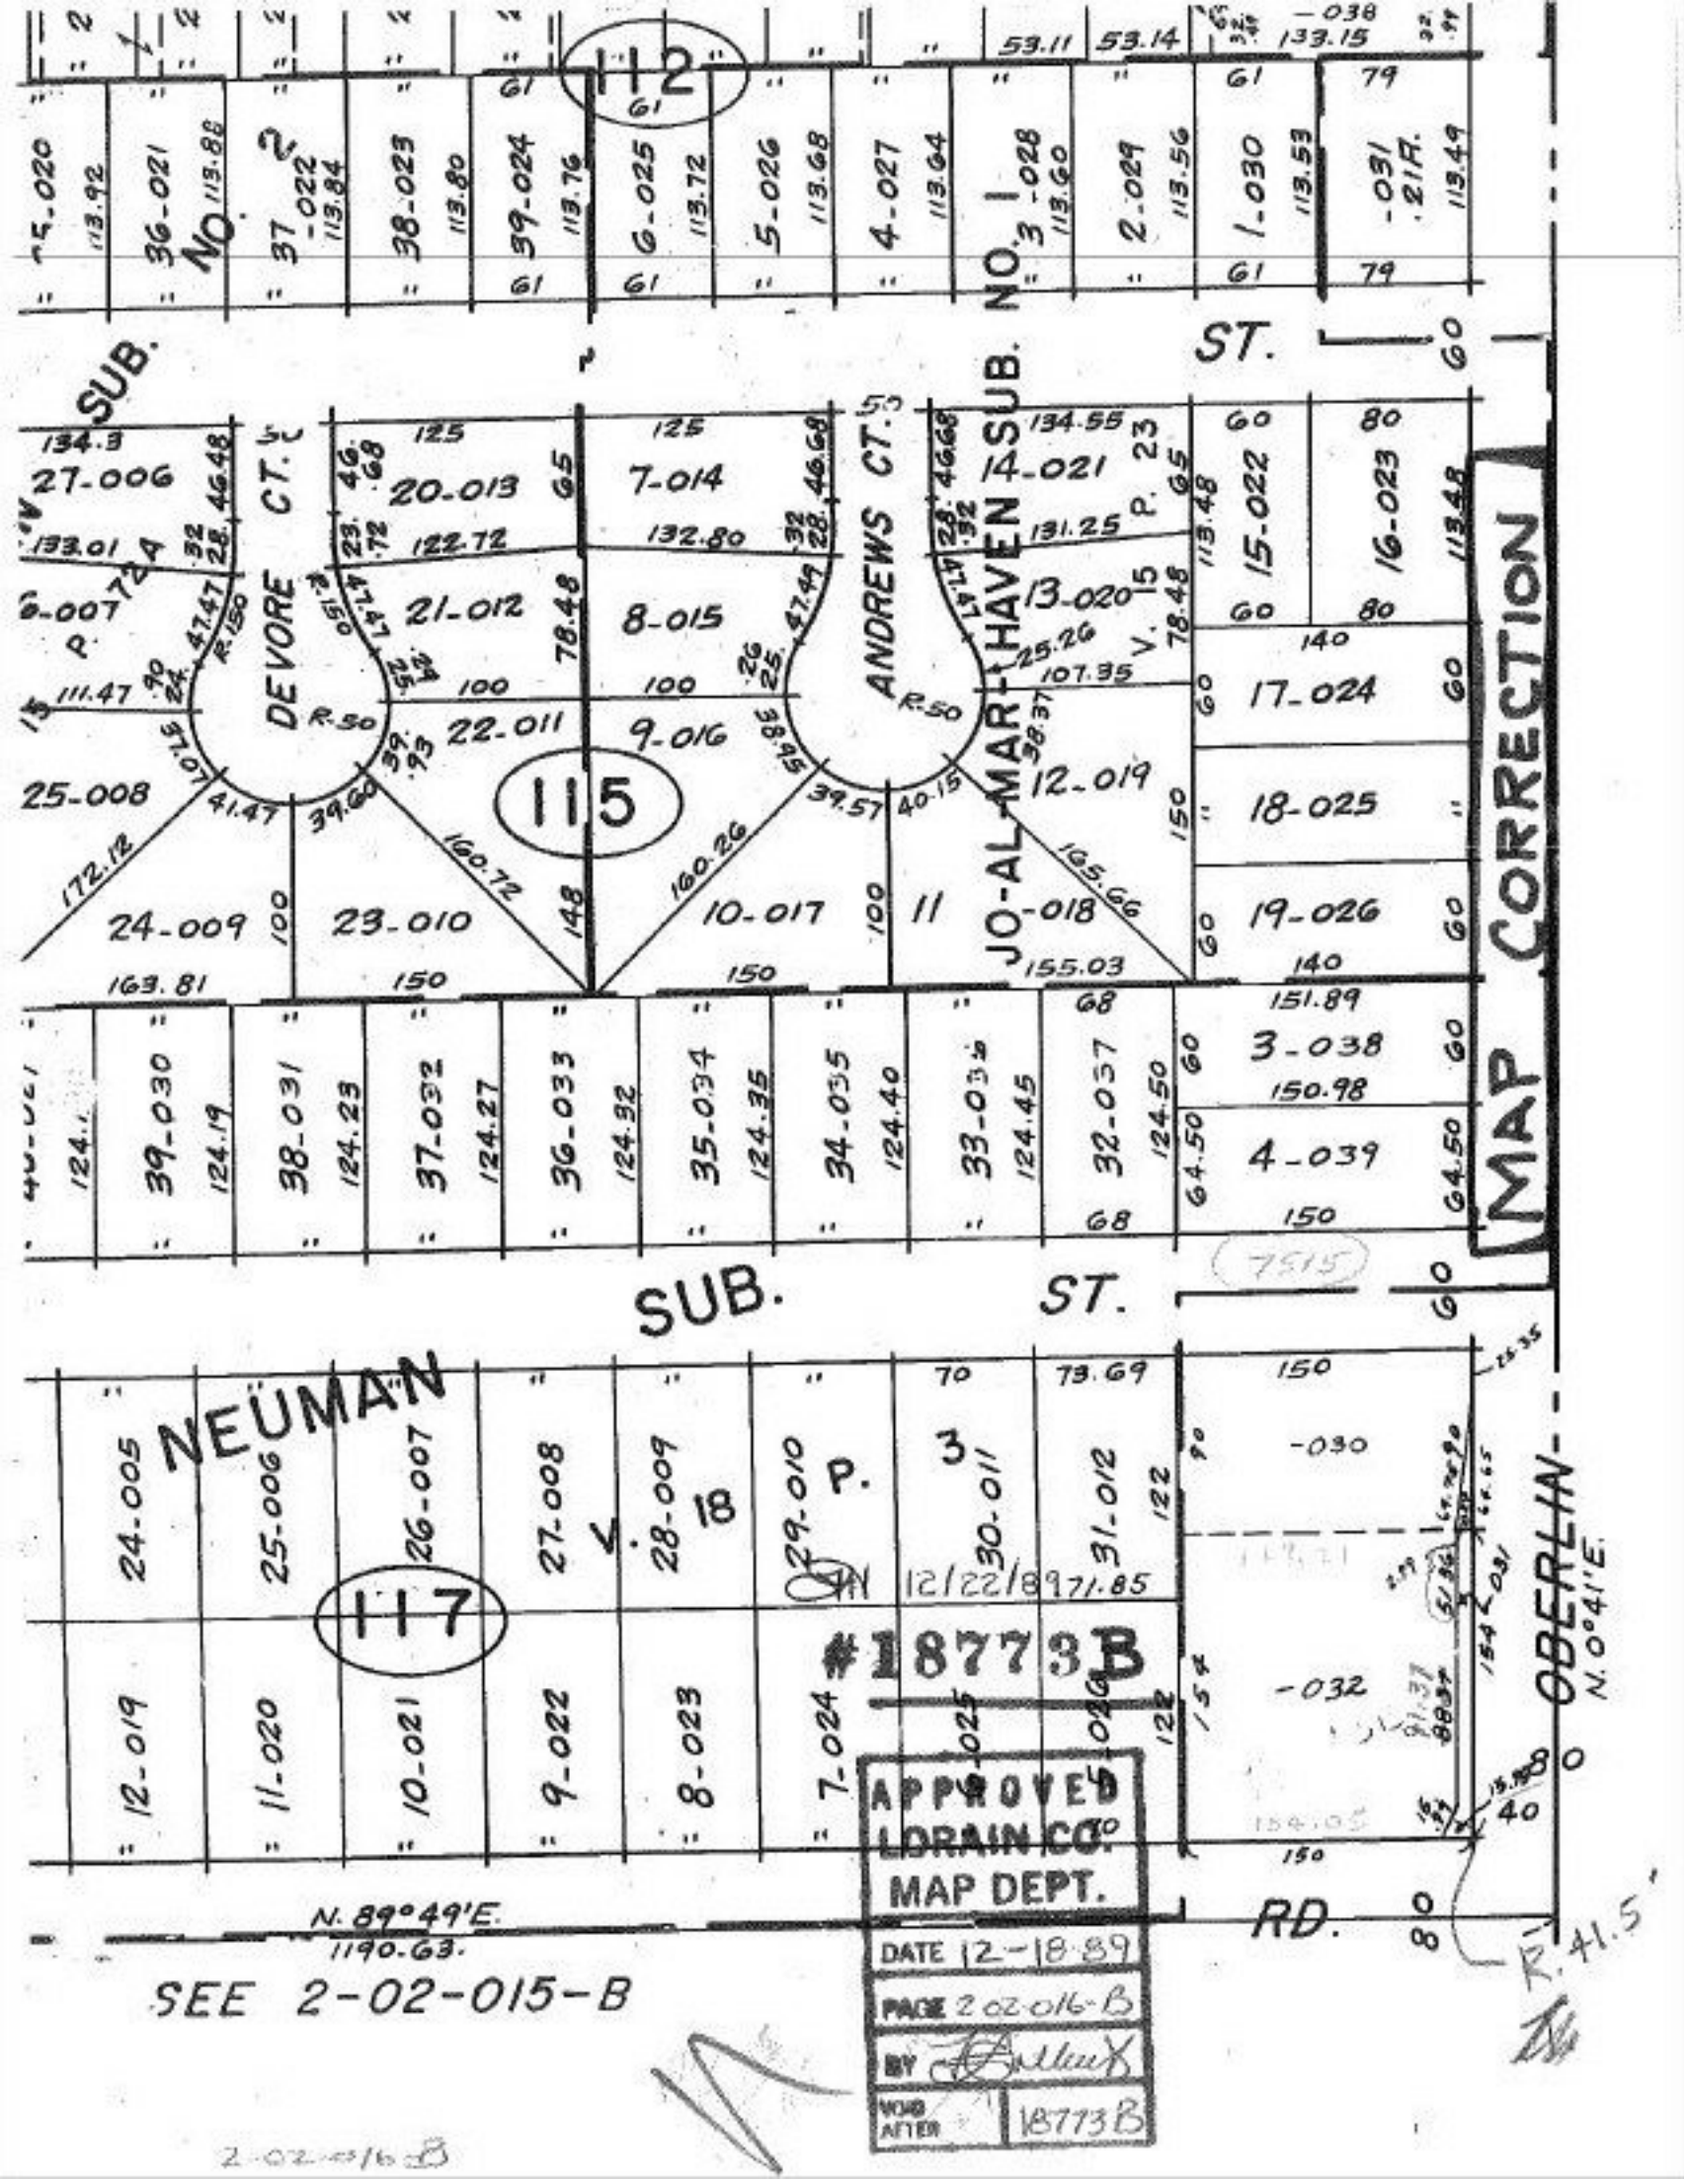
SUB.
NO. 2
NO. 1
ST.
DEVORE CT.
ANDREWS CT.
JO-AL-MAR-HAVEN SUB.
MAP CORRECTION
SUB.
ST.
NEUMAN
OBERLIN
RD.
#18773B
APPROVED
LORAIN CO.
MAP DEPT.
DATE 12-18-89
PAGE 2-02-016-B
BY
VOID AFTER
18773B
N. 89°49'E.
1190.63.
SEE 2-02-015-B
2-02-016 B