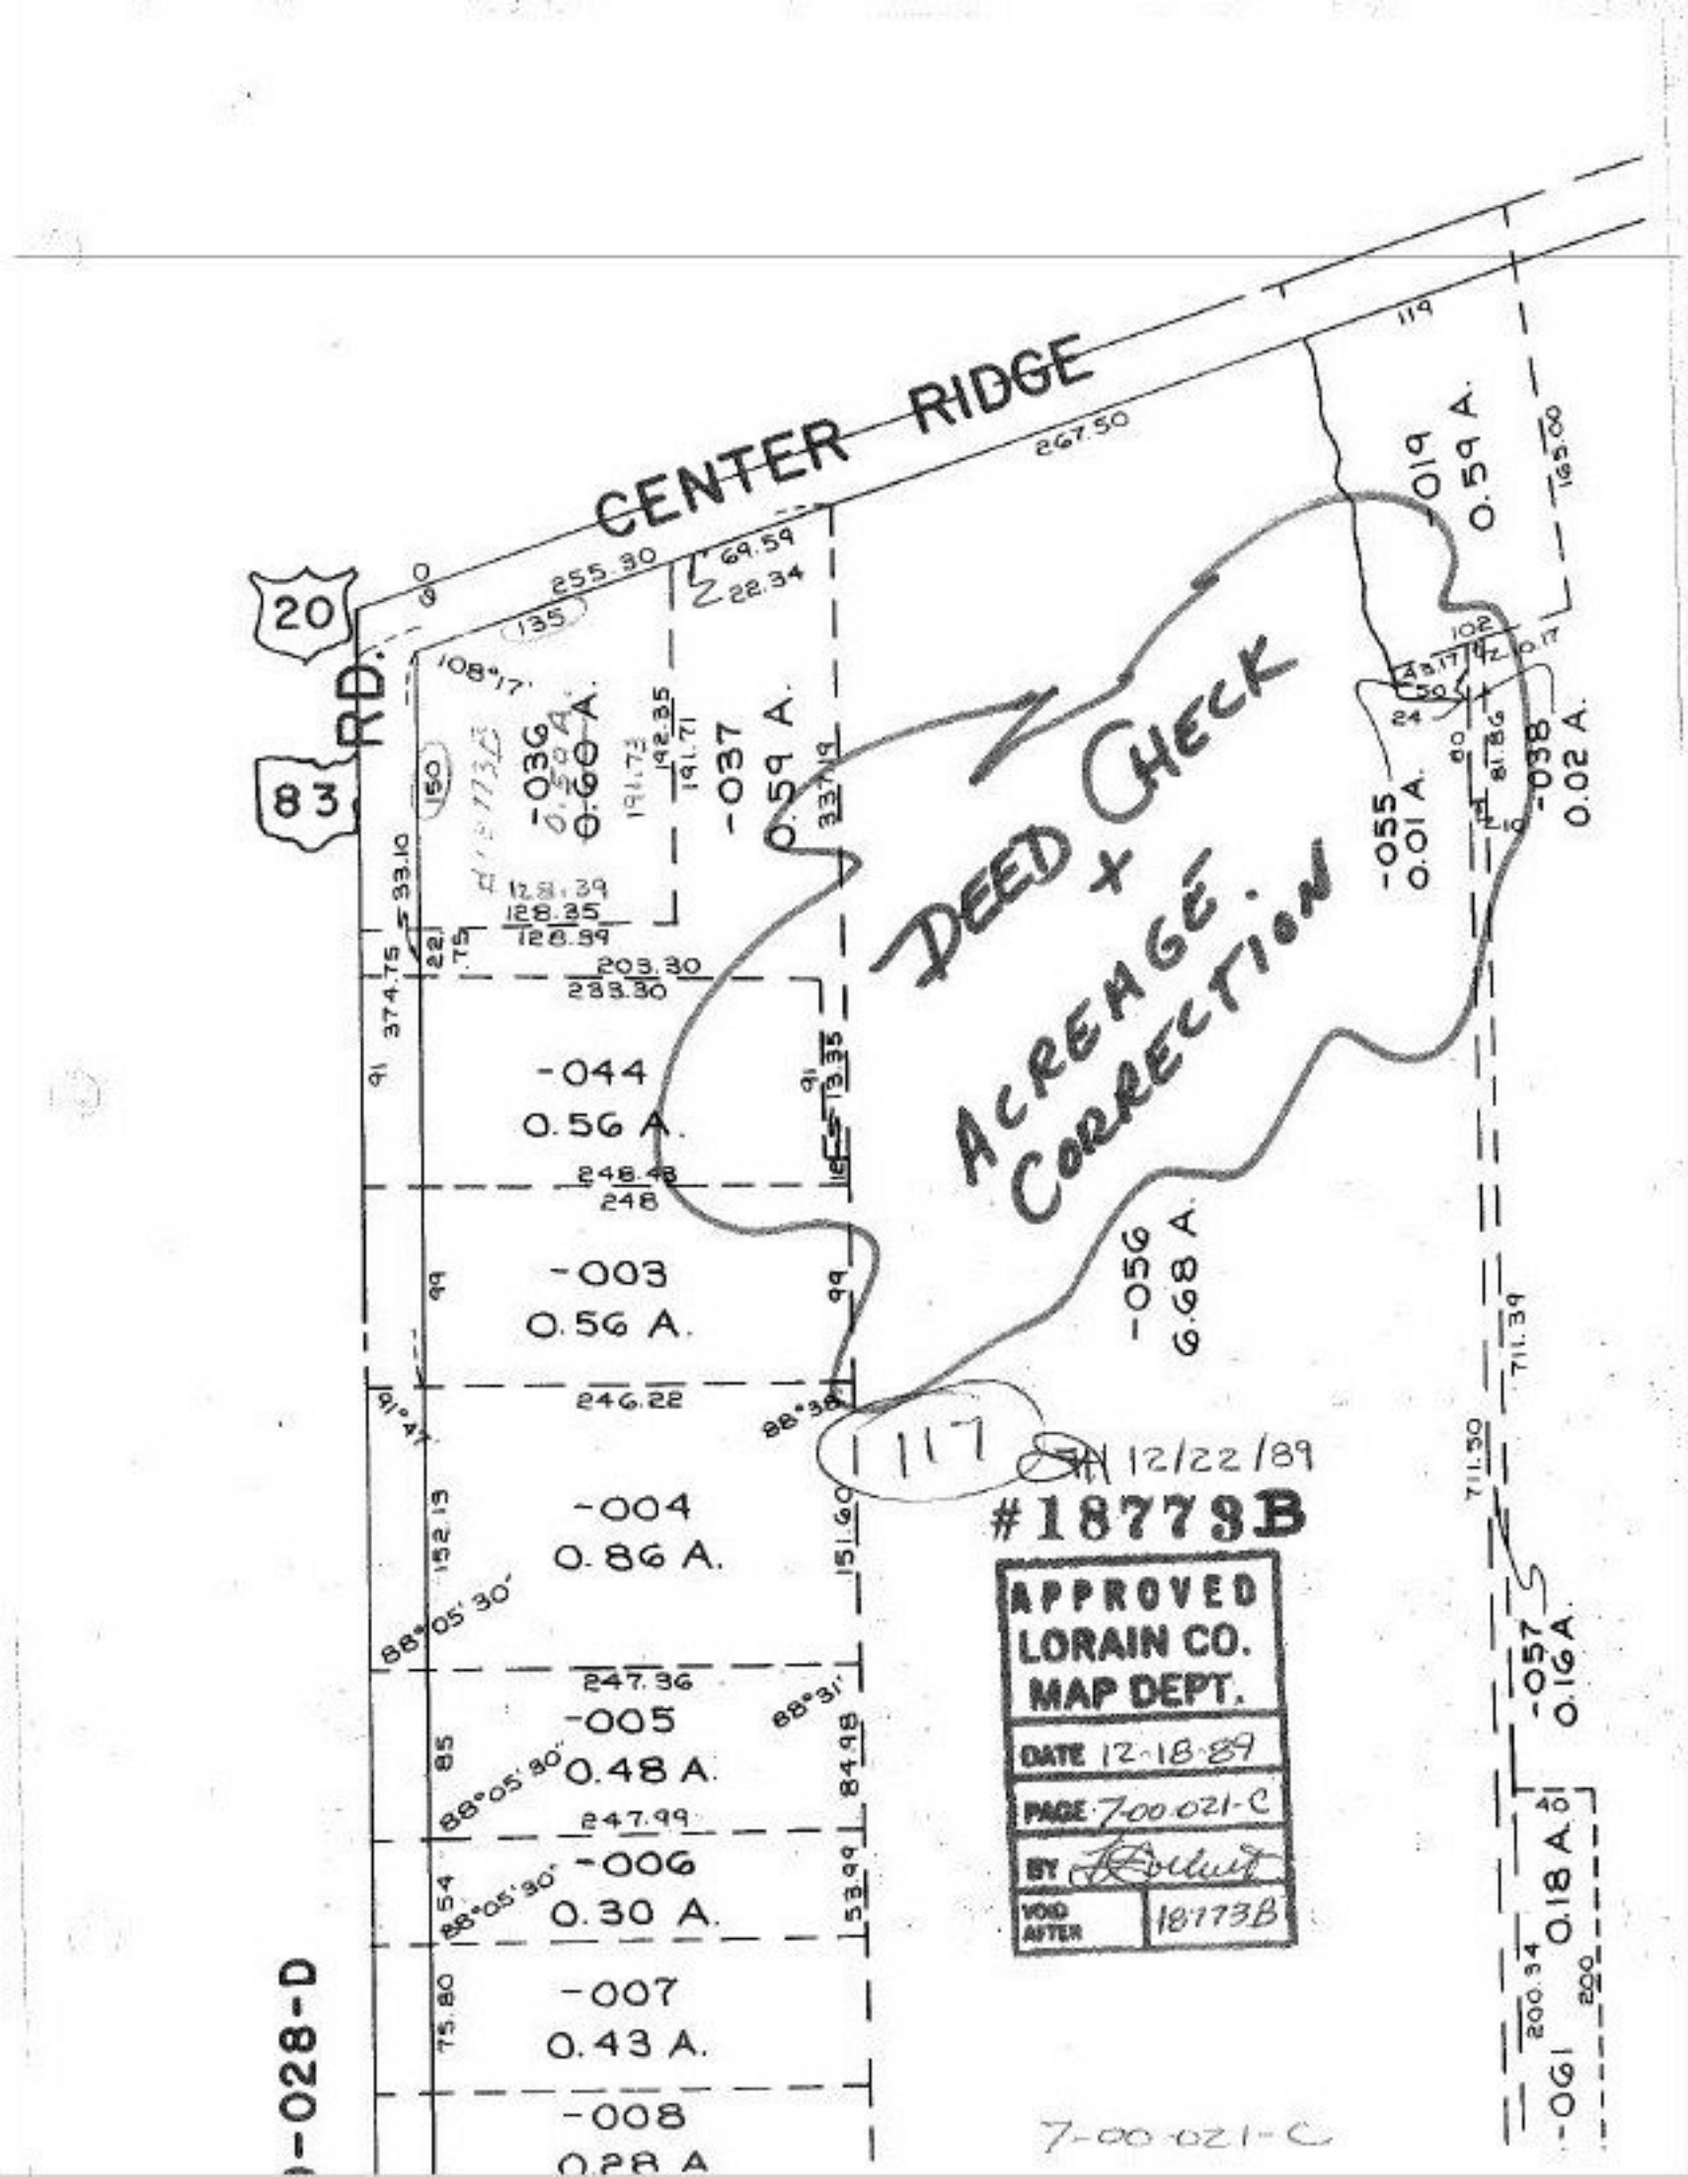
CENTER RIDGE
RD.
20
83
DEED CHECK
+
ACREAGE
CORRECTION
-036
0.60 A.
-037
0.59 A.
-019
0.59 A.
-055
0.01 A.
-038
0.02 A.
-044
0.56 A.
-003
0.56 A.
-004
0.86 A.
-005
0.48 A.
-006
0.30 A.
-007
0.43 A.
-008
0.28 A.
-056
6.68 A.
-057
0.16 A.
-061
0.18 A.
117
12/22/89
#18773B
APPROVED
LORAIN CO.
MAP DEPT.
DATE 12-18-89
PAGE 7-00-021-C
BY
VOID AFTER 18773B
7-00-021-C