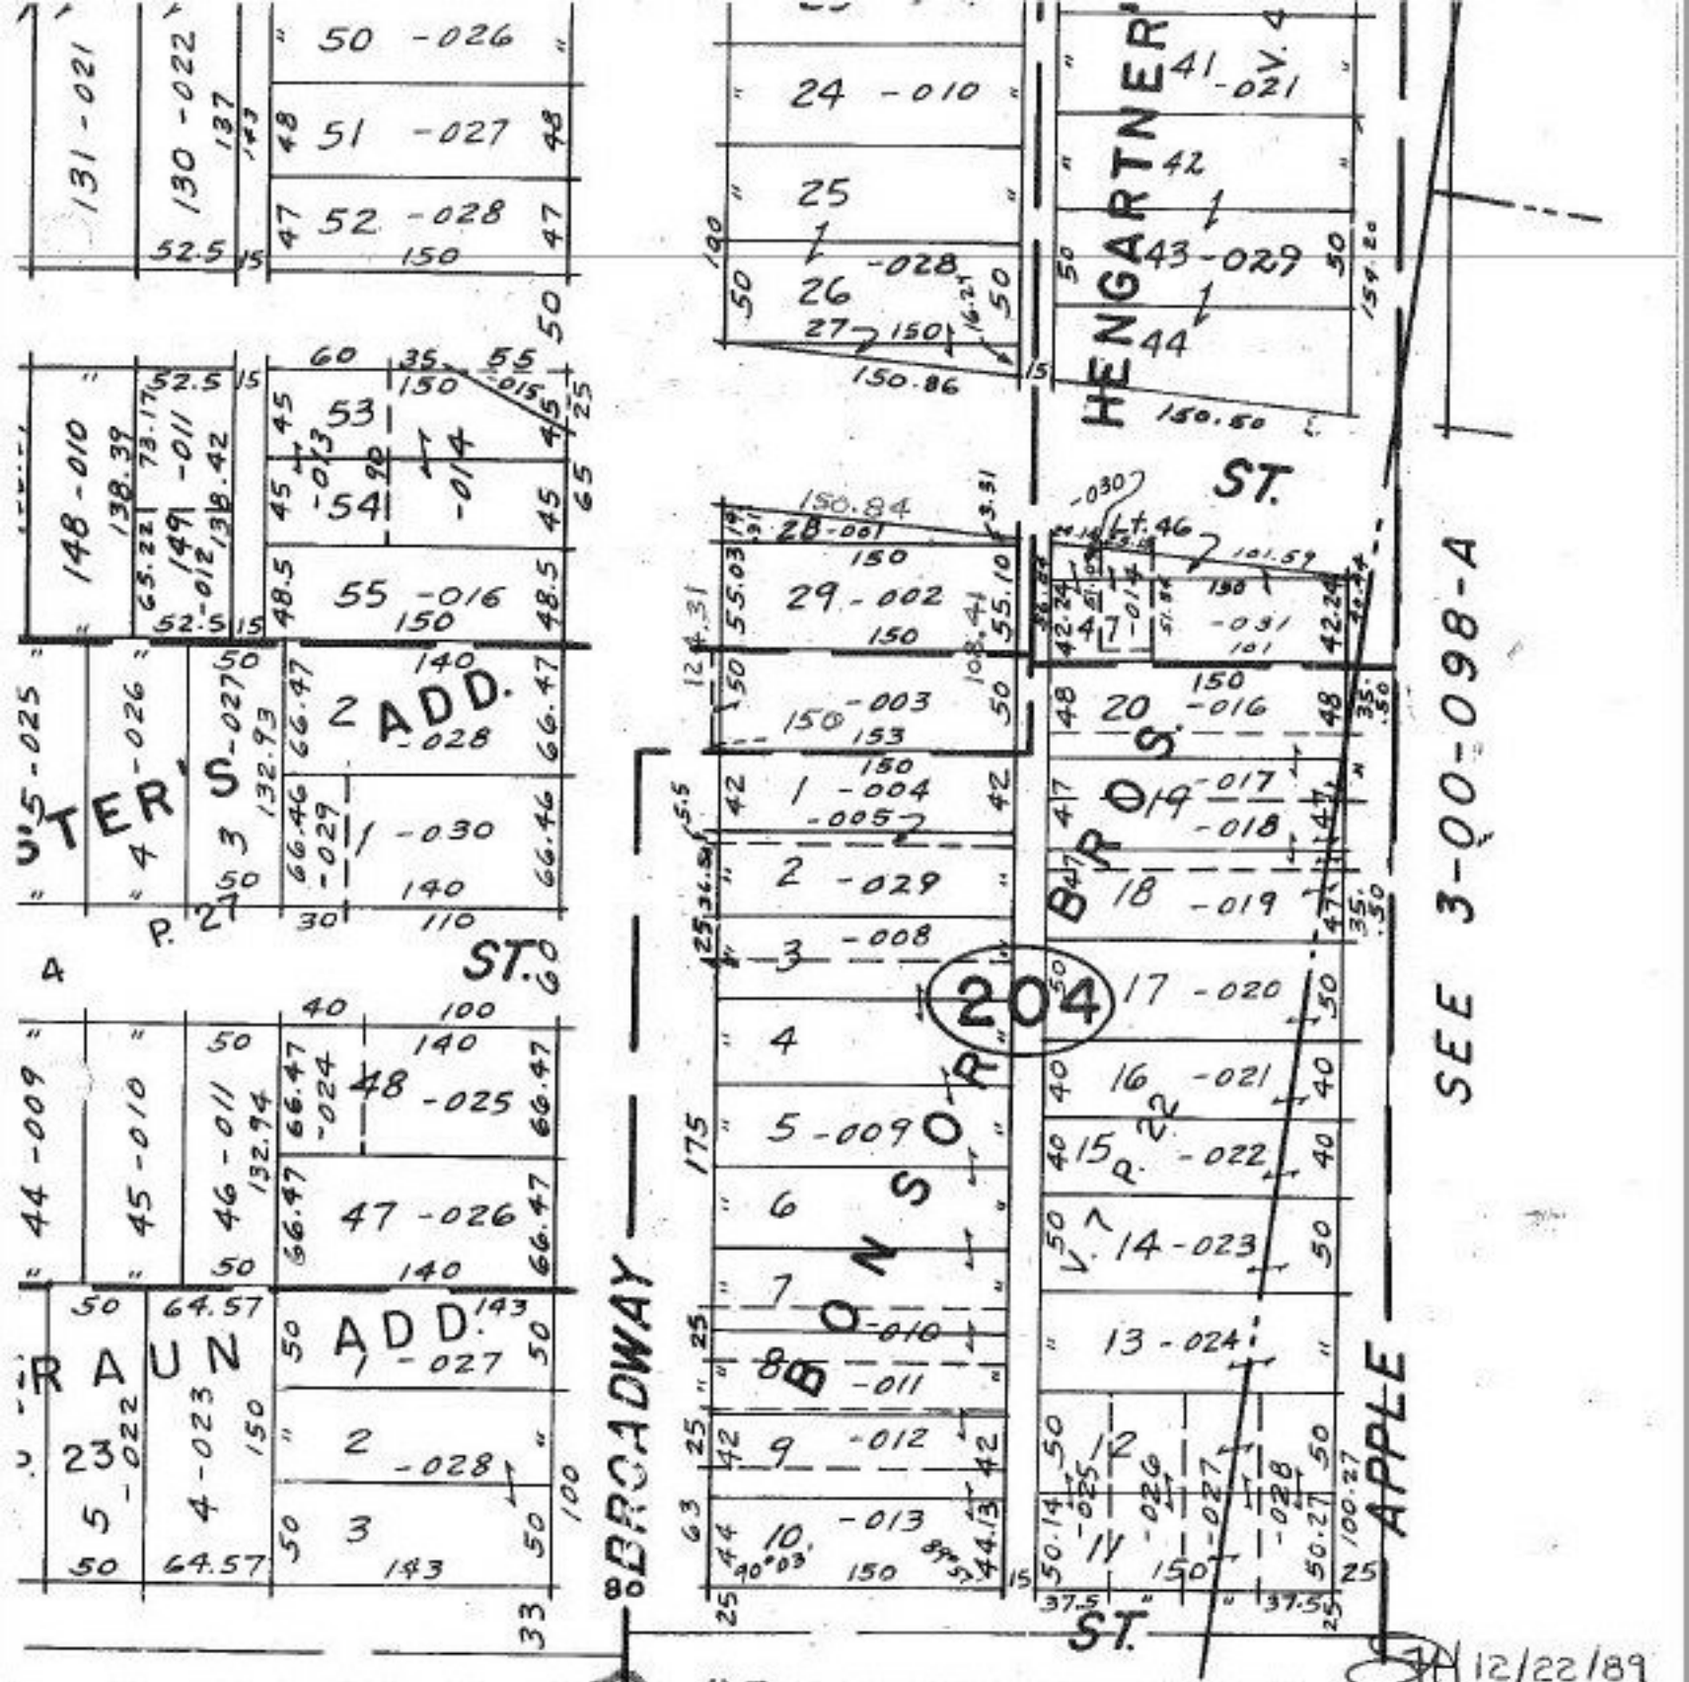

2-01-003-J

#18773B

#18773B

12/22/89

DEED CHECK

TWP

APPROVED
LORAIN CO.
MAP DEPT.

DATE 12-18-89

PAGE 2-01-003-H

BY [signature]

VOID AFTER 18773B

2-01-003-H