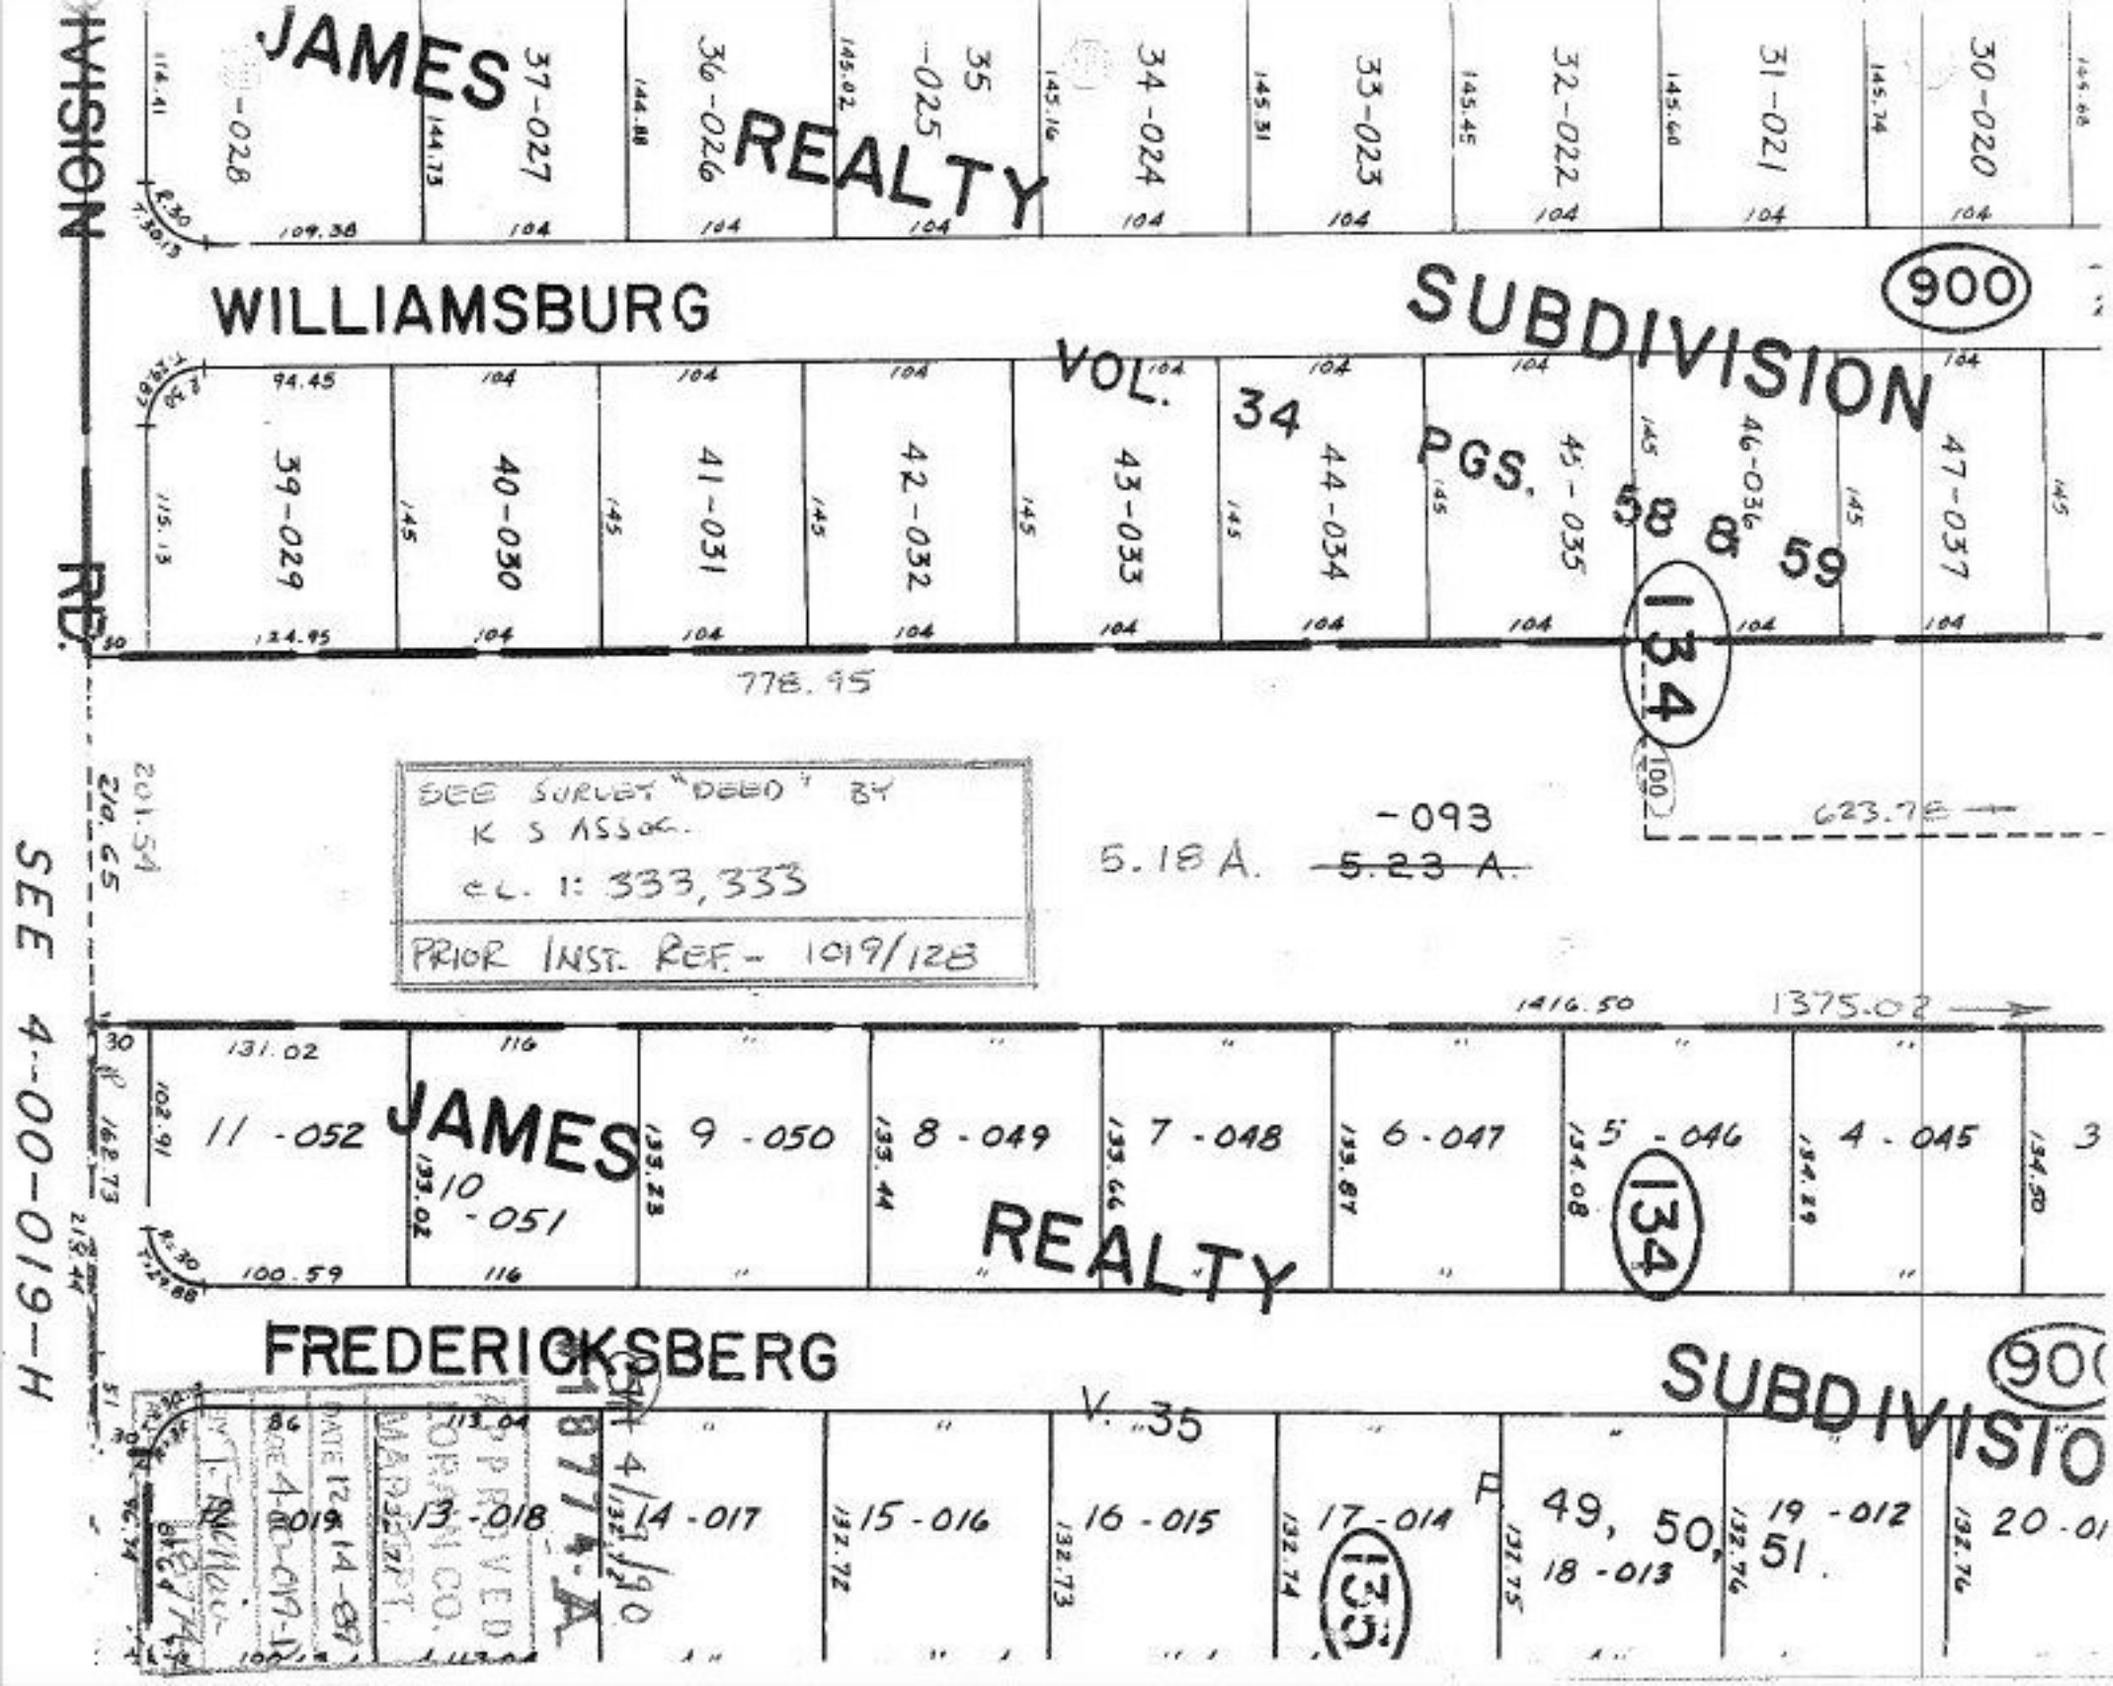
JAMES REALTY
WILLIAMSBURG SUBDIVISION
VOL. 34 PGS. 58 & 59
900
134
SEE 4-00-019-H
SEE SURVEY "DEED" BY K S ASSOC.
EL. 1: 333,333
PRIOR INST. REF. - 1019/128
5.18 A.
-093
5.23 A.
778.95
623.78
1416.50
1375.02
JAMES REALTY
FREDERICKSBERG SUBDIVISION
V. 35
135
APPROVED FOR RM CO. MARKET
DATE 12-4-87
SEE 4-00-019-I
4/132.90
18714-A