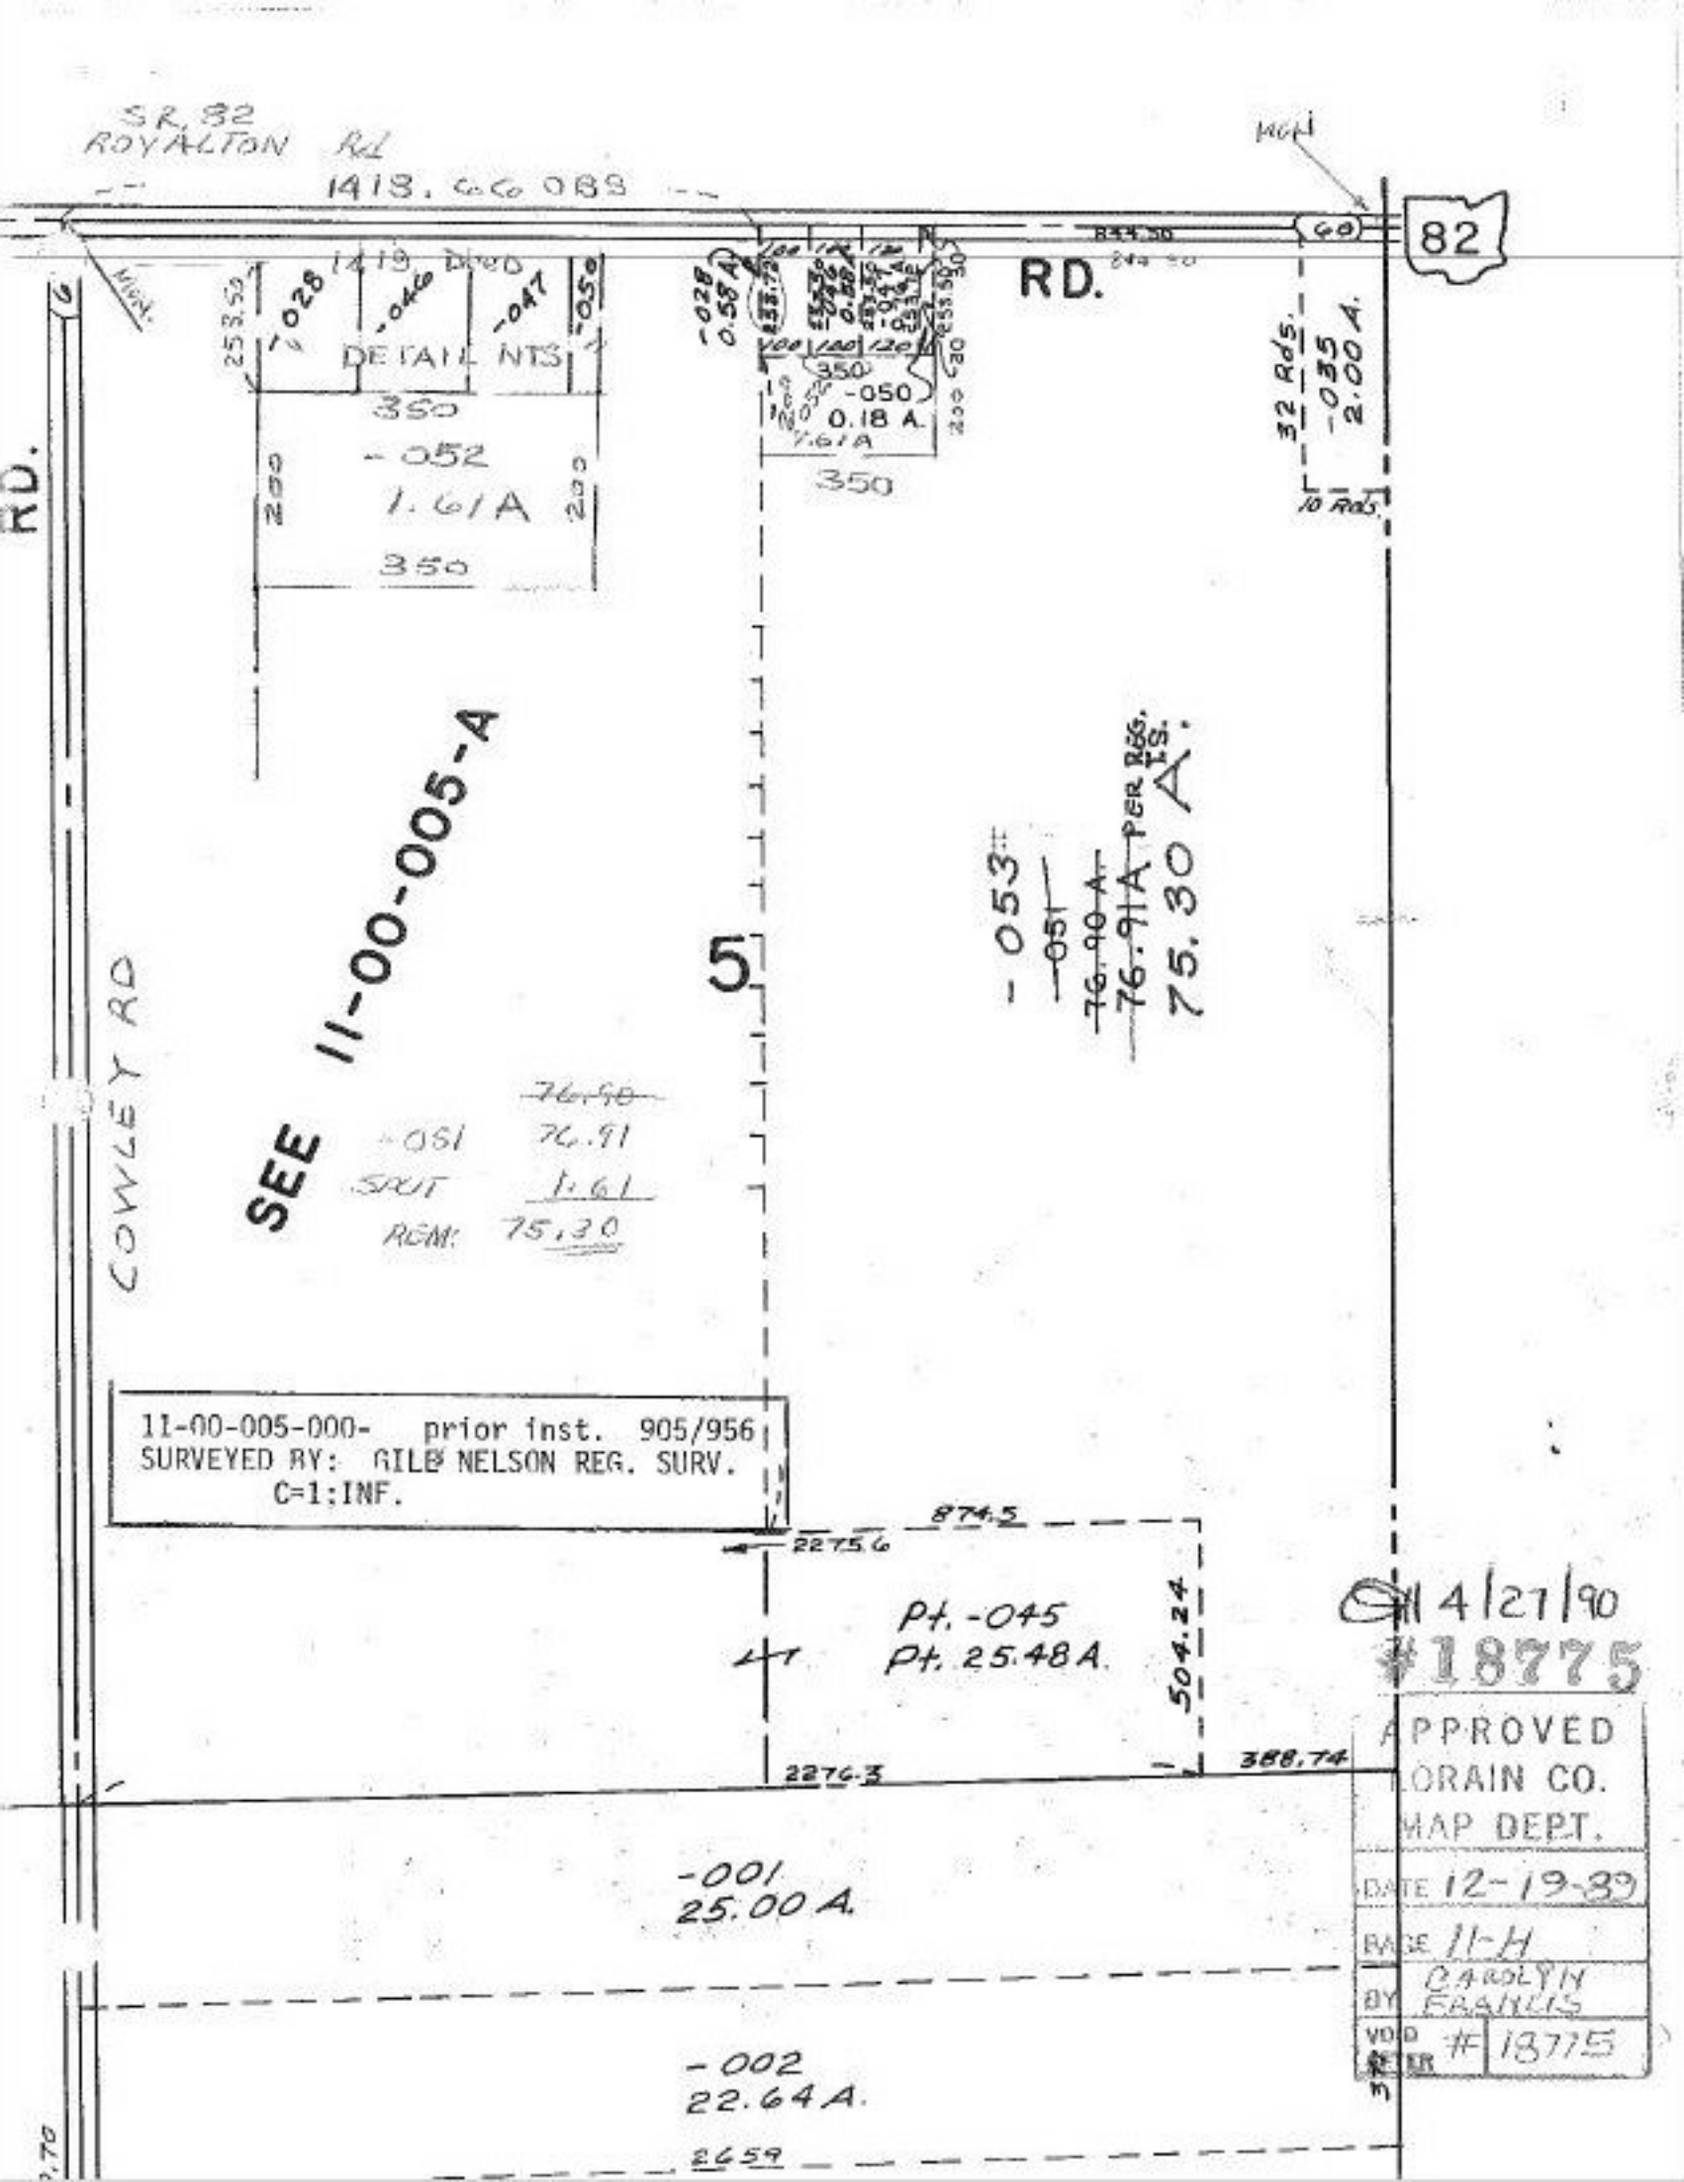
SR. 82
ROYALTON Rd
1418.66 OBS
82
RD.
1419 DEED
DETAIL NTS
-028
-046
-047
-050
-052
1.61A
350
200
-028
0.58A
-050
0.18 A.
1.61A
350
32 Rds.
-035
2.00 A.
10 Rds.
RD.
SEE 11-00-005-A
5
-053
-051
76.90 A.
76.91A PER REG. I.S.
75.30 A.
COWLEY RD
76.90
-051 76.91
SPLIT 1.61
REM: 75.30
11-00-005-000- prior inst. 905/956
SURVEYED BY: GILB NELSON REG. SURV.
C=1:INF.
874.5
2275.6
Pt. -045
Pt. 25.48 A.
504.24
388.74
2276.3
-001
25.00 A.
-002
22.64 A.
2659
4/27/90
#18775
APPROVED
LORAIN CO.
MAP DEPT.
DATE 12-19-89
PAGE 11-H
BY CAROLYN FRANCIS
VOID METER # 18775