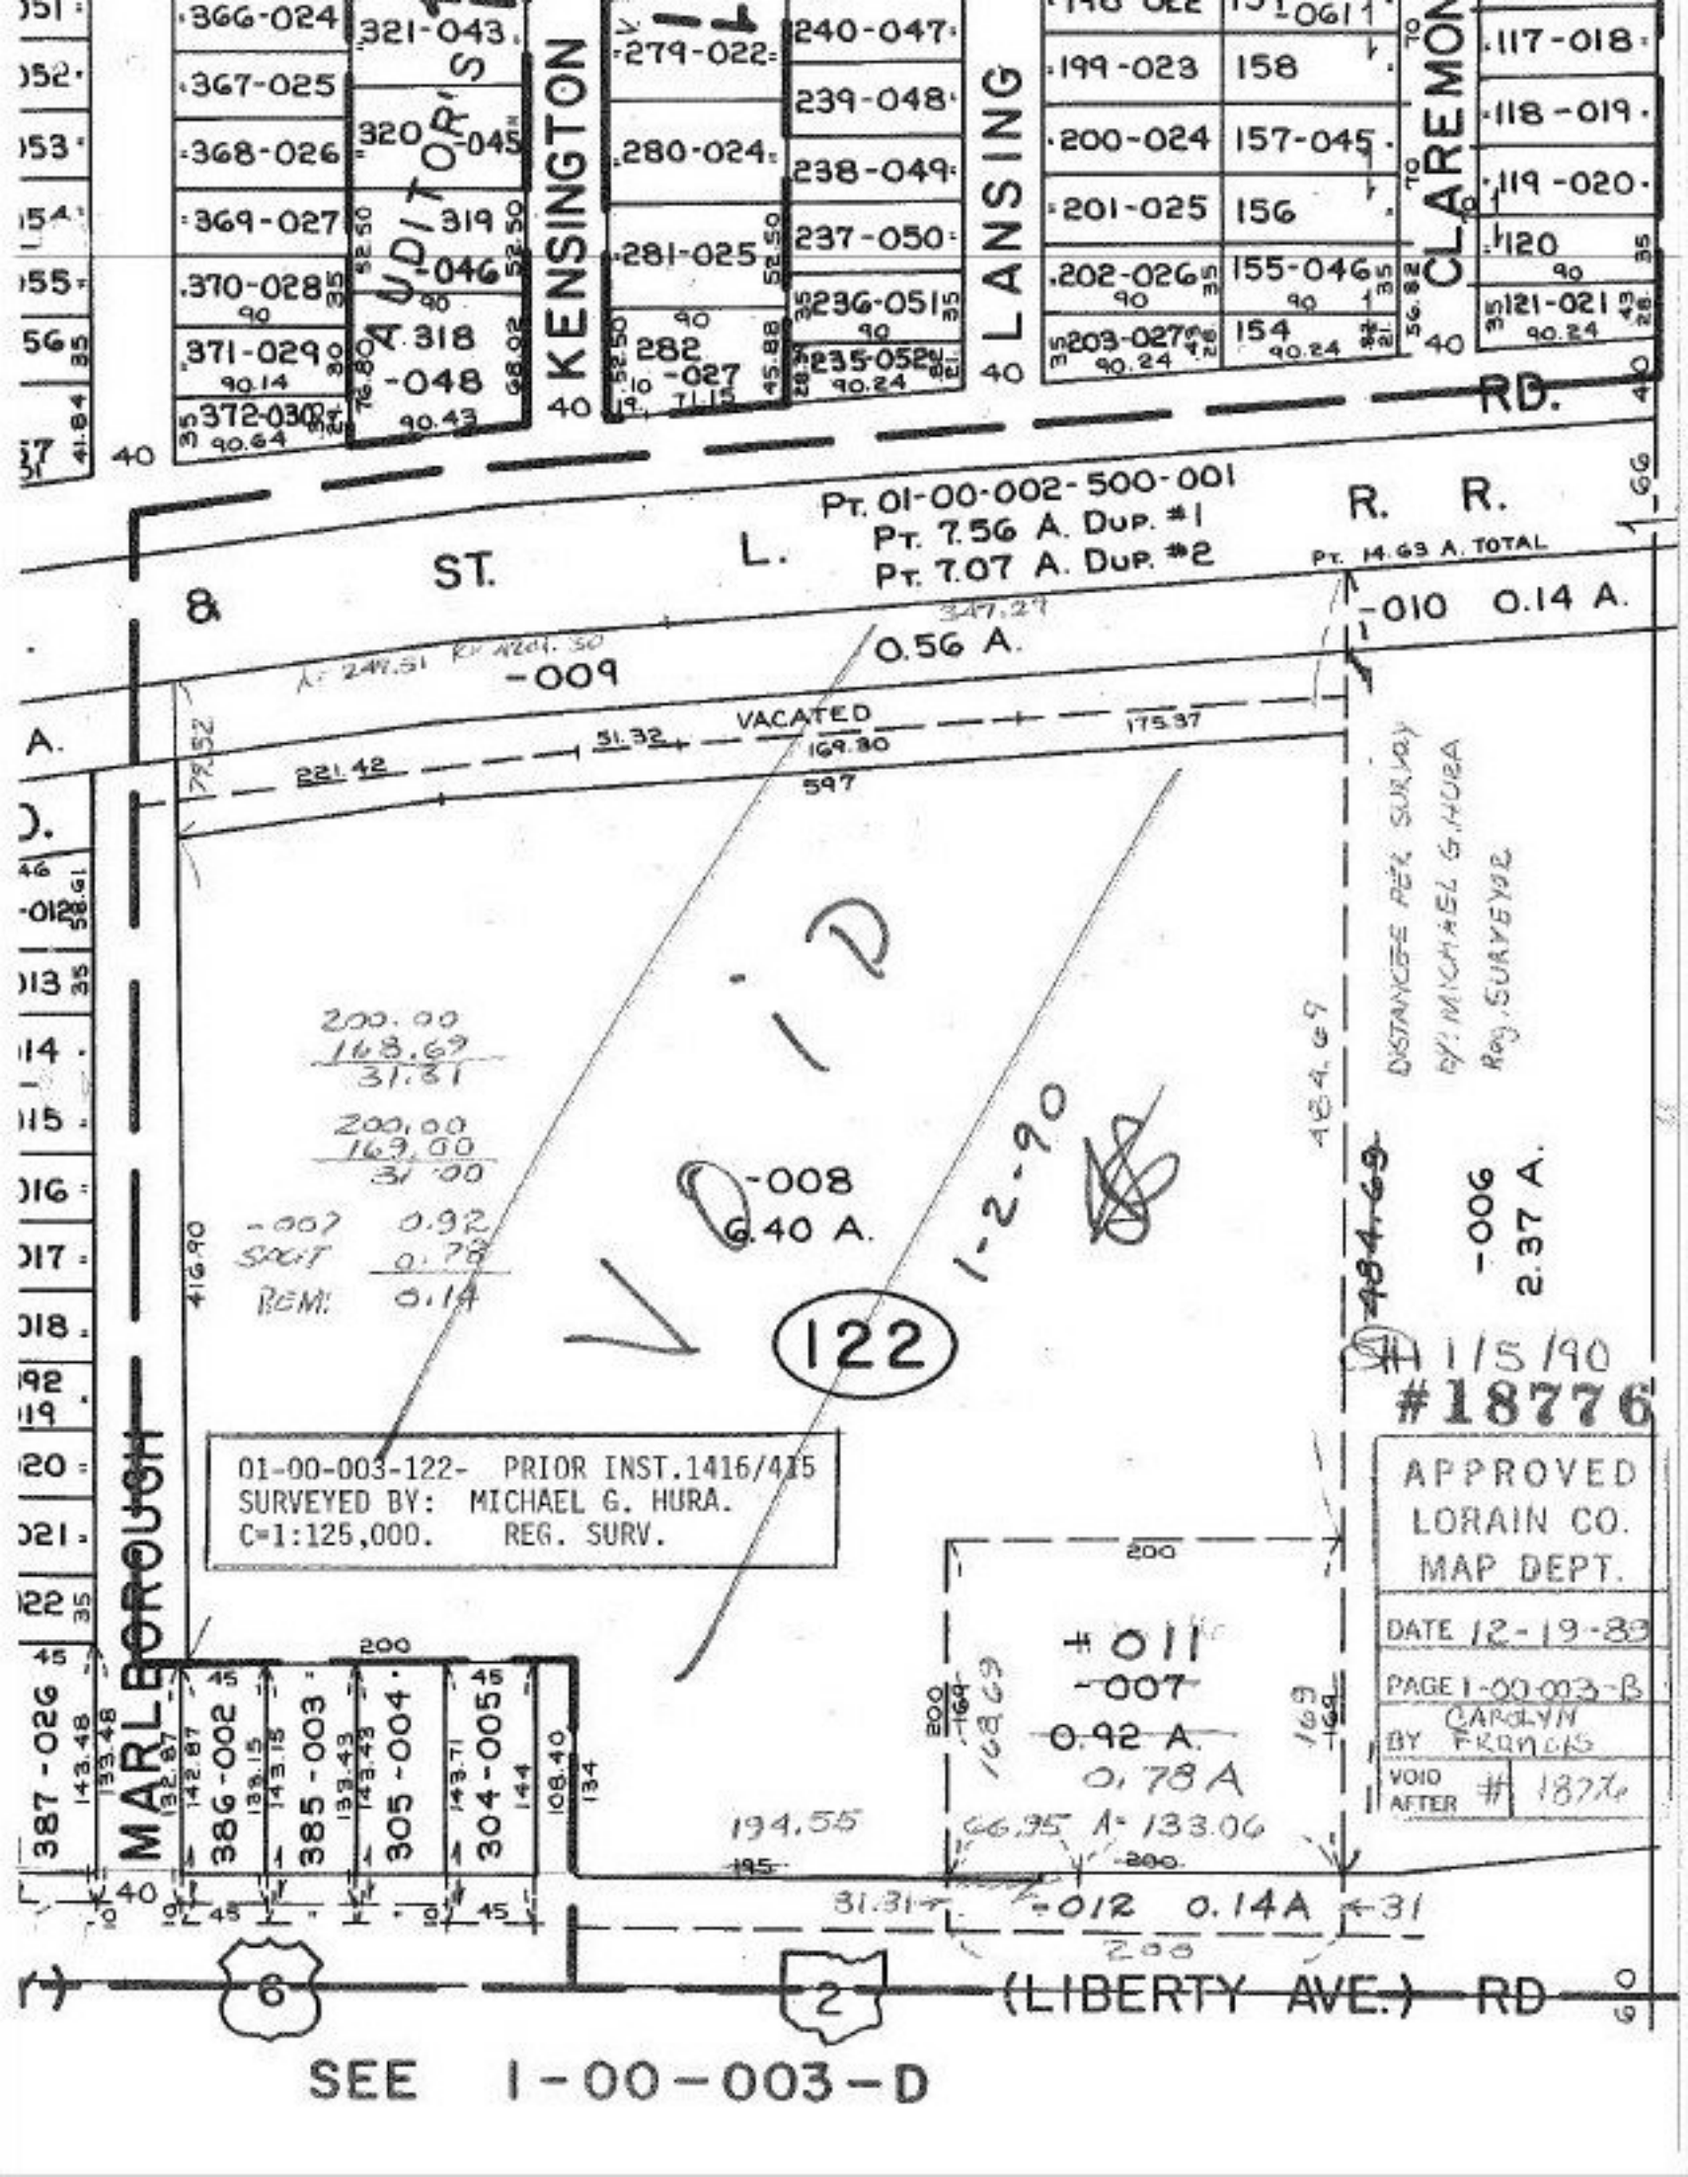
AUDITOR'S
KENSINGTON
LANSING
CLAREMONT
RD.
ST.
L.
R. R.
Pt. 01-00-002-500-001
Pt. 7.56 A. Dup. #1
Pt. 7.07 A. Dup. #2
Pt. 14.63 A. TOTAL
-009
0.56 A.
-010 0.14 A.
VACATED
-008
6.40 A.
-006
2.37 A.
122
MARLBOROUGH
01-00-003-122- PRIOR INST.1416/415
SURVEYED BY: MICHAEL G. HURA.
C=1:125,000. REG. SURV.
#18776
APPROVED
LORAIN CO.
MAP DEPT.
DATE 12-19-89
PAGE 1-00-003-B
BY CAROLYN FRANCIS
VOID AFTER # 18776
-011
-007
0.92 A.
0.78 A
-012 0.14A
(LIBERTY AVE.) RD
SEE 1-00-003-D