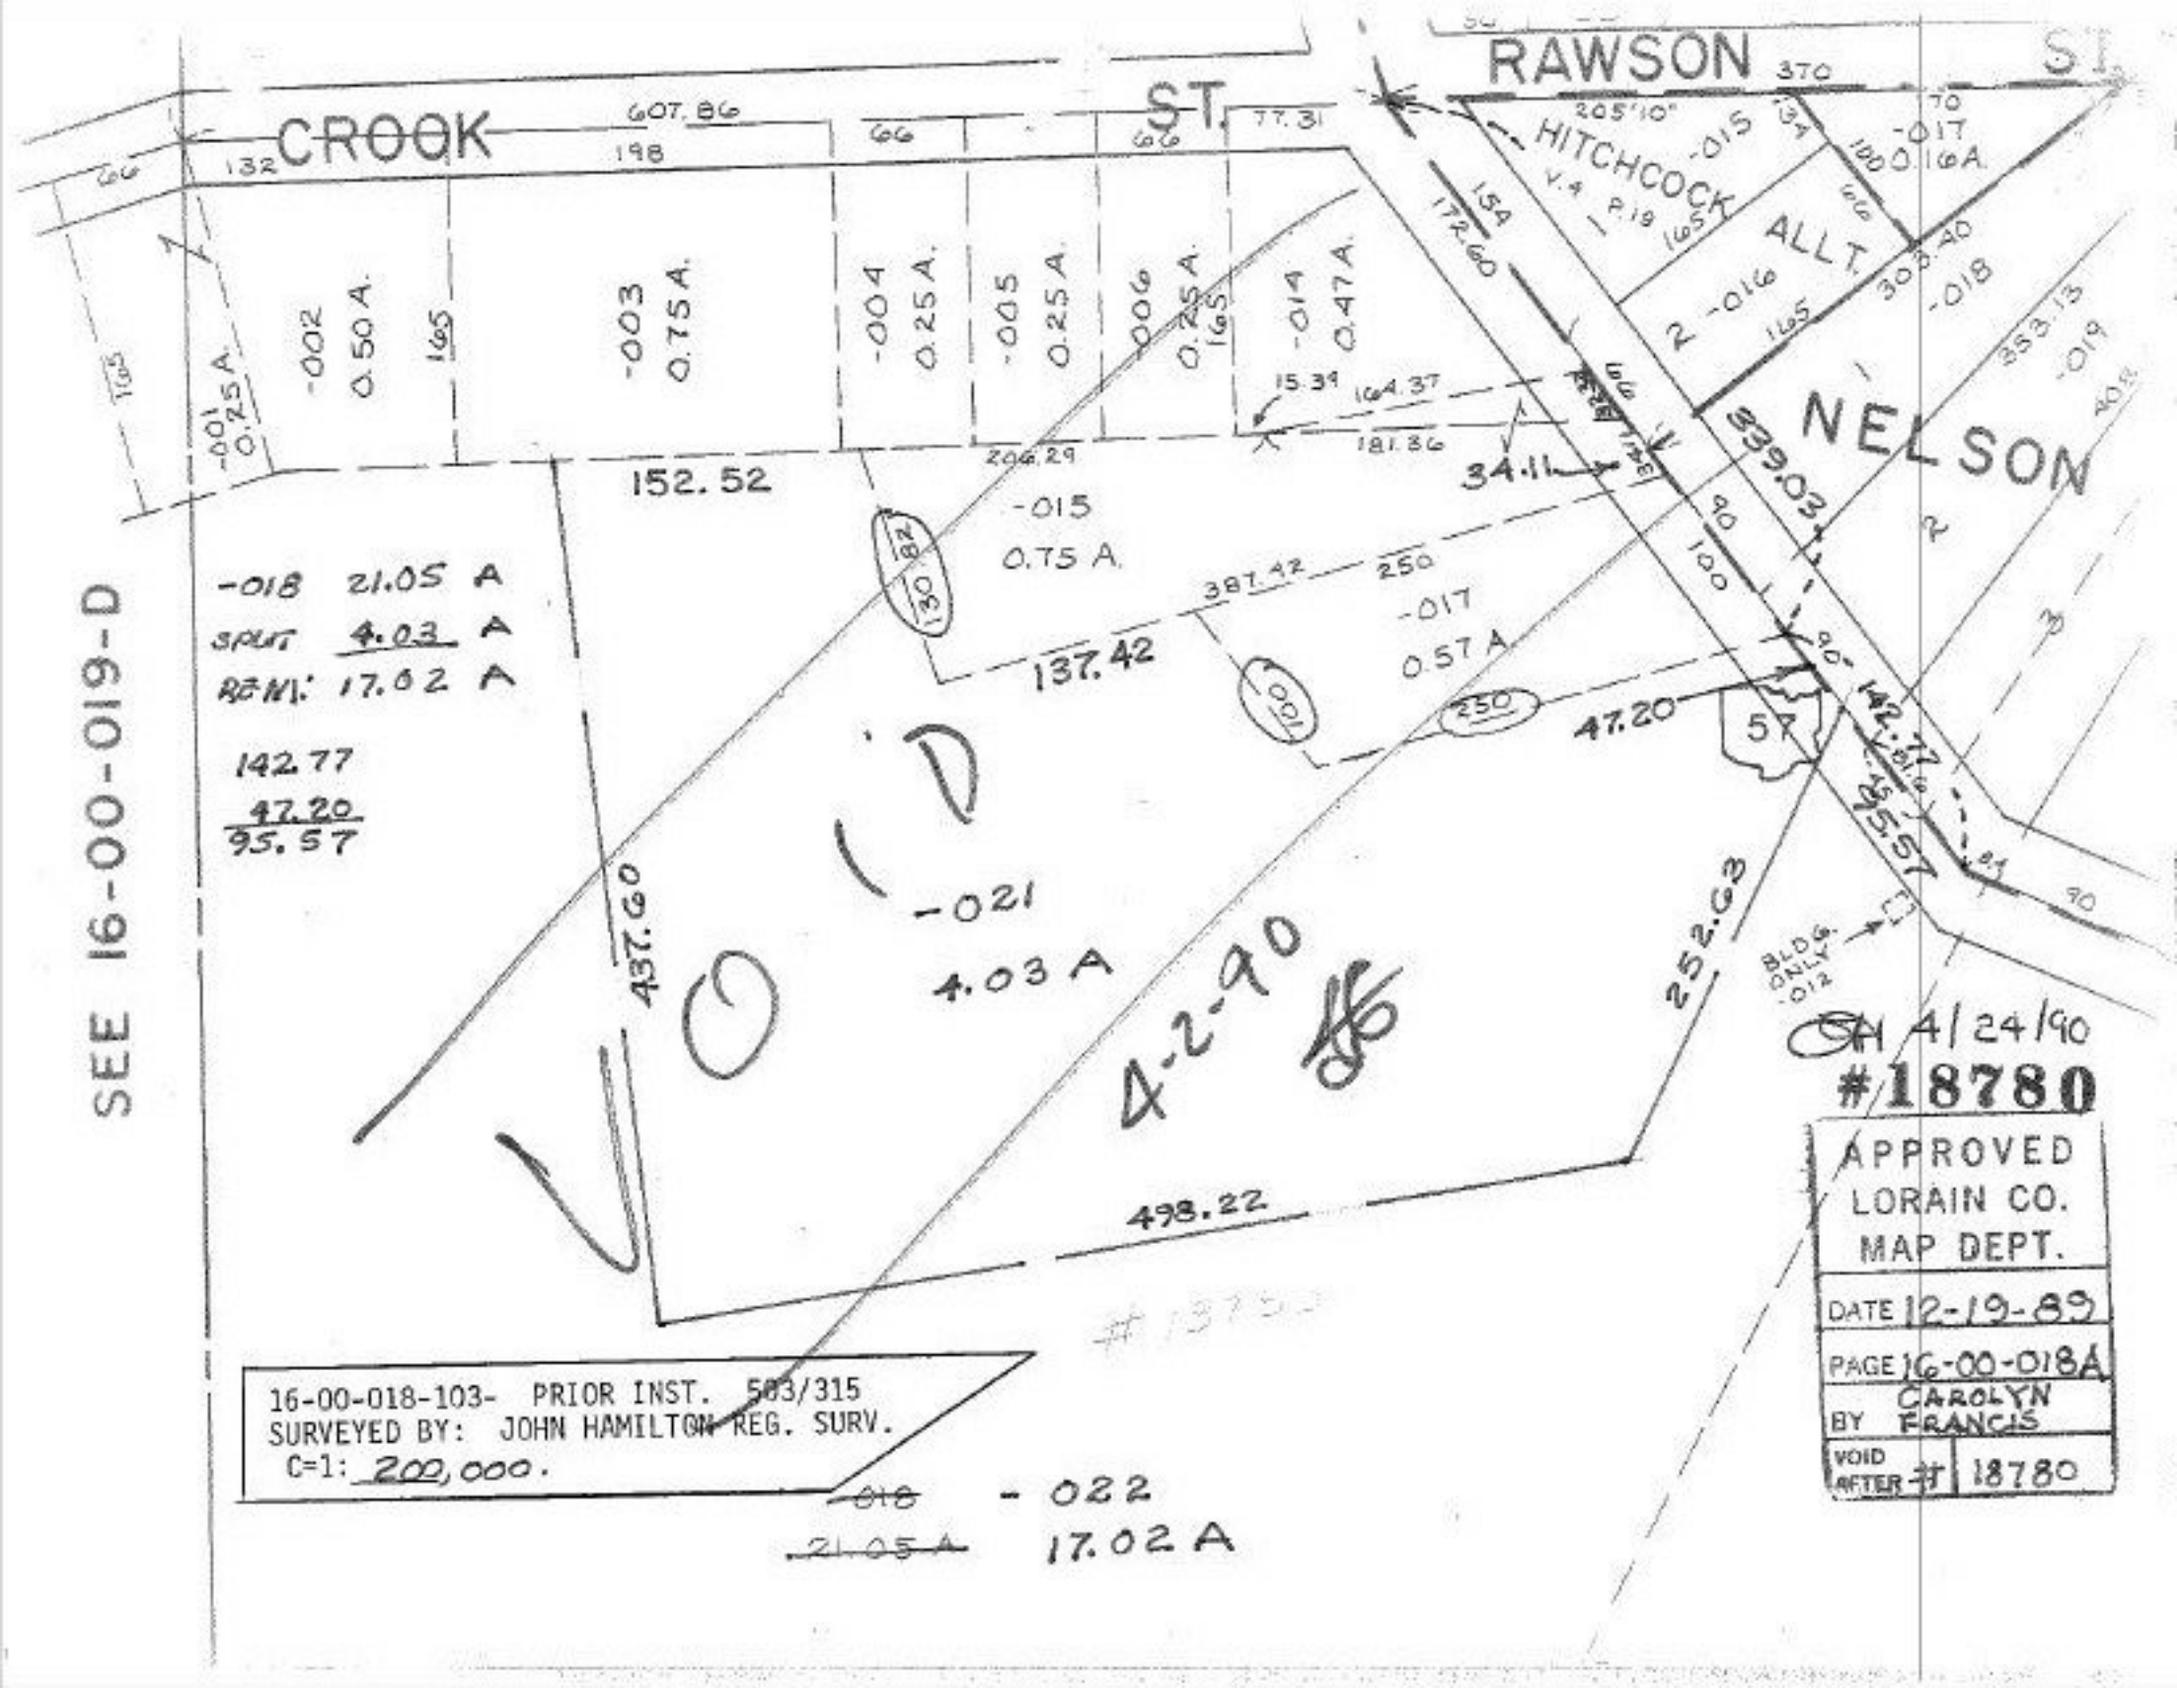
CROOK ST
RAWSON
HITCHCOCK
ALLT
NELSON
-001 0.25 A.
-002 0.50 A.
-003 0.75 A.
-004 0.25 A.
-005 0.25 A.
-006 0.25 A.
-014 0.47 A.
-015 0.75 A.
-017 0.57 A.
-018 21.05 A
SPLIT 4.03 A
REM: 17.02 A
142.77
47.20
95.57
-021 4.03 A
-022 17.02 A
VOID
4-2-90
SEE 16-00-019-D
16-00-018-103- PRIOR INST. 503/315
SURVEYED BY: JOHN HAMILTON REG. SURV.
C=1: 200,000.
APPROVED
LORAIN CO.
MAP DEPT.
DATE 12-19-89
PAGE 16-00-018A
BY CAROLYN FRANCIS
VOID AFTER 4/24/90
#18780