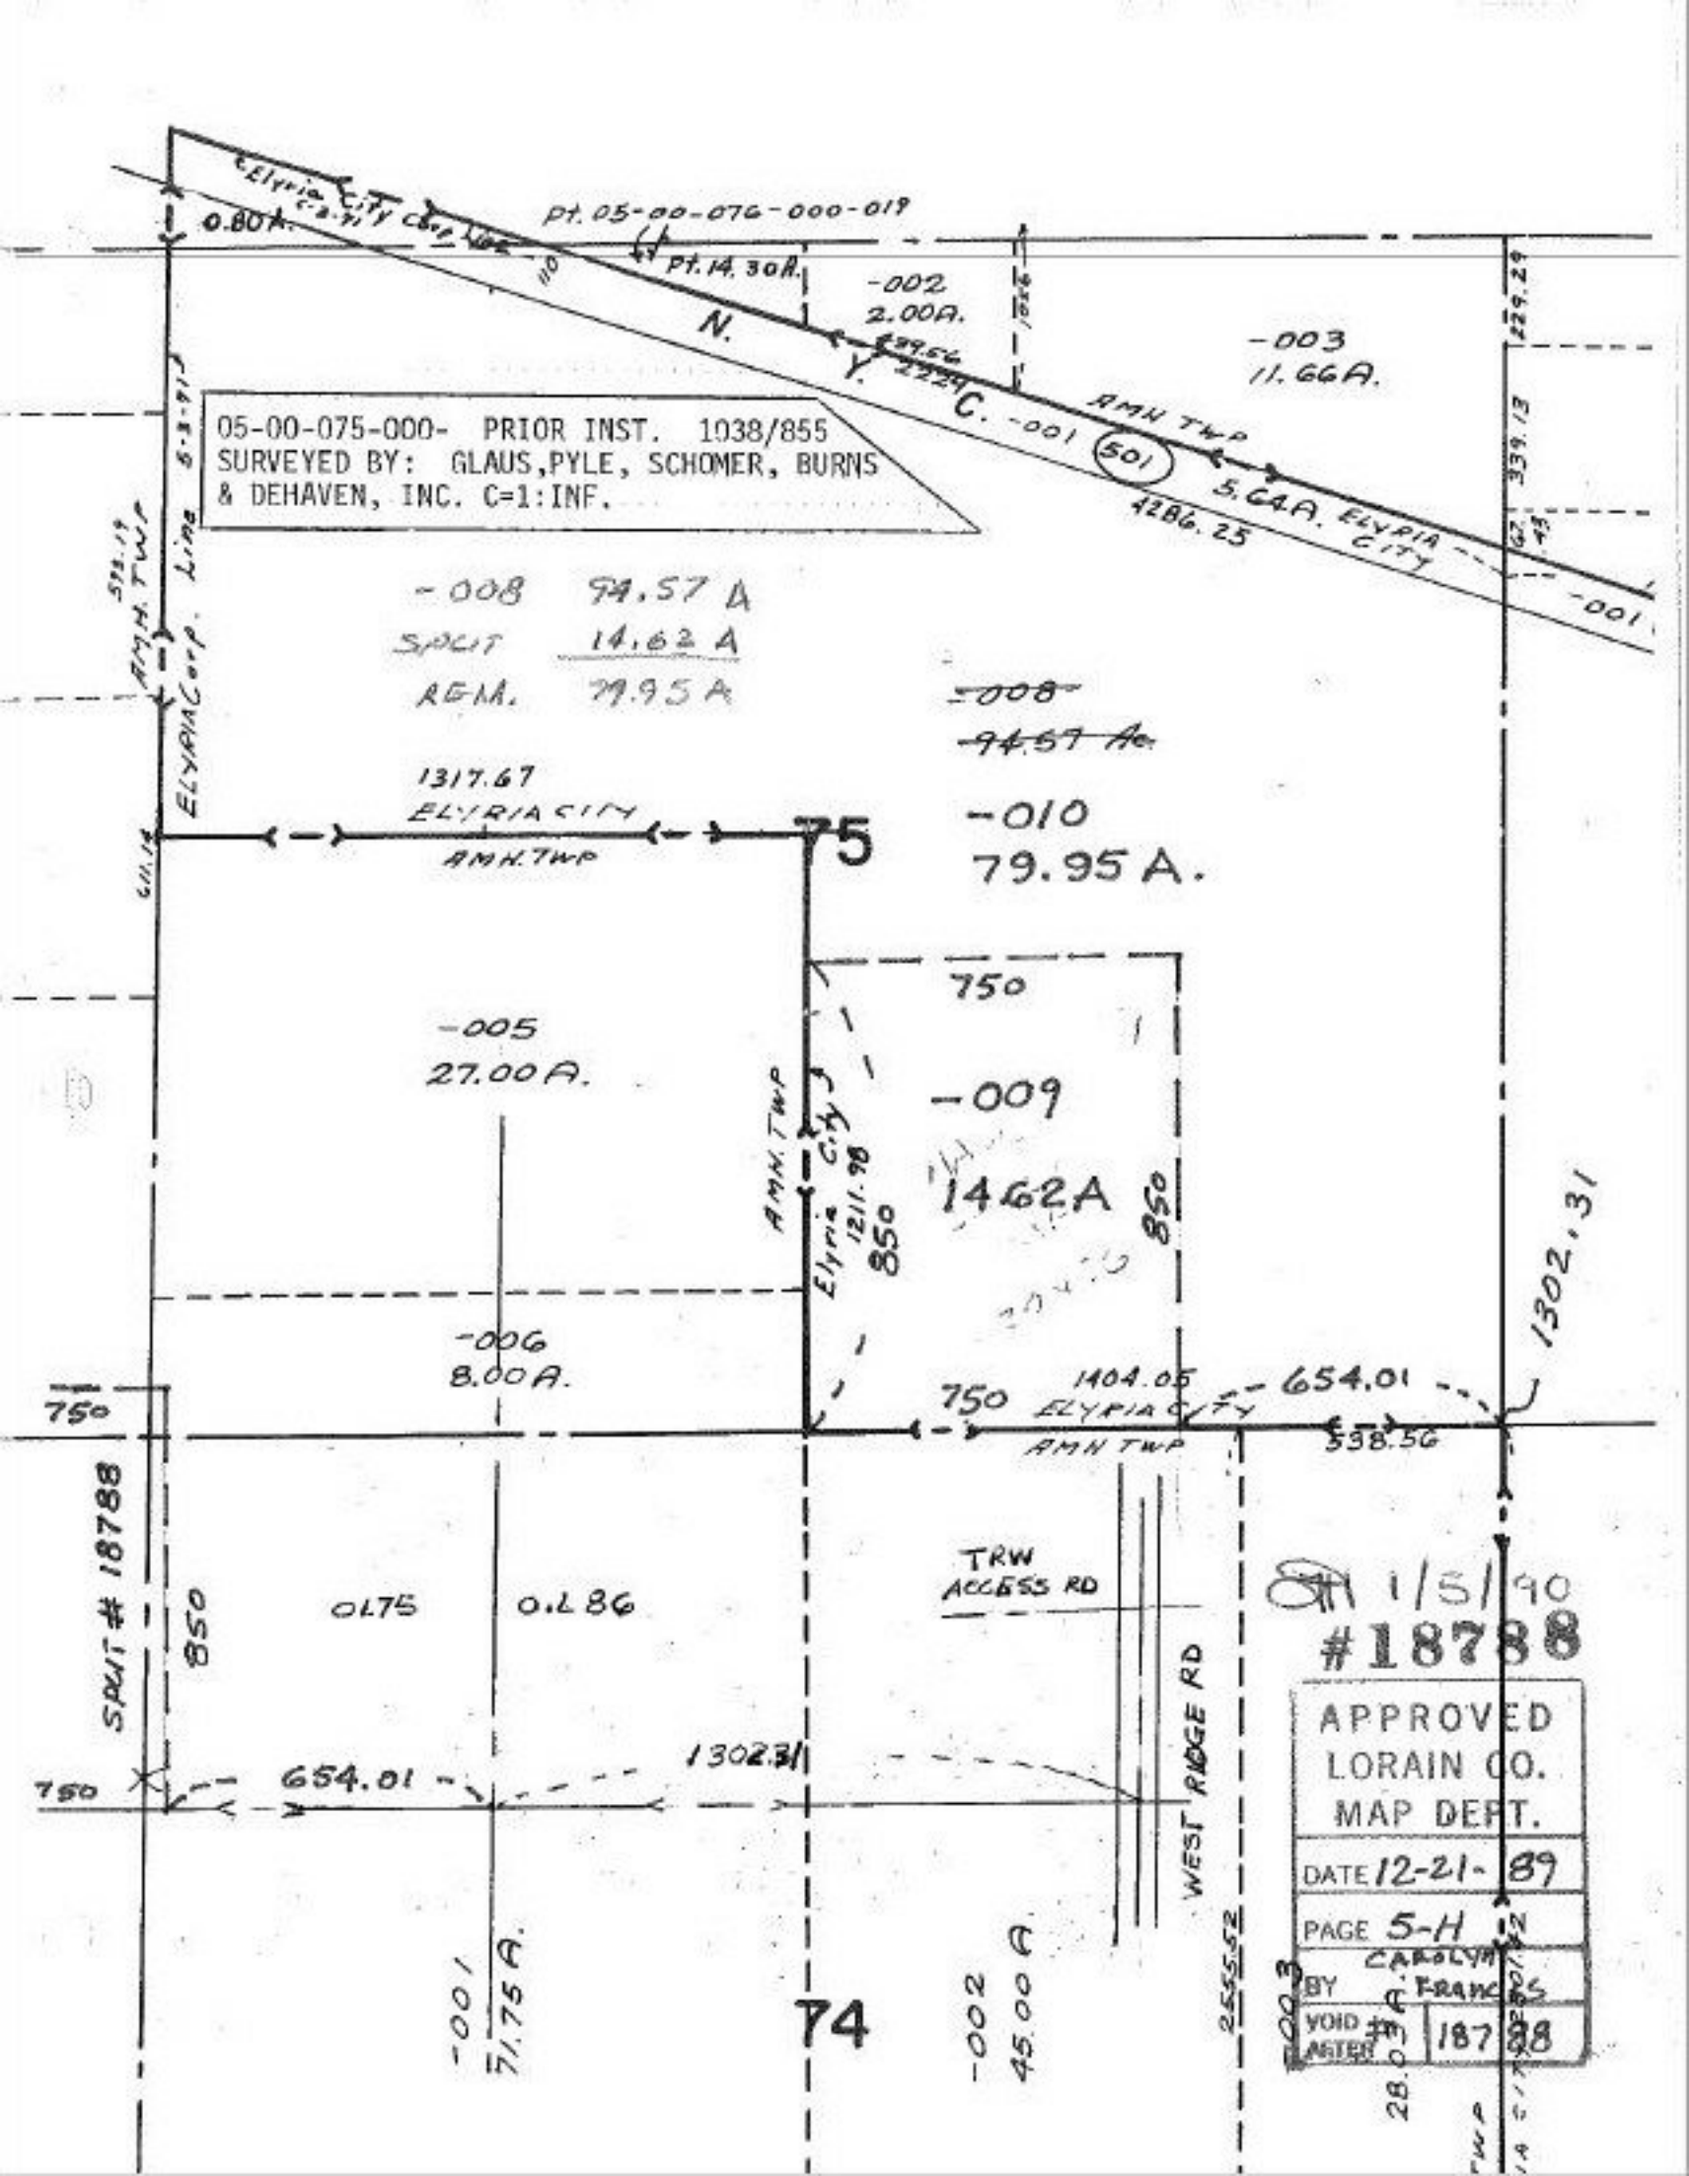

05-00-075-000- PRIOR INST. 1038/855
SURVEYED BY: GLAUS,PYLE, SCHOMER, BURNS
& DEHAVEN, INC. C=1:INF.
Elyria City Corp. Line
0.80A.
Pt. 05-00-076-000-019
Pt. 14.30A.
-002
2.00A.
-003
11.66A.
N.
Y.
C.
-001
501
AMH TWP
5.64A.
ELYRIA CITY
4286.25
229.29
339.13
-008 94.57 A
SPLIT 14.62 A
REM. 79.95 A
~~-008~~
~~94.57 Ac.~~
1317.67
ELYRIA CITY
AMH. TWP
75
-010
79.95 A.
750
-005
27.00 A.
-009
14.62A
AMH. TWP
Elyria City
1211.98
850
850
1302.31
-006
8.00 A.
750
1404.05
ELYRIA CITY
AMH TWP
654.01
538.56
750
SPLIT # 18788
850
0.L75
0.L86
TRW
ACCESS RD
WEST RIDGE RD
1302.31
750
654.01
-001
71.75 A.
74
-002
45.00 A.
2555.52
-003
28.03 A.
1/5/90
#18788
APPROVED
LORAIN CO.
MAP DEPT.
DATE 12-21-89
PAGE 5-H
BY CAROLYN FRANCIS
VOID AFTER #
18788