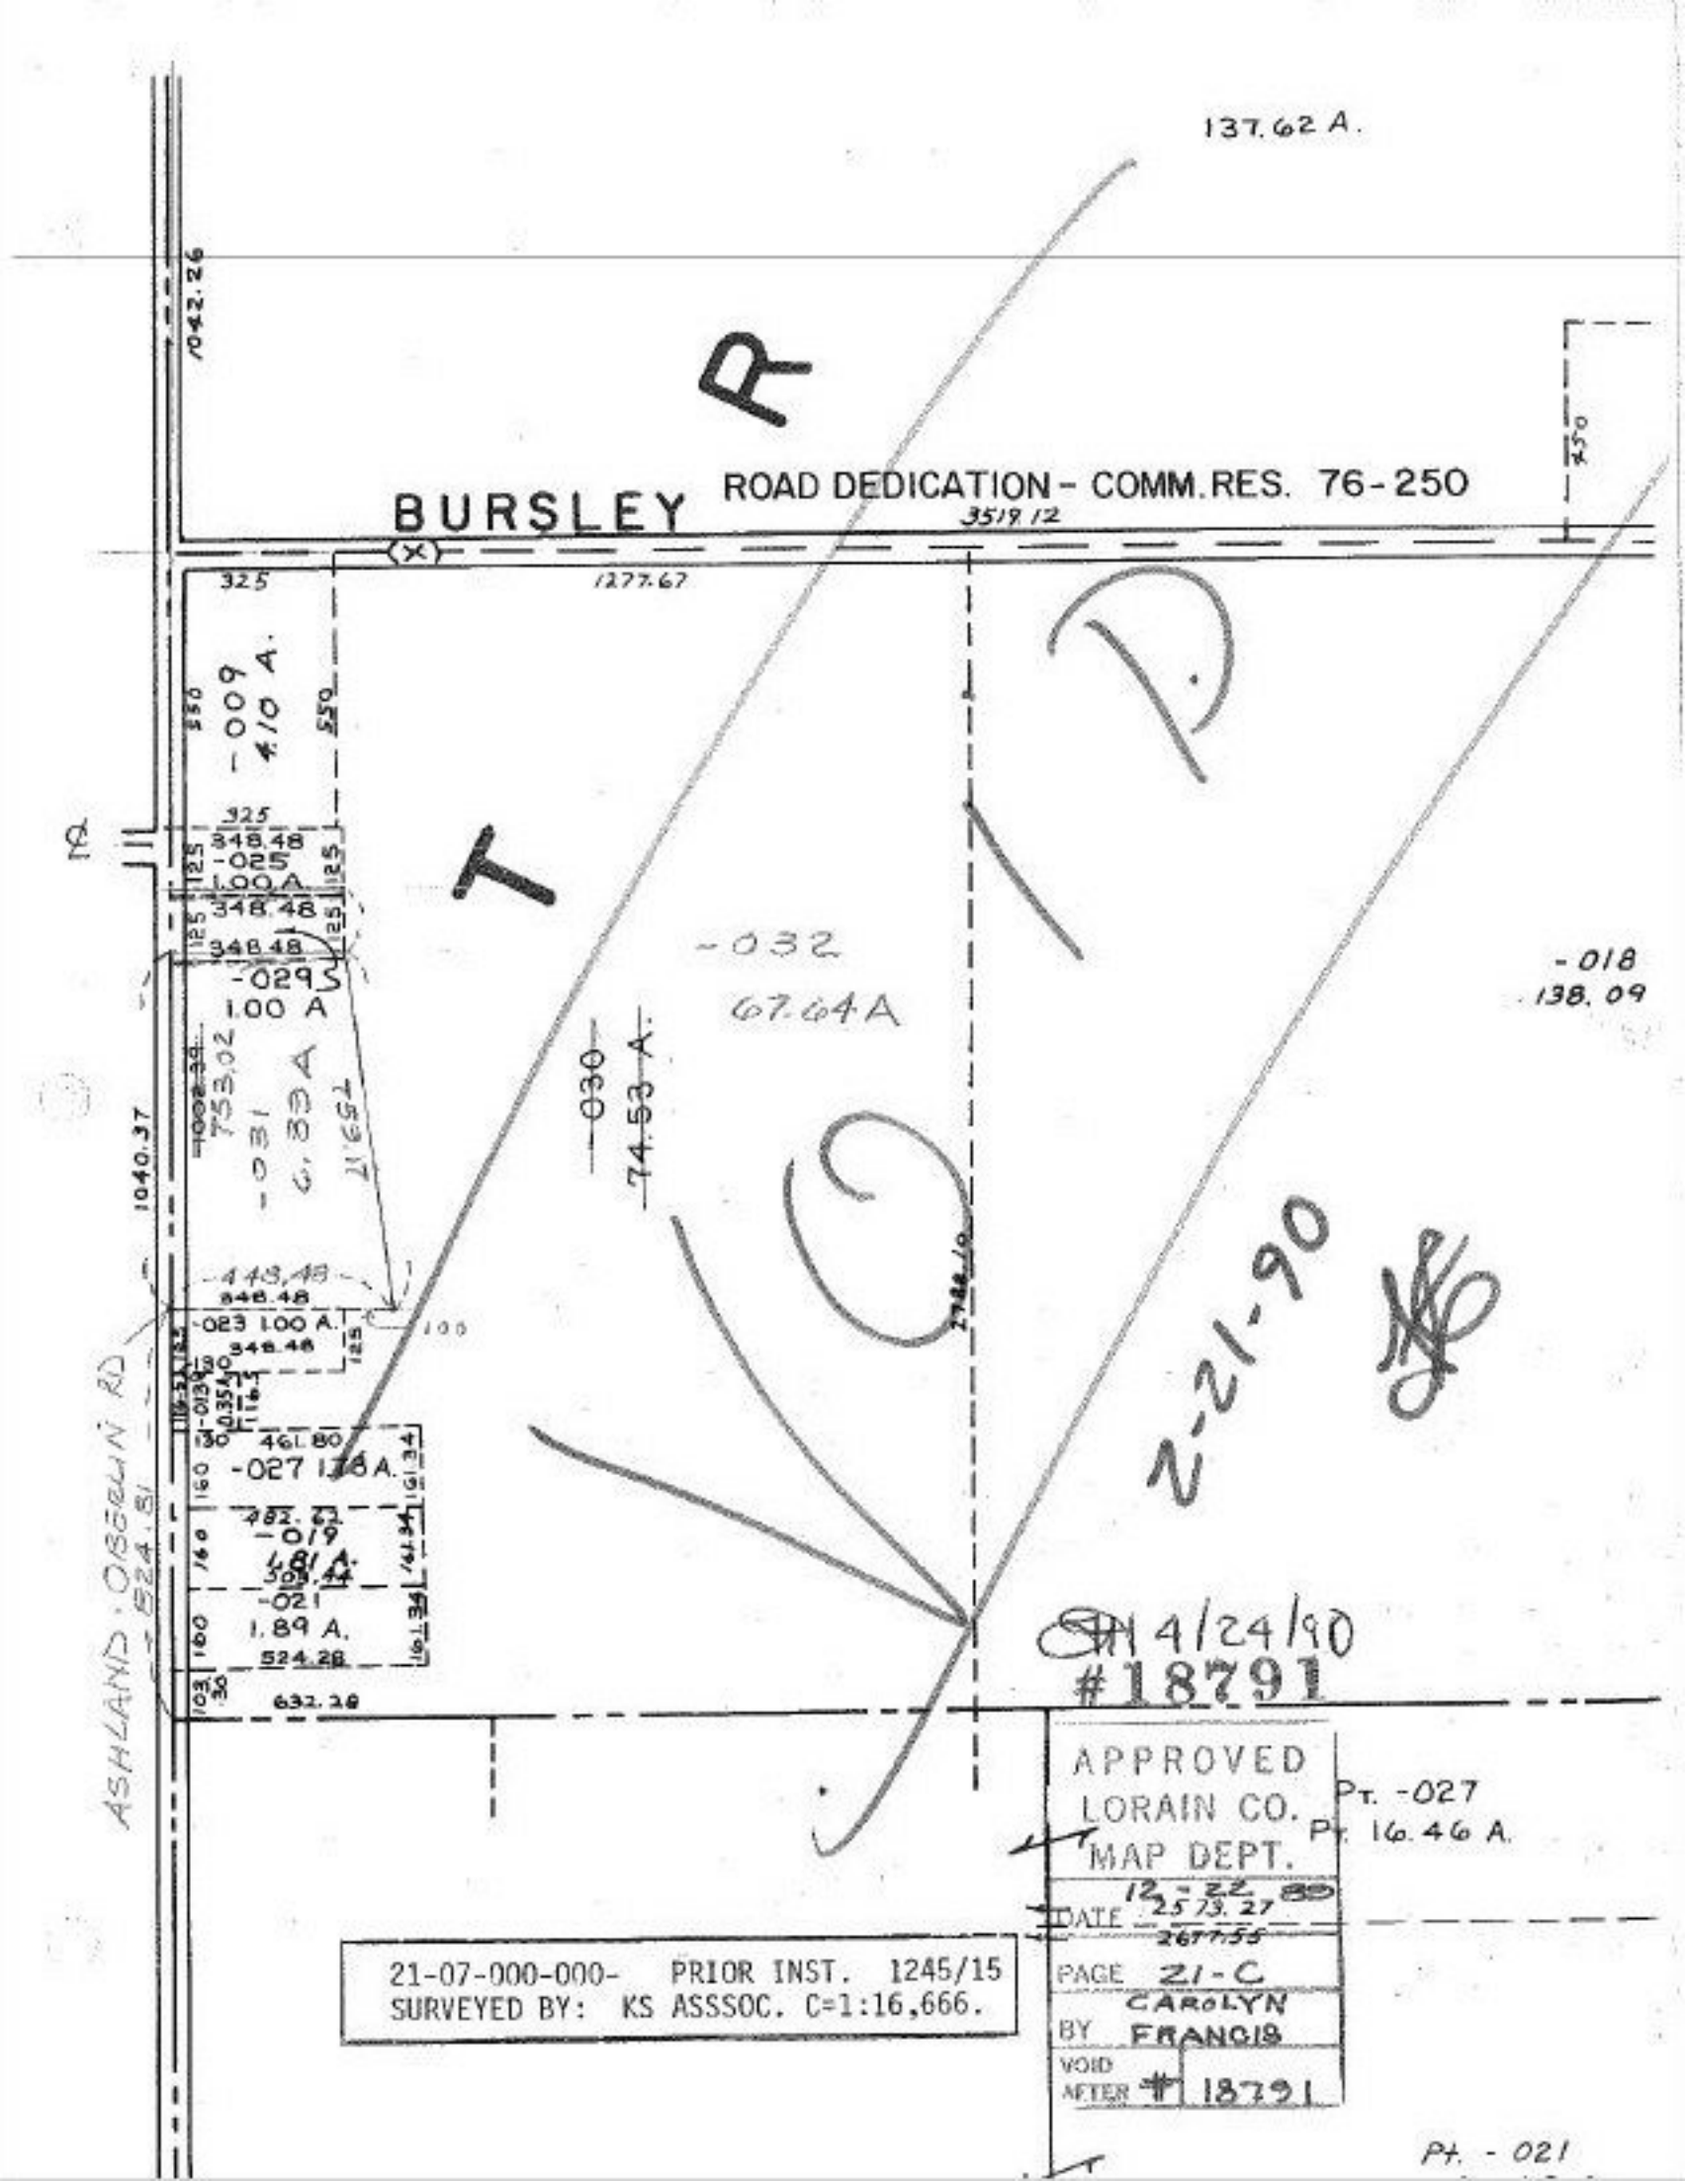
137.62 A.
1042.26
BURSLEY
ROAD DEDICATION - COMM. RES. 76-250
3519.12
1277.67
750
325
-009
4.10 A.
550
325
348.48
-025
1.00 A.
125
348.48
348.48
-029
1.00 A
753.02
-031
6.33 A
1165.1
1040.37
-032
67.64 A
-030
74.53 A.
-018
138.09
2788.10
348.48
348.48
-023 1.00 A.
125
100
461.80
-027 1.76 A.
160
482.27
-019
4.81 A.
160
524.28
-021
1.89 A.
160
524.28
632.28
ASHLAND-OBERLIN RD.
524.81
T.
R.
2-21-90
4/24/90
#18791
APPROVED
LORAIN CO.
MAP DEPT.
DATE 12-22-89
PAGE 21-C
BY CAROLYN FRANCIS
VOID AFTER # 18791
Pt. -027
Pt. 16.46 A.
Pt. - 021
21-07-000-000- PRIOR INST. 1245/15
SURVEYED BY: KS ASSSOC. C=1:16,666.