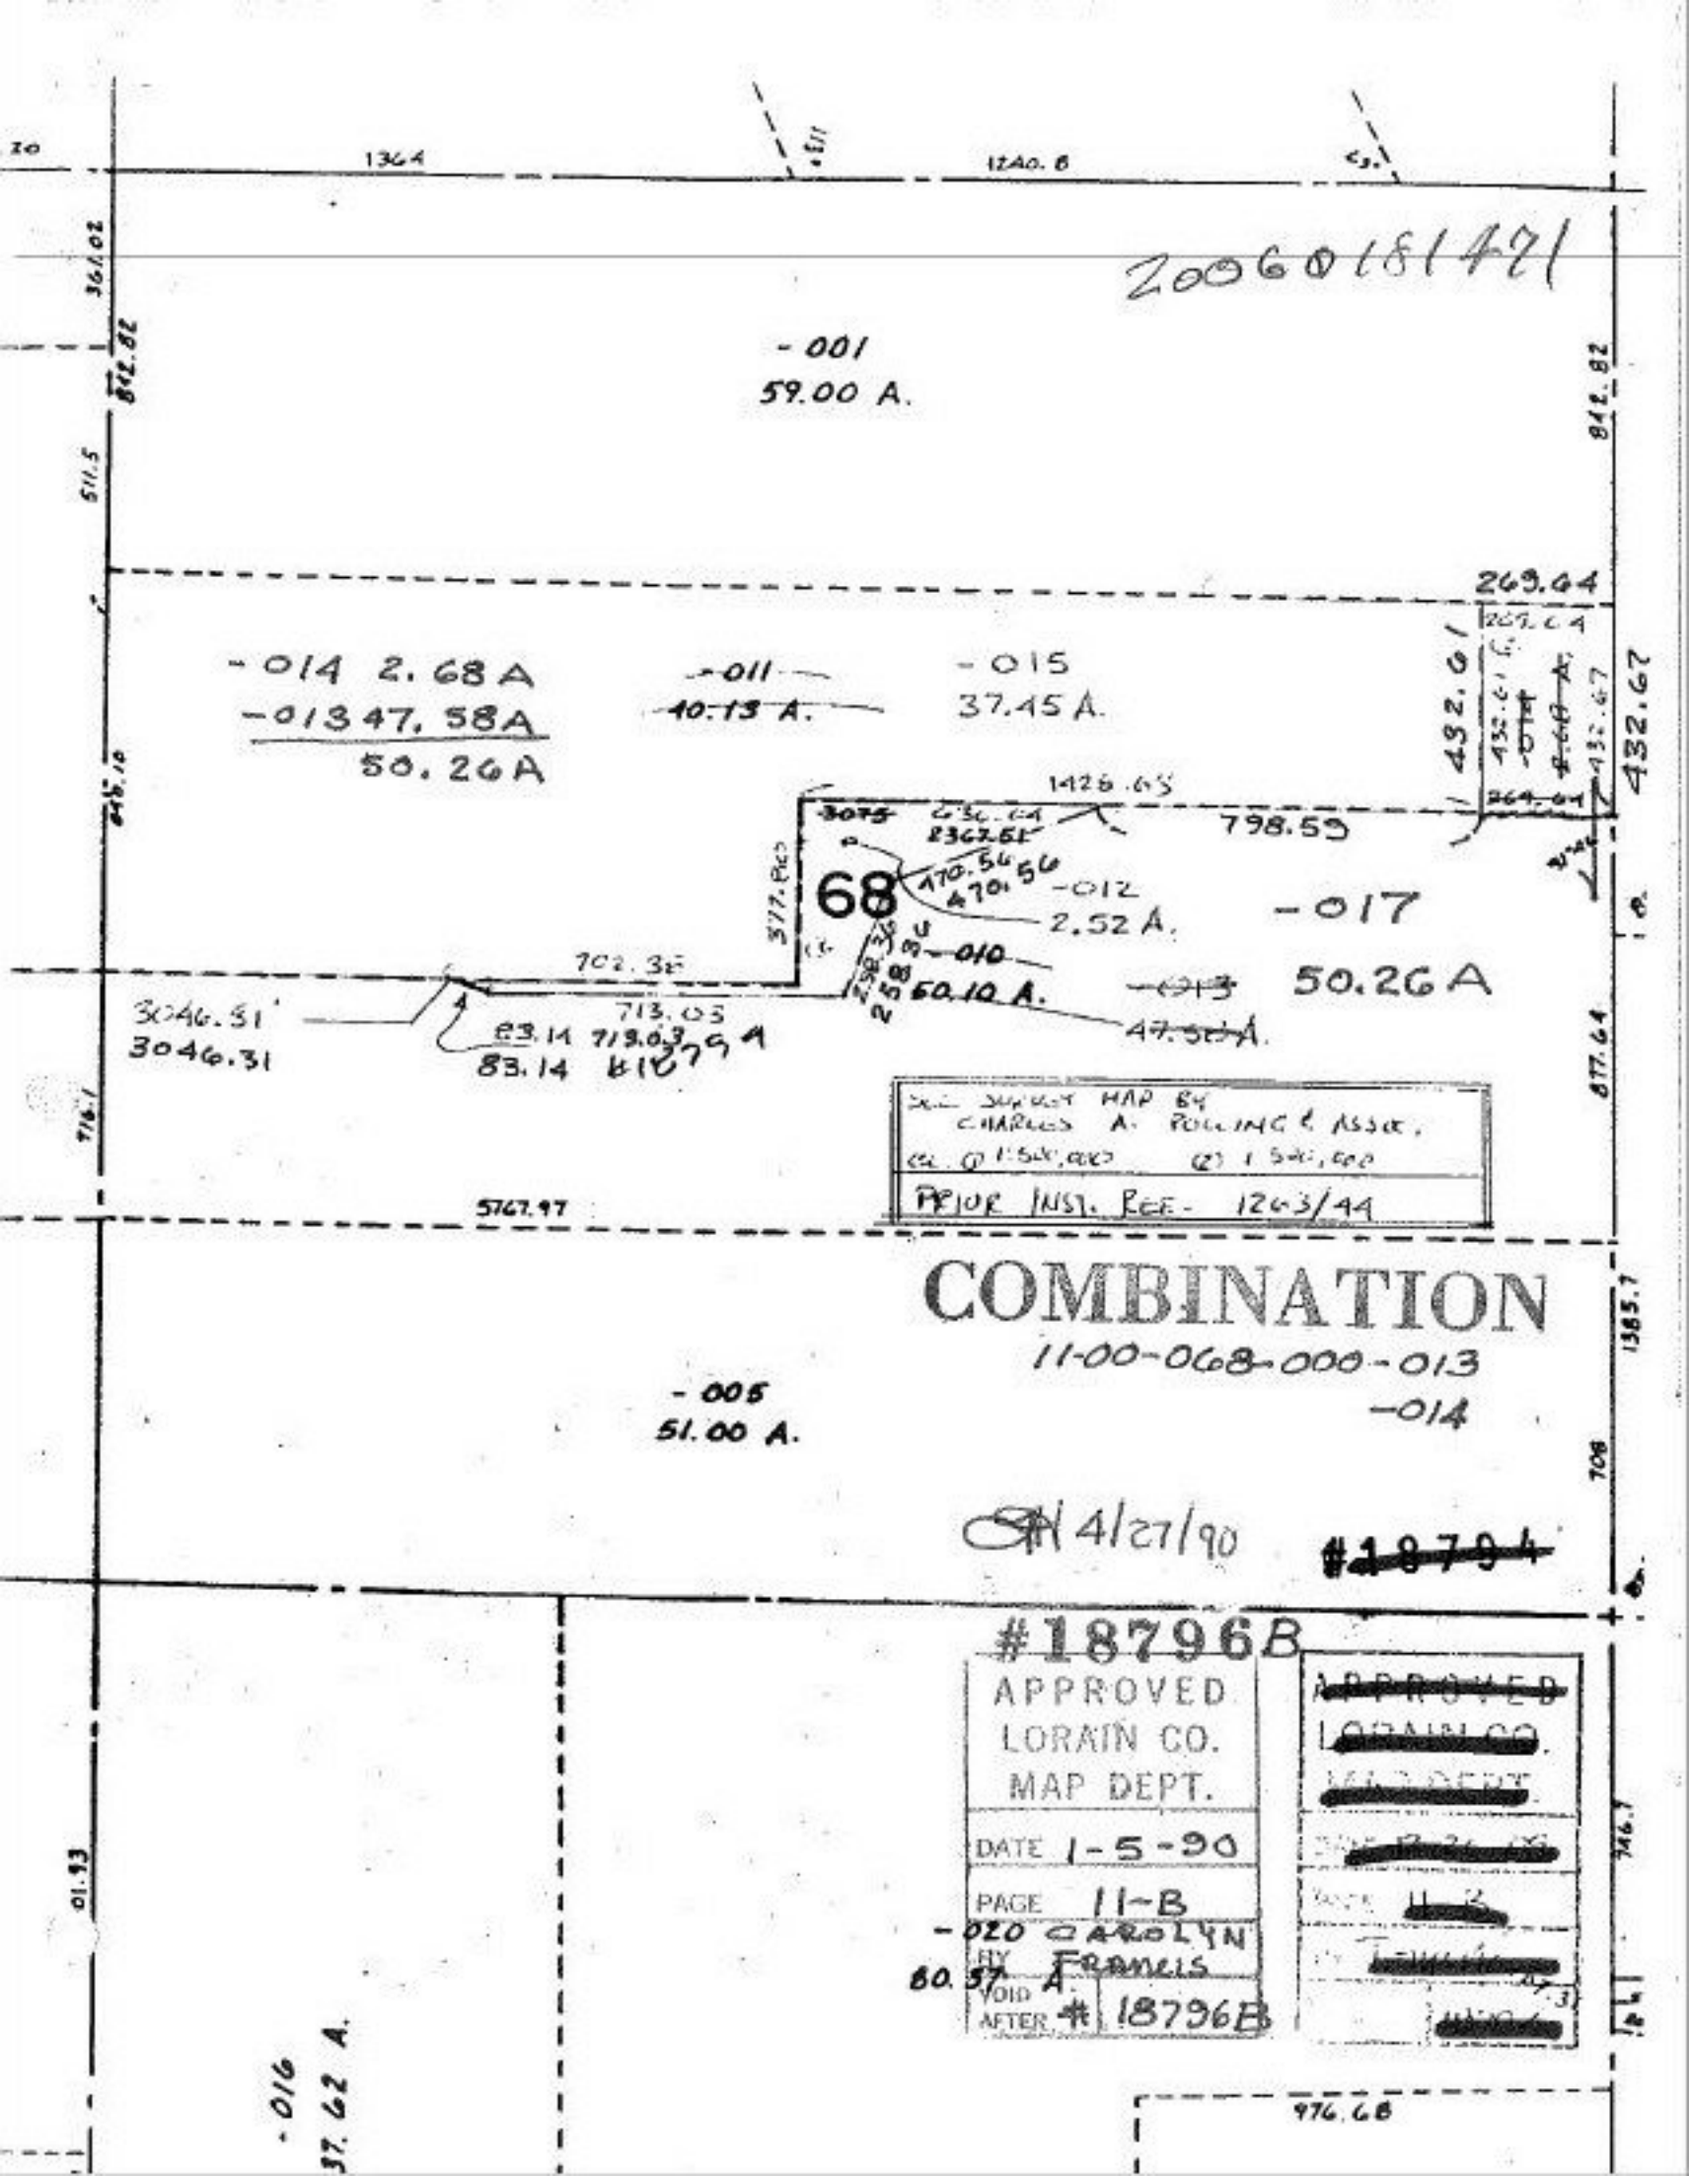
200601814 71
-001
59.00 A.
-014 2.68 A
-013 47.58 A
50.26 A
-011
10.13 A.
-015
37.45 A.
68
-012
2.52 A.
-017
50.26 A
-010
50.10 A.
-013
47.58 A.
COMBINATION
11-00-068-000-013
-014
-005
51.00 A.
4/27/90
#18794
#18796B
APPROVED
LORAIN CO.
MAP DEPT.
DATE 1-5-90
PAGE 11-B
-020 CAROLYN
FRANCIS
60.57 A.
VOID AFTER # 18796B
-016
37.62 A.
SURVEY MAP BY
CHARLES A. POLLING & ASSOC.
PRIOR INST. REF. 1263/44